


662-C0204

11111111 01701

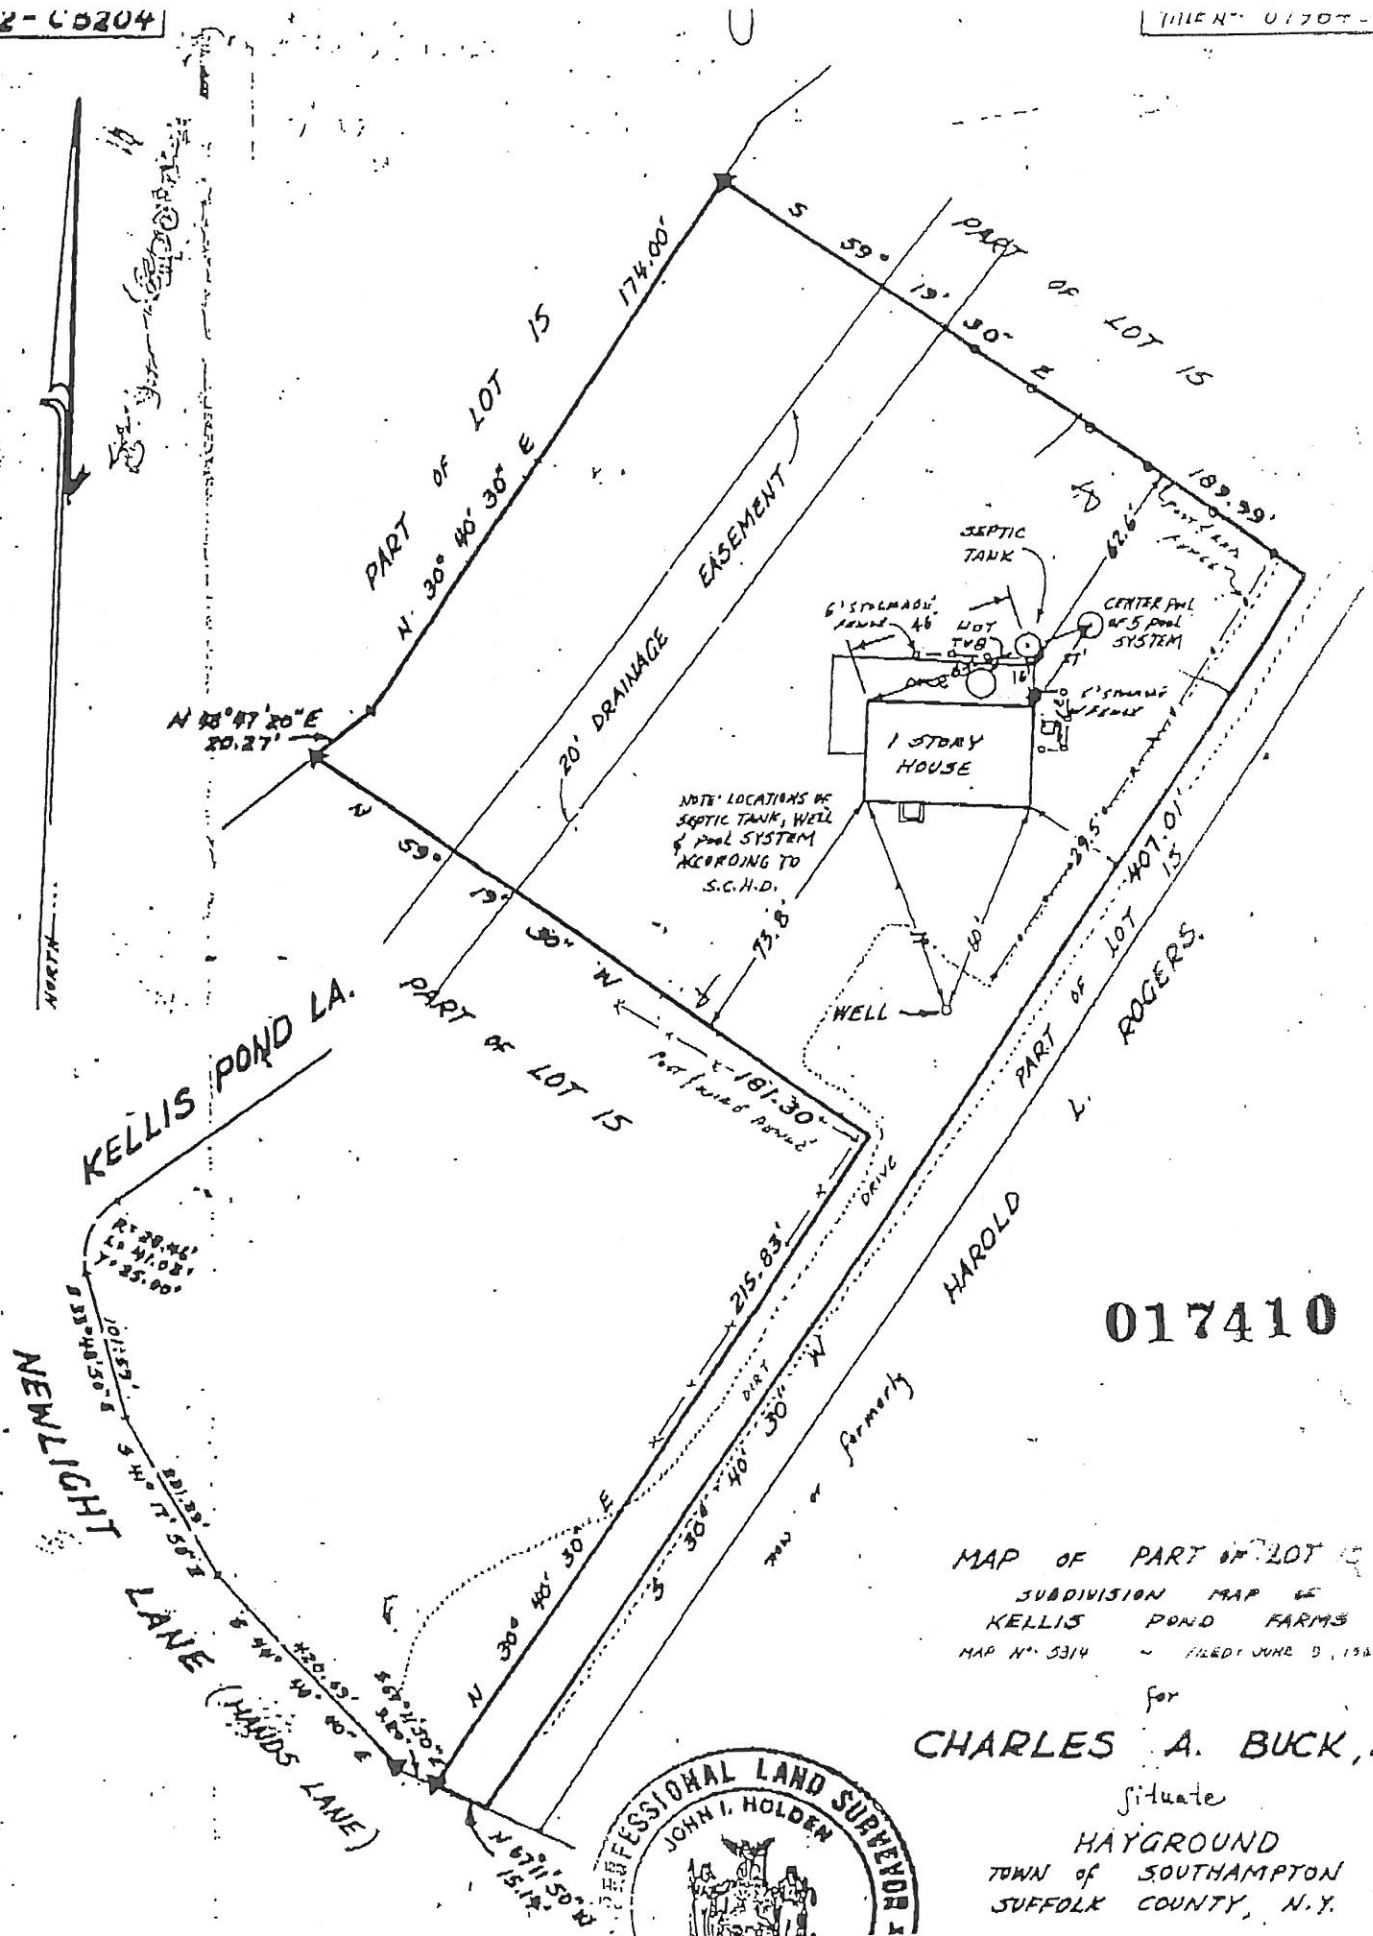

017410

MAP OF PART OF LOT 15
SUBDIVISION MAP OF
KELLIS POND FARMS
MAP N° 5314 - FILED JUNE 9, 1989

for
CHARLES A. BUCK, JR
situate
HAYGROUND
TOWN OF SOUTHAMPTON
SUFFOLK COUNTY, N.Y.

