

7366-A6344

R-7.5

4/10's

Lot size = 24886

Total side = 48

Min side = 20

Acc Bldg = 15

Poolhouse = 15



GFA = 3988


Lot cov = 4984

SUFFOLK COUNTY TAX MAP

DISTRICT: 0904
SECTION: 008.00
BLOCK: 02.00
PARCEL: 032.000

SURVEYED: JUNE 5, 1986

LESTER HOLDEN L.S. No. 49548
SQUIRES, HOLDEN, WEISENBACHER & SMITH
LAND SURVEYORS - ENGINEERS
SOUTHAMPTON N.Y.

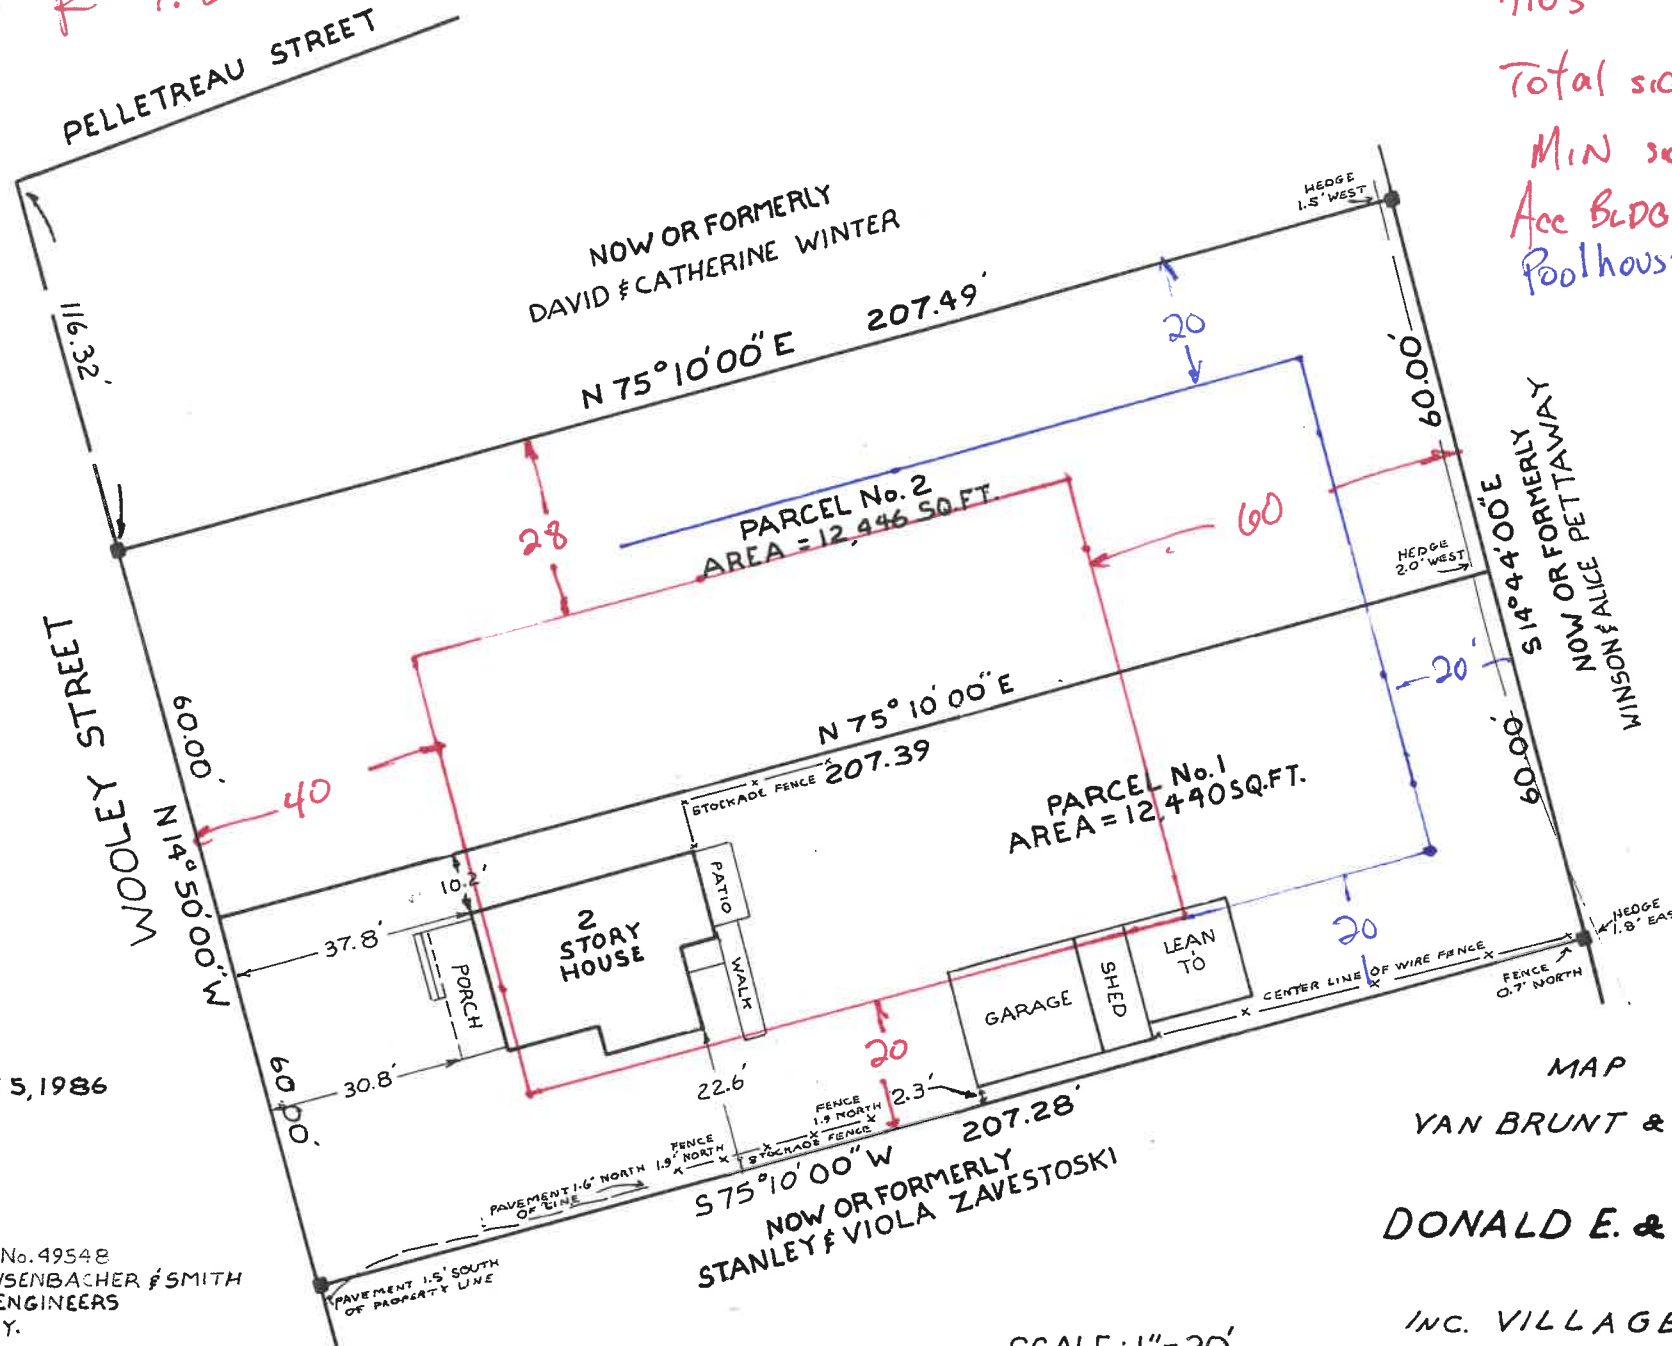

BOOK - PAGE
204 101
459 136

SCALE: 1" = 30'

■ INDICATES MONUMENT

MAP OF LOTS, 28 & 29

VAN BRUNT & GOODALE - SUB-DIVISION

FOR

DONALD E. & BARBARA H. FANNING

SITUATE

INC. VILLAGE OF SOUTHAMPTON
SUFFOLK COUNTY N.Y.

BUILDING ZONE = R-7.5