


Tax Map No. 904-03-03-55  
Area 1.917 S.F.  
Zone R 12.5

Refer to Documents Recorded in  
Suffolk County Clerk's Office  
Filed Map No. 3107  
Filed July 12, 1960

FD Ward L Halsey Subd.  
Map No. 7422 Filed OCT. 22, 1919  
N 1/4 R. De Pierro  
88.06'

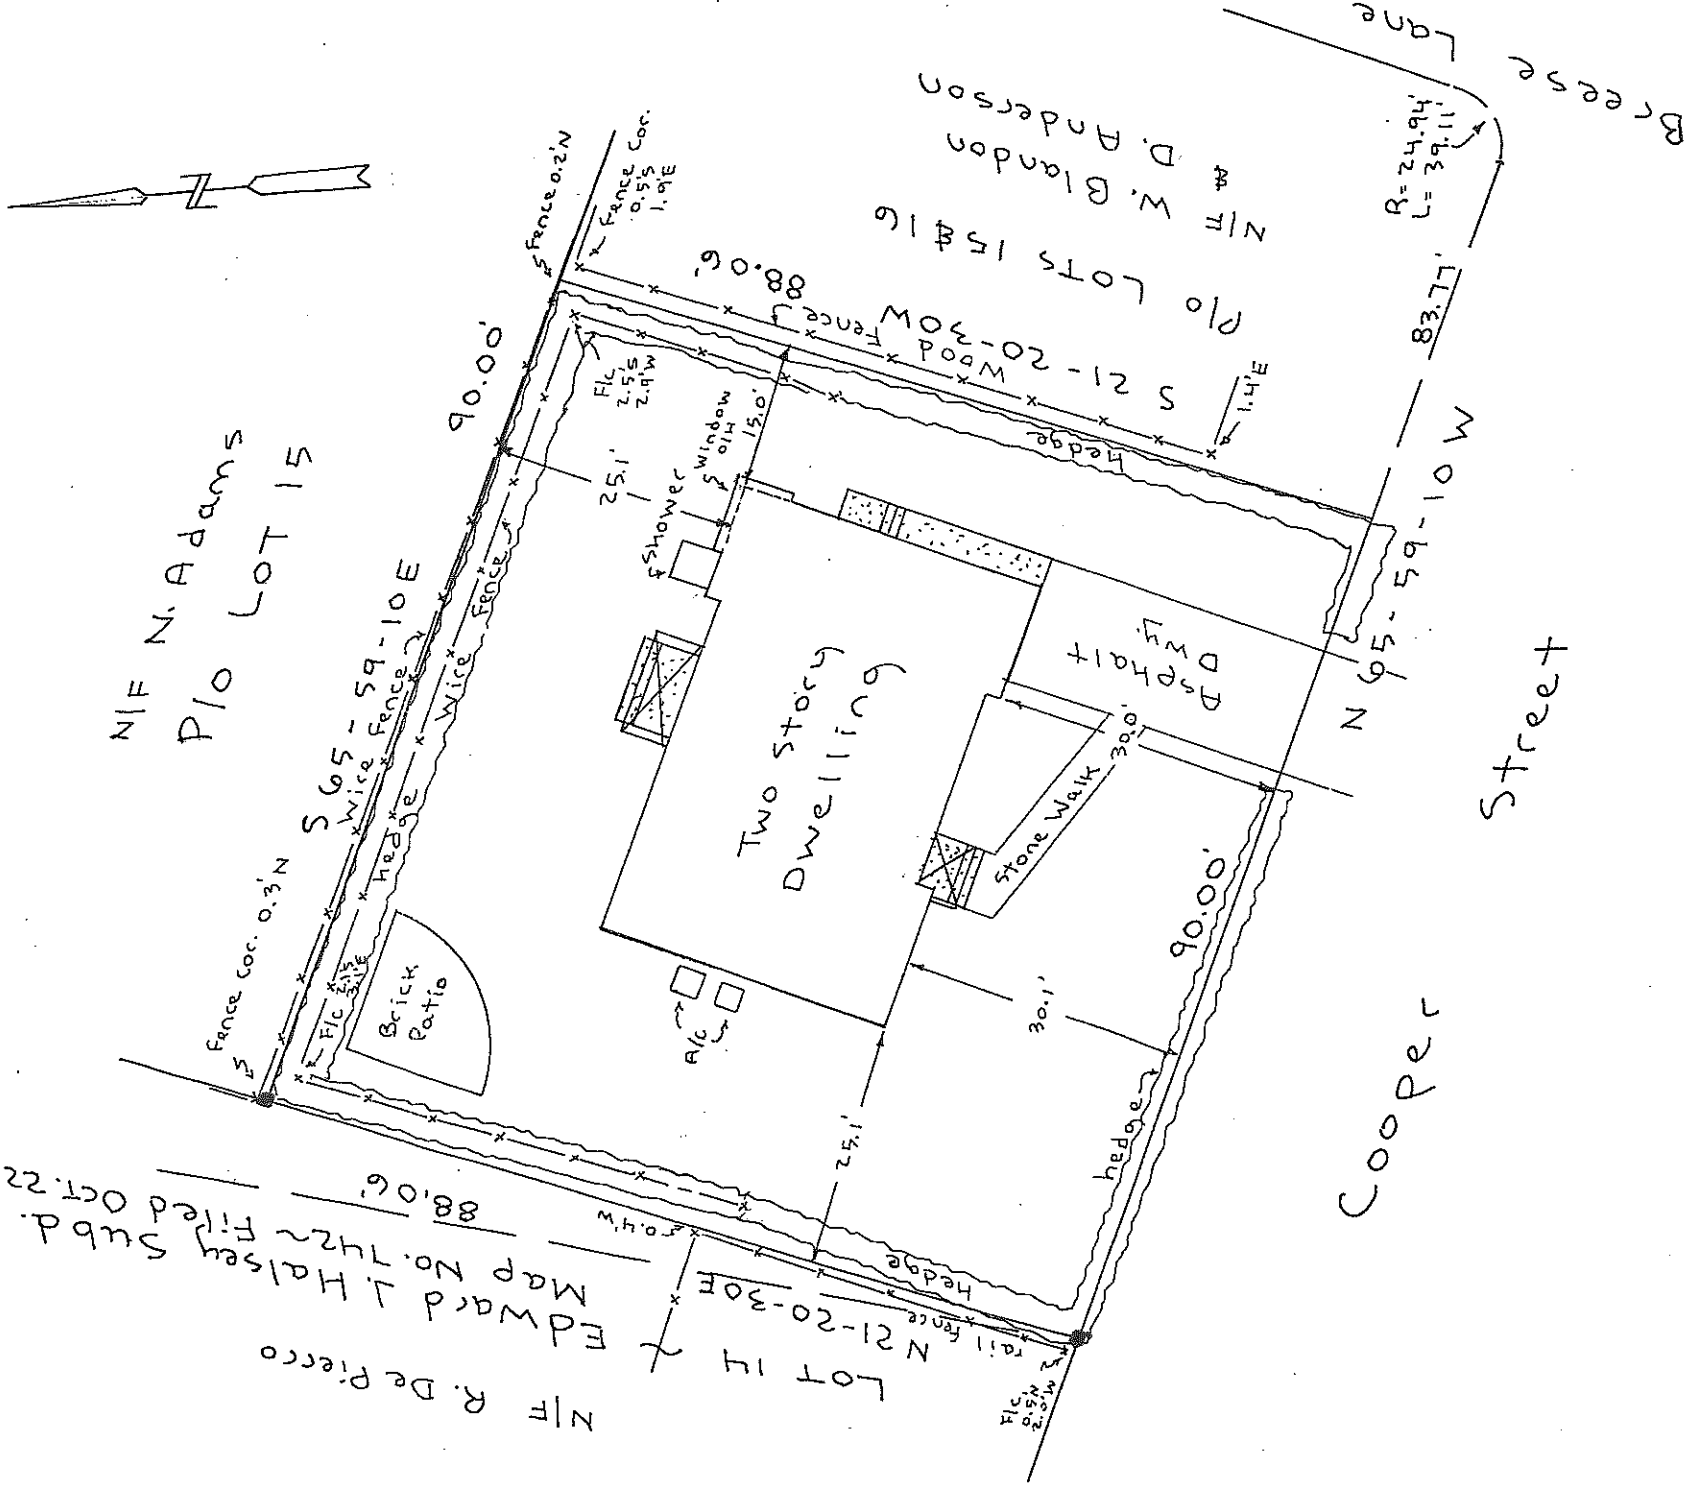

# SURVEY OF PROPERTY SITUATE

P10 Lots 15 & 16 ~ Southampton  
Downs ~ Inc. Village of  
Southampton


TOWN OF SOUTHAMPTON  
SUFFOLK COUNTY, NEW YORK

CERTIFIED TO:

Joe Rosenblatt  
Hudson City Savings  
Chicago Title Ins. Co. #1809-45894

PREPARED \_\_\_\_\_ SURVEYED June 05, 2002  
SCALE 1" = 20' ■ DENOTES MONUMENTS

Updated Survey 3-16-2009

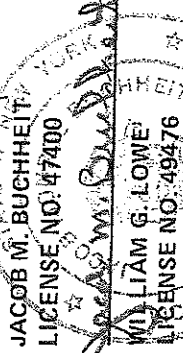

WILLIAM G. LOWE  
LICENSE NO. 49476

UNAUTHORIZED ALTERATION OR ADDITION TO  
THIS SURVEY IS A VIOLATION OF SECTION  
7208 OF THE NEW YORK STATE EDUCATION  
LAW.

COPIES OF THIS SURVEY MAY NOT BEARING  
THIS LAND SURVEYOR'S AND SEAL SHALL NOT BE  
BOSSED SEAL SHALL NOT BE CONSIDERED TO  
BE A VALID TRUE COPY.

GUARANTEES INDICATED HEREON SHALL RUN  
ONLY TO THE PERSON FOR WHOM THE SURVEY  
IS MADE AND ON HIS BEHALF TO THE  
TITLE COMPANY, LENDING INSTITUTION, AND  
TO THE ASSIGNEES OF THE LENDING INSTITUTION.  
THIS SURVEY IS NOT TRANSFERABLE TO  
ADDITIONAL INSTITUTIONS OR SUBSEQUENT  
OWNERS.

R.O.W. EASEMENTS AND UNDERGROUND UTILITIES  
WHETHER ABANDONED OR IN USE OR OTHERWISE  
NOTED ARE NOT SHOWN ON THIS SURVEY.

DOLLIVER ASSOCIATES  
LAND SURVEYORS  
HAMPTON BAYS, N. Y.

ADENOTES STAKES

226 22,23  
BK 194 PG 5