

SURVEY OF LOT 334

MAP OF SECTION D, NASSAU POINT CLUB PROPERTIES, INC.
FILED IN THE OFFICE OF THE CLERK OF SUFFOLK COUNTY
ON MAY 7 1925 AS MAP NUMBER 806

SITUATE: NASSAU POINT
TOWN: SOUTHOLD
SUFFOLK COUNTY, NY

SURVEYED 04-25-2007



REVISED 05-21-2007

SUFFOLK COUNTY TAX #

1000 - III - 4 - 13

CERTIFIED TO:

RICHARD FEVOLA
FIRST AMERICAN TITLE INSURANCE
COMPANY OF NEW YORK

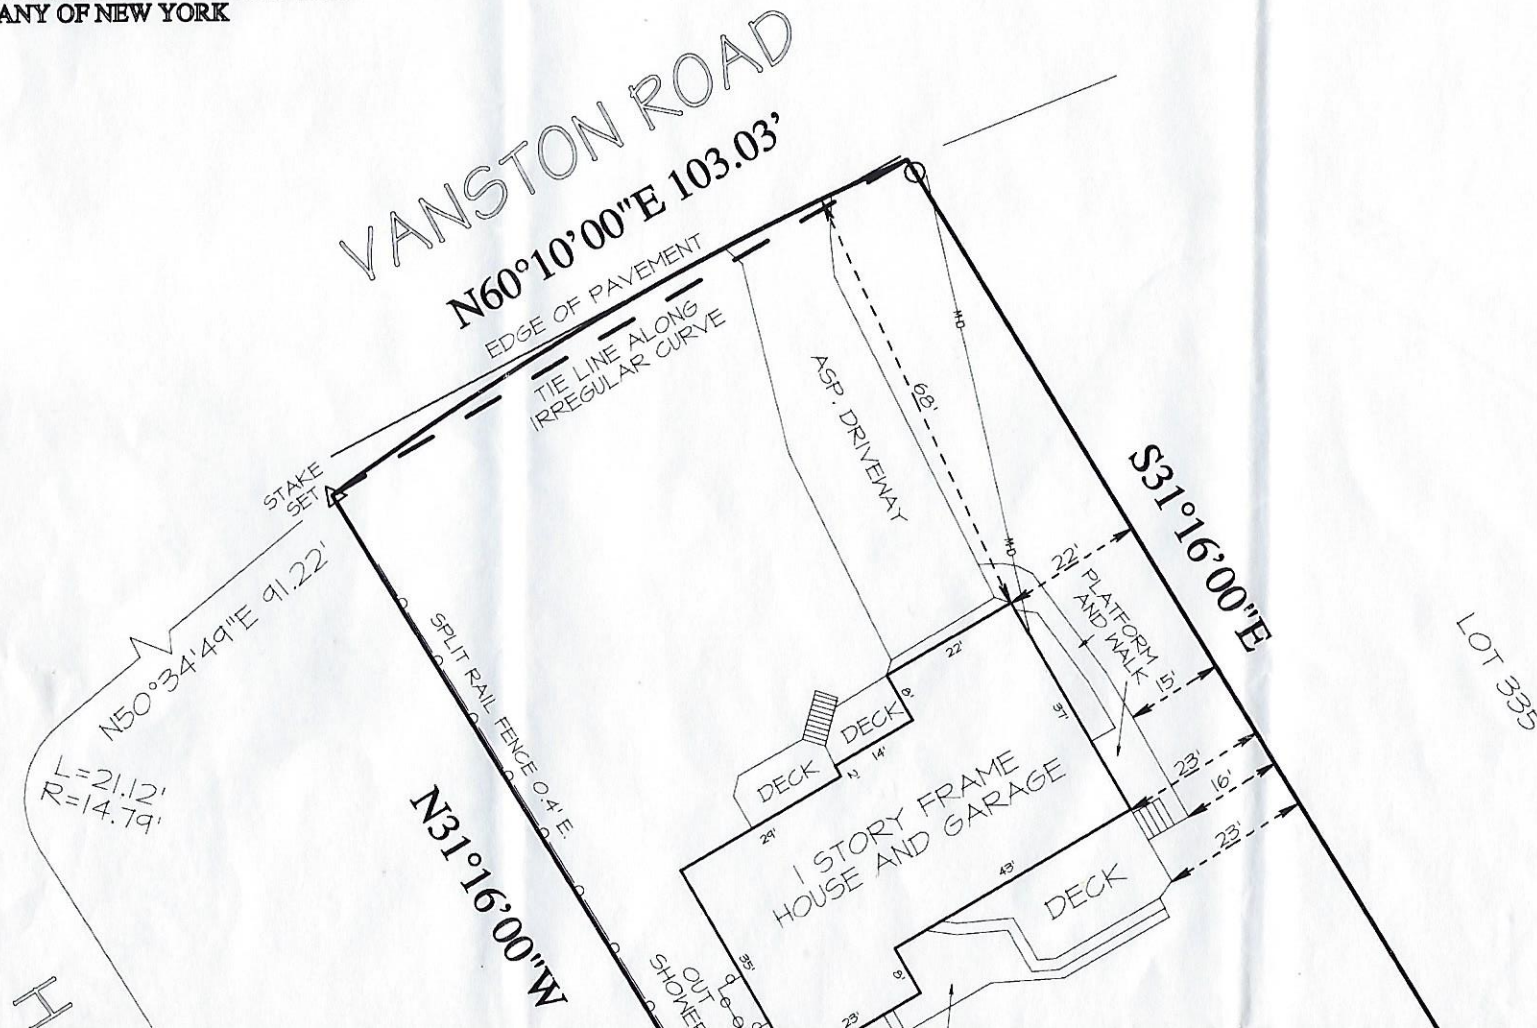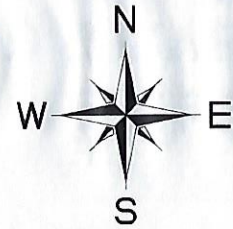

WATERS ROAD

LOT 333

LOT 334

255.00'

STOCKADE FENCE 0.4' E.

257.54'

S58°44'00"W 103.00'

LOT 350

NOTES:

- MONUMENT FOUND
- PIPE FOUND

AREA = 26,398 S.F. or 0.61 ACRE

GRAPHIC SCALE 1" = 30'



"Unauthorized alteration or addition to a survey map bearing a licensed land surveyor's seal is a violation of section 7209, sub-division 2, of the New York State Education Law."

"Only copies from the original of this survey marked with an original of the land surveyor's stamped seal shall be considered to be valid true copies."

"Certifications indicated hereon signify that this survey was prepared in accordance with the existing Code of Practice for Land Surveys adopted by the New York State Association of Professional Land Surveyors. Said certifications shall run only to the person for whom the survey is prepared, and on his behalf to the title company, governmental agency and lending institution listed hereon, and to the assignees of the lending institution. Certifications are not transferable to additional institutions."

JOHN C. EHLERS LAND SURVEYOR

6 EAST MAIN STREET
RIVERHEAD, N.Y. 11901

N.Y.S. LIC. NO. 50202

369-8288 Fax 369-8287 REF:\\Compaqserver\\pros\\05\\05-124.pro