


BEARINGS SCHEDULE		
LTR	BEARINGS	DISTANCES
A	N 38°29'10" W	7.22'
B	N 32°29'58" W	25.60'
C	N 25°21'46" W	28.96'
D	N 17°02'34" E	4.98'
E	N 24°52'16" W	15.89'
F	N 07°58'55" W	10.46'
G	N 31°13'21" W	16.95'
H	N 21°09'57" W	23.44'
I	N 26°23'55" W	5.35'
J	N 26°27'01" W	33.31'
K	N 19°54'51" W	24.31'
L	N 06°34'25" W	17.33'

SEPTIC SYSTEM LOCATION		
	A	B
ST	13'	24'
LP1	33'	44'
LP2	33'	47'
LP3	32'	41'
LP4	38'	48'
LP5	40'	52'

**NOTE:**  
SEPTIC SYSTEM AND WATERLINE  
LOCATED BY OTHERS

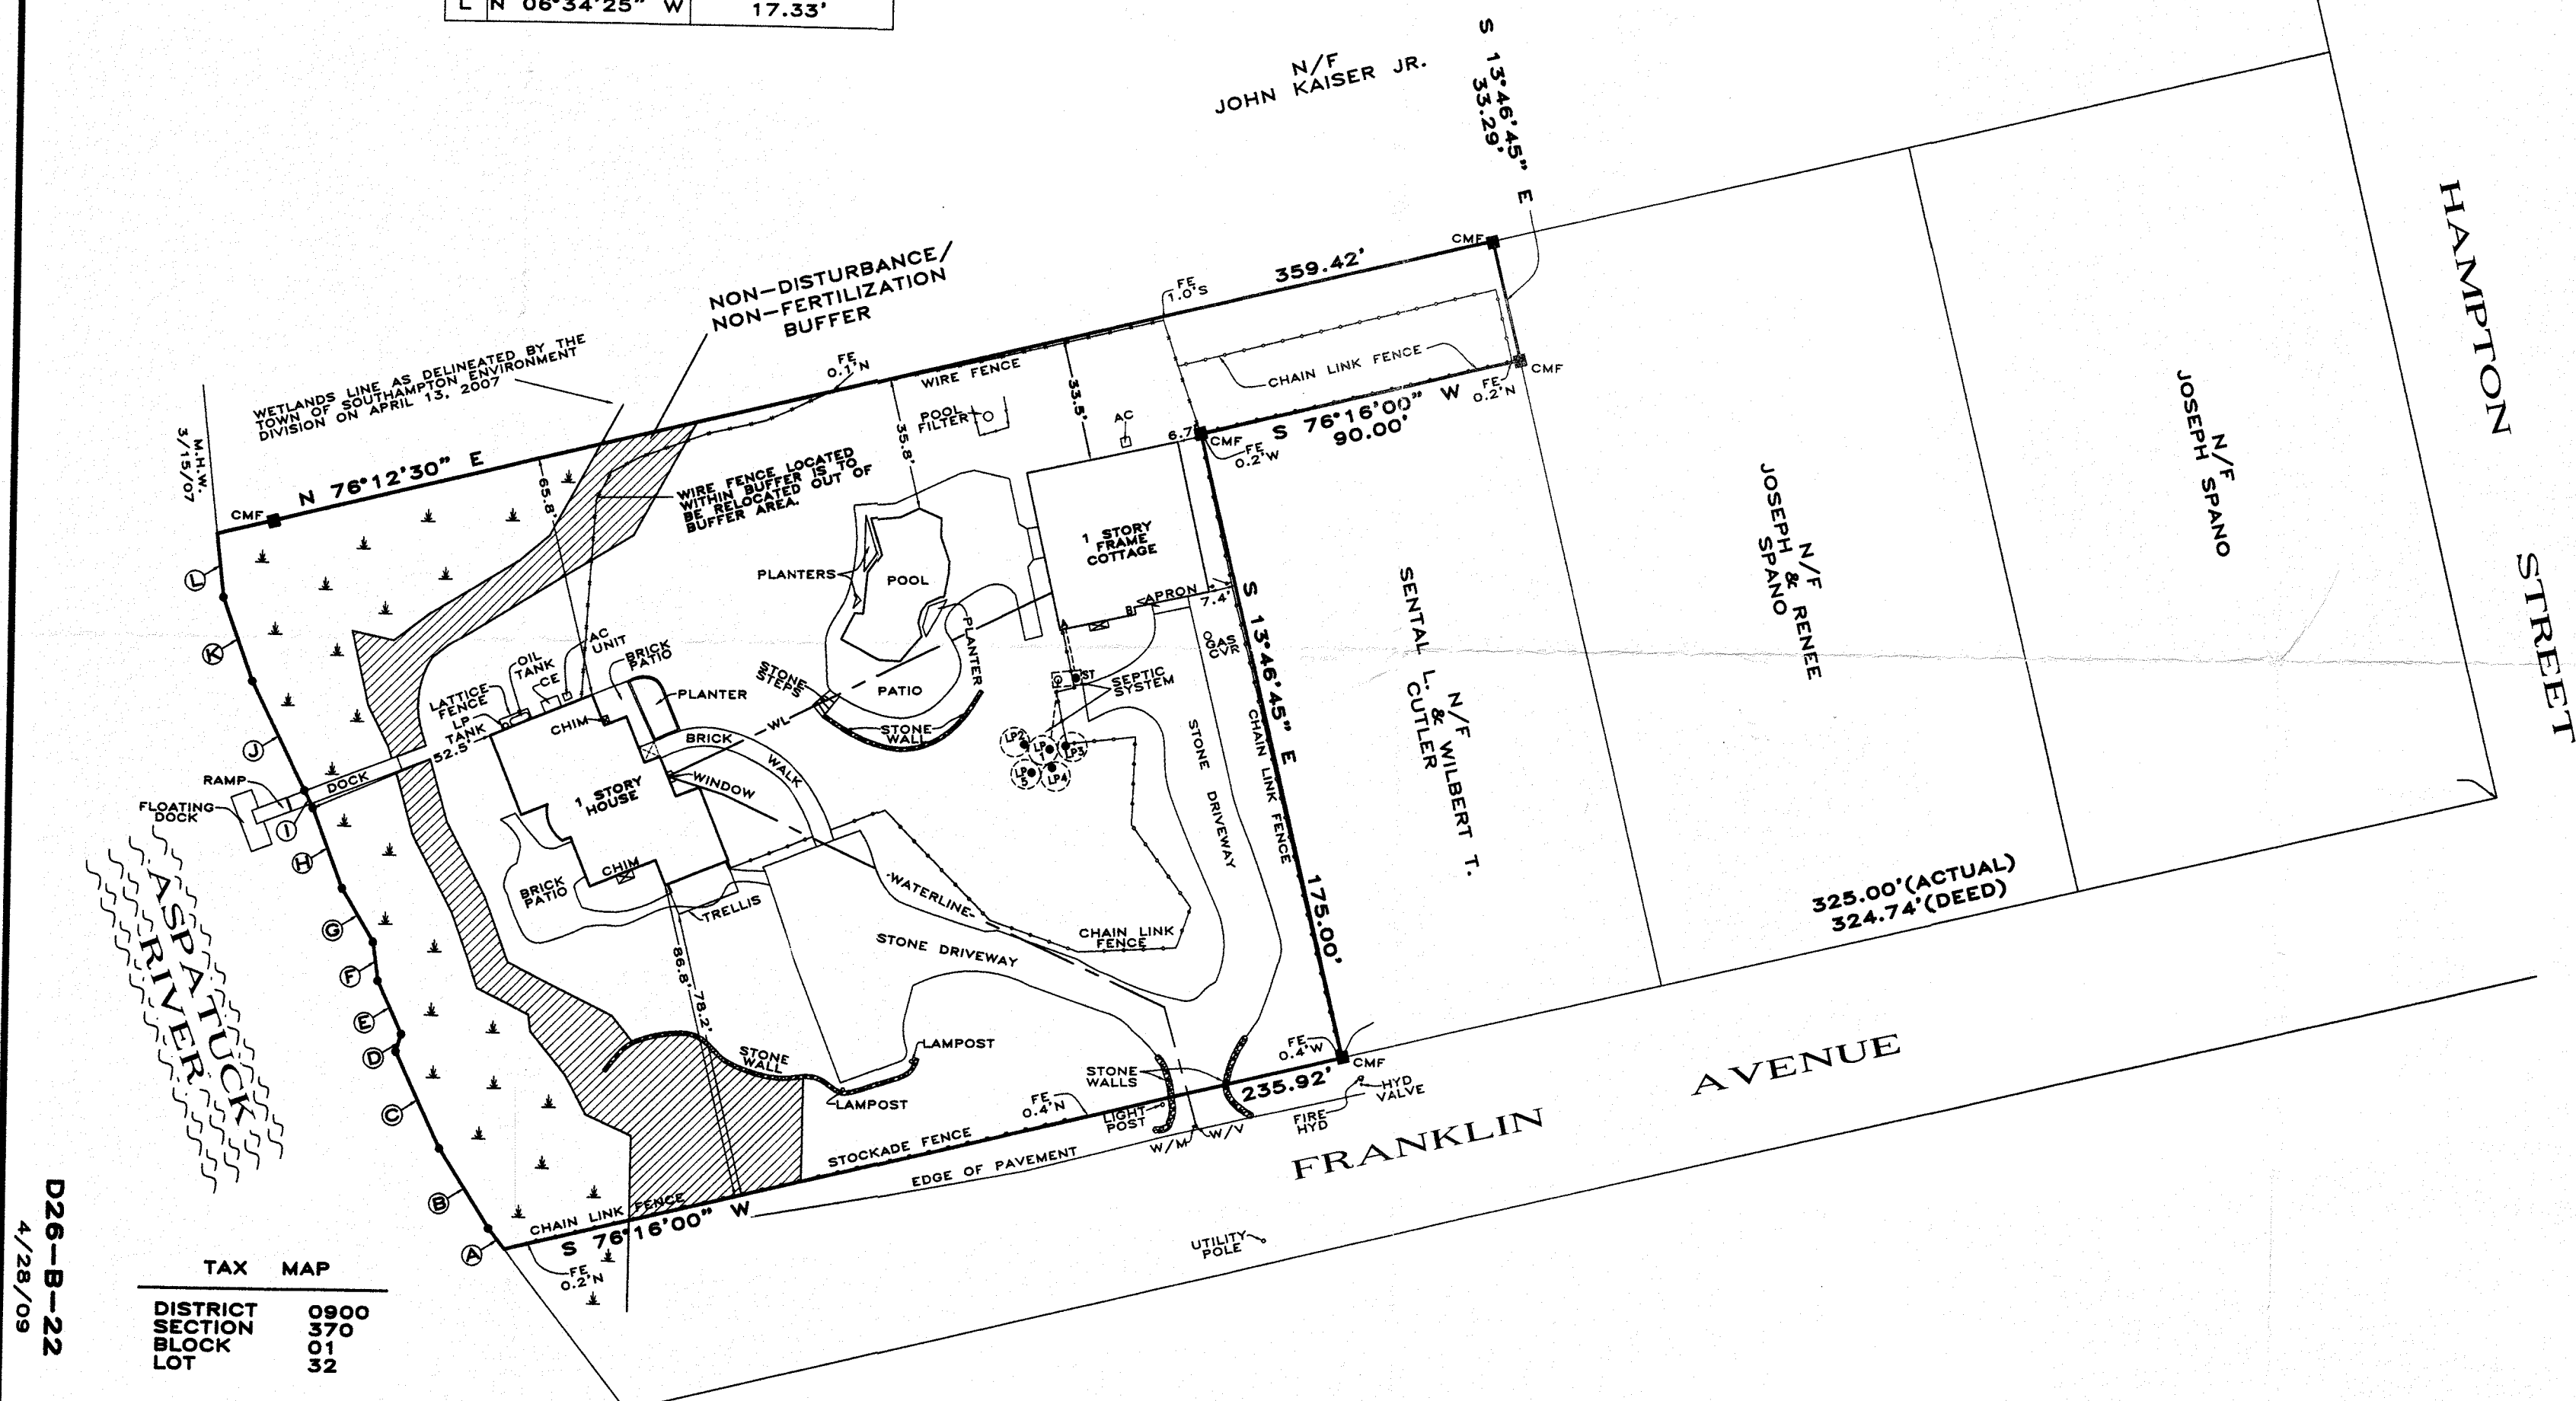

**D26-B-22**  
4/28/09

**TAX MAP**

DISTRICT	0900
SECTION	3700
BLOCK	01
LOT	32

UNAUTHORIZED ALTERATION OR ADDITION TO A SURVEY MAP BEARING A LICENSED LAND SURVEYOR'S SEAL IS A VIOLATION OF SECTION 7209, SUB-DIVISION 2, OF THE NEW YORK STATE EDUCATION LAW.

ONLY COPIES FROM THE ORIGINAL OF THIS SURVEY MARKED WITH AN ORIGINAL OF THE LAND SURVEYOR'S INKED SEAL OR EMBOSSED SEAL SHALL BE CONSIDERED TO BE VALID TRUE COPIES.

CERTIFICATIONS INDICATED HEREON SHALL RUN ONLY TO THE PERSON FOR WHOM THE SURVEY IS PREPARED, AND ON HIS BEHALF TO THE TITLE INSURANCE COMPANY, GOVERNMENTAL AGENCY AND LENDING INSTITUTION LISTED HEREON, AND TO THE ASSIGNEES OF THE LENDING INSTITUTION. CERTIFICATIONS ARE NOT TRANSFERABLE TO ADDITIONAL INSTITUTIONS OR SUBSEQUENT OWNERS.

**RAYNOR, MARCKS & CARRINGTON SURVEYING**  
P.O. BOX 5027  
QUOGUE, N.Y.  
631-653-4066

60 FRANKLIN AVENUE

AREA: 56,519 SQ. FT. (TOTAL)  
47,961 SQ. FT. (UPLAND)  
BK:235 PG:57



**MAP OF PROPERTY  
FOR  
JOAN CROWTHER  
SITUATE  
QUIOGUE**

TOWN OF SOUTHAMPTON - SUFFOLK COUNTY, N.Y.  
SURVEYED: MARCH 15, 2007 - SCALE: 1" INCH = 40' FT.  
WETLAND LOCATION: APRIL 27, 2007  
UNDER CONSTRUCTION COTTAGE: MARCH 26, 2008  
FINAL: NOVEMBER 17, 2008

**D26-B-22**  
4/28/09  
DRAWN BY: JC/JL/HAR  
(ARCHIV13 CROWTHER)