


**SUFFOLK COUNTY TAX MAP**

|          |         |
|----------|---------|
| DISTRICT | 0904    |
| SECTION  | 01.00   |
| BLOCK    | 02.00   |
| PARCEL   | 009.000 |

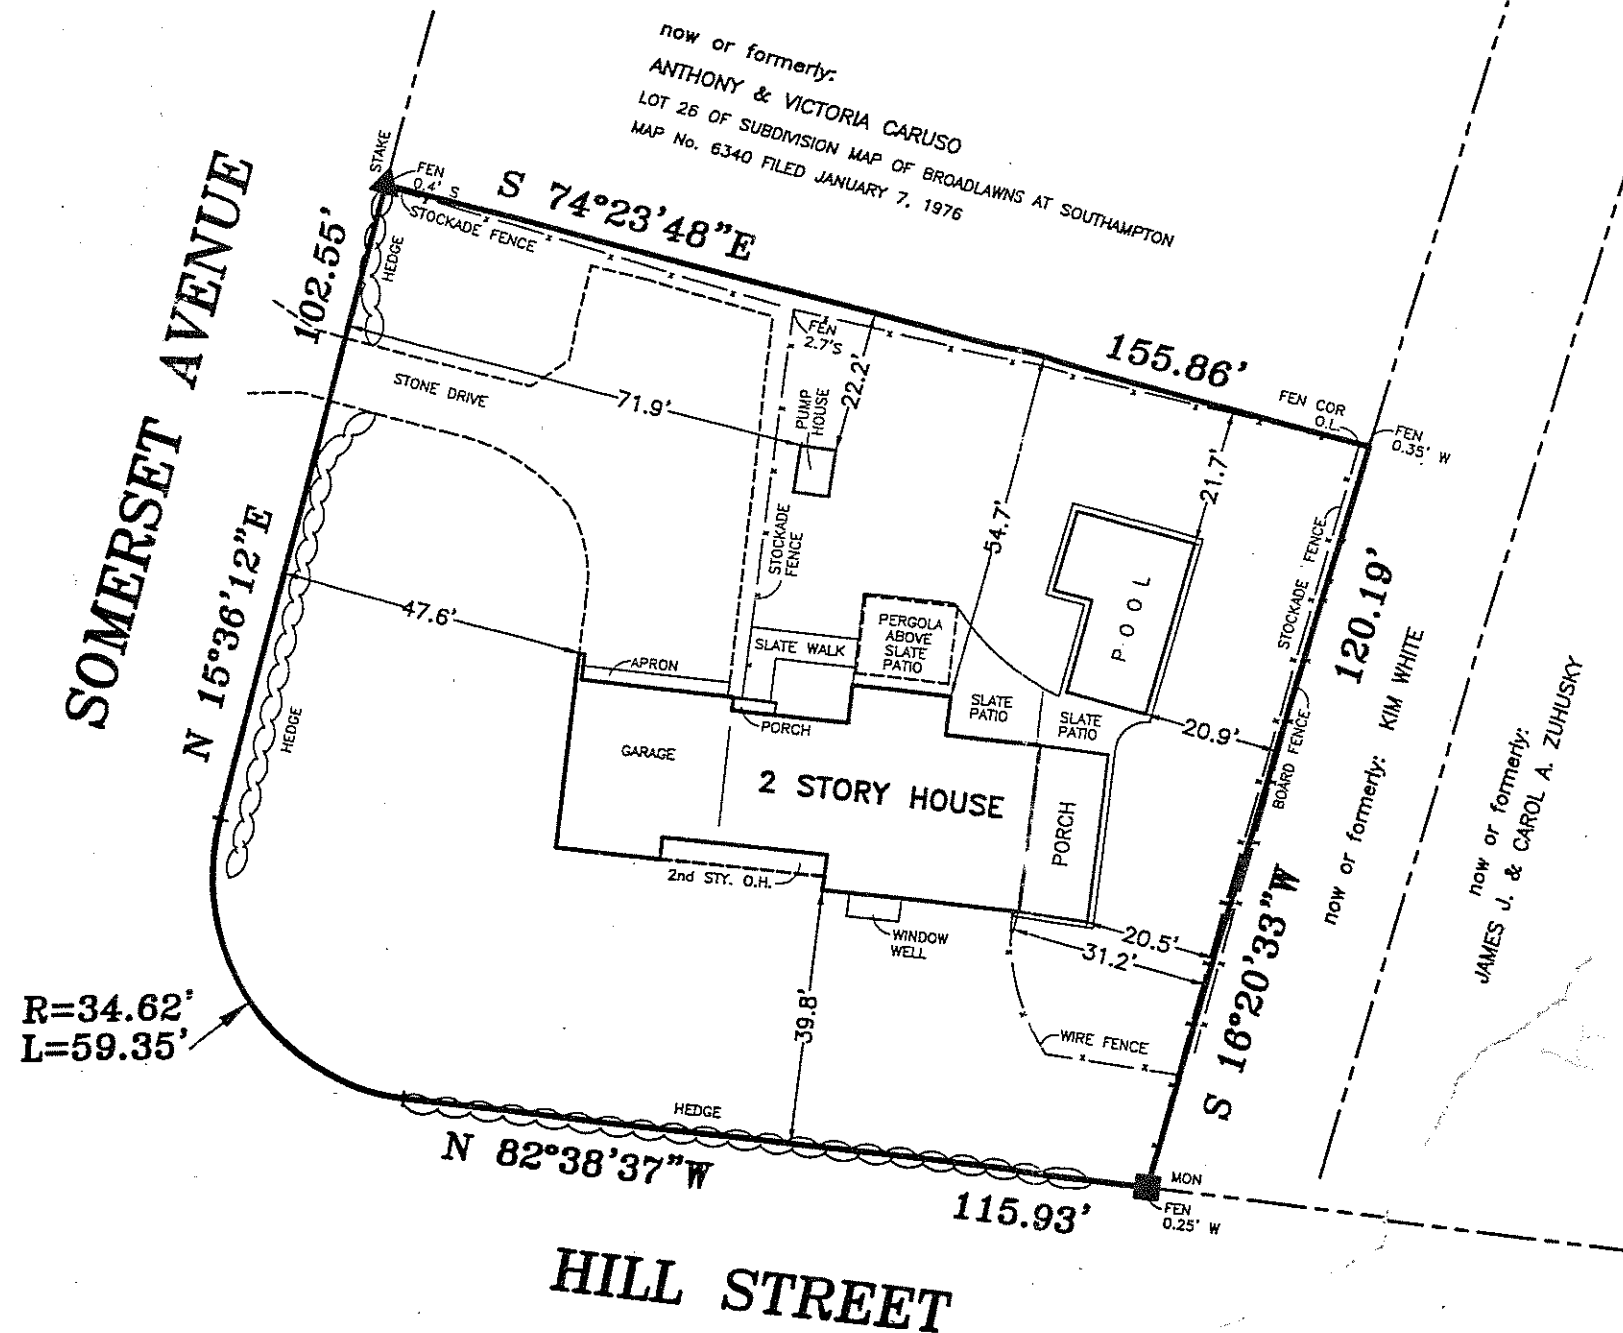

REVISED: JULY 11, 2005 (FINAL ON POOL, PORCH, PATIO & PUMP HOUSE)  
REVISED: FEBRUARY 9, 2005 (SHED REMOVED)  
SURVEYED: SEPTEMBER 1, 2004

  
 ROBERT A. SMITH, L.S. No. 49239  
 S. H. W. & S. LAND SURVEYORS P.C.  
**SQUIRES, HOLDEN, WEISE**  
 LAND SURVEYORS ~ ENGINEERS  
 SOUTHAMPTON ~ NEW YORK

UNAUTHORIZED ALTERATION OR ADDITION TO  
A SURVEY MAP IS A VIOLATION OF LAND  
SURVEYING LAWS OF THE STATE OF NEW YORK  
7200, SECTION 13, OF THE NEW YORK  
EDUCATION LAW.  
COPYRIGHT © 1983 SURVEY MAP NOT BEARING THE  
LAND SURVEYING BOARD OF THE STATE OF NEW YORK  
SEAL SHALL NOT BE CONSIDERED TO BE A VALID  
LEGAL DOCUMENT.  
CERTIFICATIONS ARE CITED HEREON ONLY IN THAT  
THEY HAVE BEEN PREPARED IN ACCORDANCE WITH  
THE RULES OF THE BOARD OF LAND SURVEYS  
AND ARE OF THE SAME FORCE AND EFFECT AS  
OFFICIAL SURVEY CERTIFICATIONS  
SHALL BE GIVEN BY THE PERSON FOR WHOM THE  
SURVEY WAS MADE AND NOT BE MADE BY THE  
LAND SURVEYING BOARD OR ANY OF THE LENDING  
INSTITUTIONS LISTED HEREIN AND TO THE ASSIGNEE'S  
OF THE LENDING INSTITUTION. CERTIFICATIONS ARE NOT  
TRANSFERABLE TO ADDITIONAL INSTITUTIONS OR  
SUBSEQUENT OWNERS.

INC. VILLAGE OF SOUTHAMPTON  
TOWN OF SOUTHAMPTON  
SUFFOLK COUNTY, NEW YORK

AREA = 20,006 S.F. (0.459 AC.)

SCALE: 1" = 30'