

SUFFOLK COUNTY TAX MAP

DISTRICT
SECTION
BLOCK
PARCEL


0904
08.00
01.00
053.000

■ INDICATES MONUMENT



NOW OR FORMERLY
PAUL ANDREWS
LOT No. 5, BLOCK "B" BEN MICHAELS MAP

NOW OR FORMERLY
WILLIAM M. KANYUCK & MICHAEL SCHEETZ
LOT No. 6, BLOCK "B" BEN MICHAELS MAP

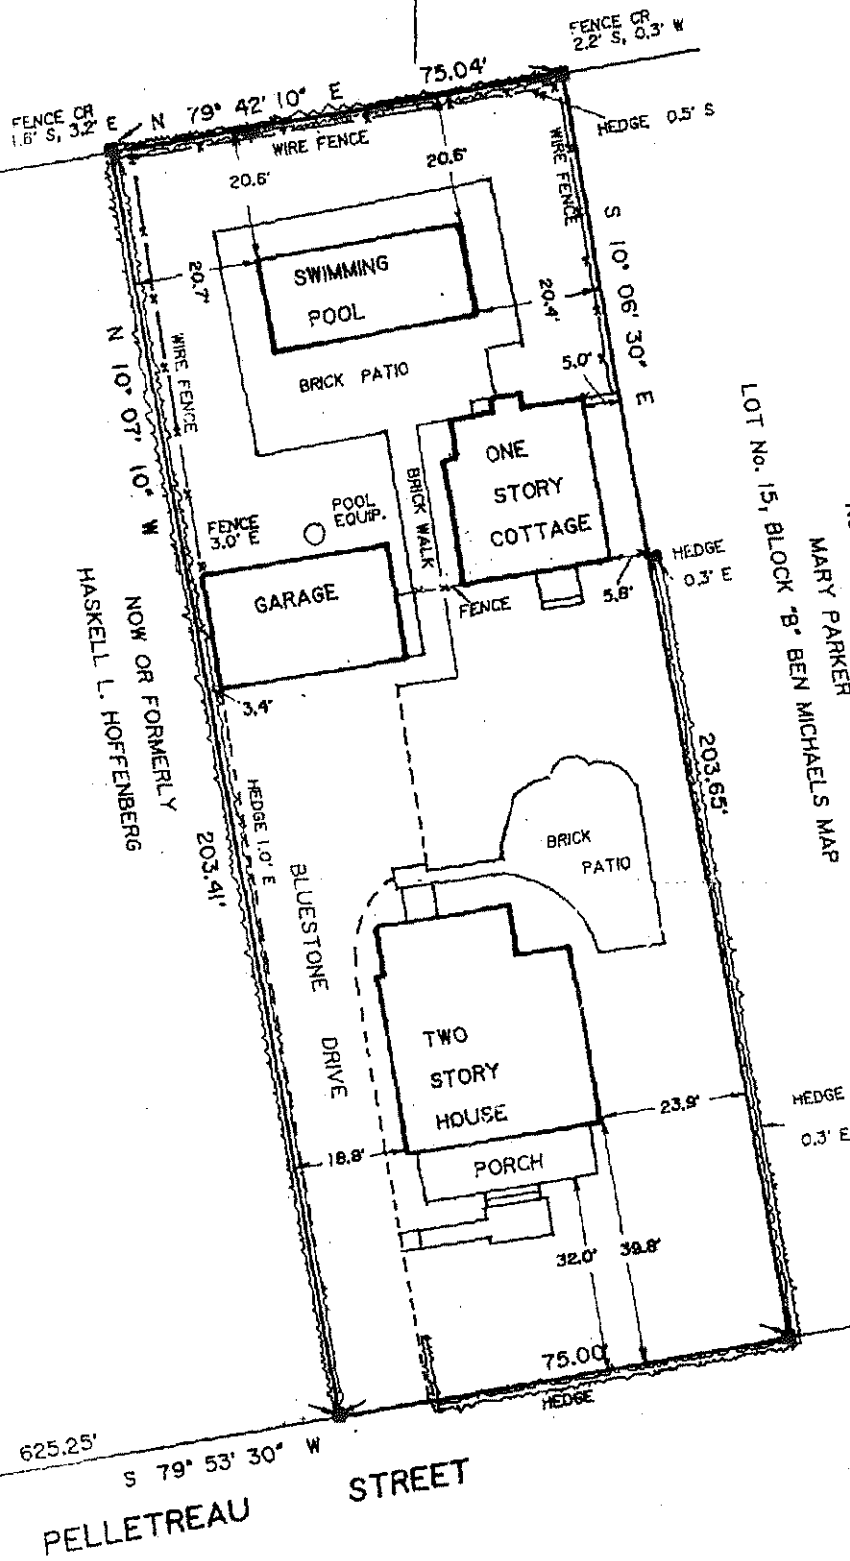


UNAUTHORIZED ALTERATION OR ADDITION TO
A SURVEY MAP BEARING A LICENSED LAND
SURVEYOR'S SEAL IS A VIOLATION OF SECTION
7209, SUB-DIVISION 2, OF THE NEW YORK
EDUCATION LAW.
COPIES OF THIS SURVEY MAP NOT BEARING THE
LAND SURVEYOR'S GREEN HARVEY SEAL OR EMBOSSED
SEAL SHALL NOT BE CONSIDERED TO BE A
TRUE COPY.
CERTIFICATIONS INDICATED HEREON SIGNIFY THAT
THIS SURVEY WAS PREPARED BY A LICENSED
SURVEYOR IN COMPLIANCE WITH THE
EXISTING CODE OF PRACTICE FOR LAND
ADOPTED BY THE NEW YORK STATE BOARD OF
PROFESSIONAL LAND SURVEYORS.
THIS SURVEY MAP SHALL BE USED FOR
SHALL RUN ONLY TO THE PERSON OR
FIRM TO WHOM THE SURVEY MAP IS
SURVEY IS PREPARED AND FOR THE
USE OF THE SURVEYOR OR THE
FIRM OR COMPANY EMPLOYED BY THE
INSTITUTION LISTED HEREON AND IS
NOT TO BE LOANED, REPRODUCED, COPIED,
OR TRANSFERRED TO ADDITIONAL INSTITUTIONS OR
SUBSEQUENT OWNERS.

MAP OF LOT 14 - BLOCK B
PROPERTY OF
BEN MICHAELS CO.
MAP No. 190 FILED JULY 21, 1926
FOR
PAUL BURKHART
SITUATE
INC. VILLAGE OF SOUTHAMPTON
TOWN OF SOUTHAMPTON
SUFFOLK COUNTY, N.Y.

SCALE 1" = 30'
AREA = 0.351 ACRE (15,269 SQ. FT.)

SURVEYED : MAY 24, 200

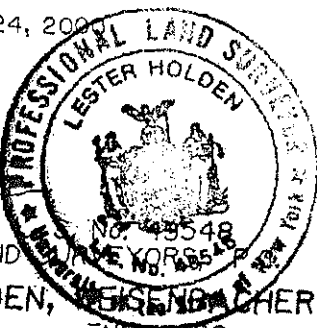

LESTER HOLDEN
S. H. W. & S. LAND SURVEYORS
SQUIRES, HOLDEN, WEISBERGER & SMITH
LAND SURVEYORS ~ ENGINEERS
SOUTHAMPTON ~ NEW YORK

BK 314 P 23
348 53

321 P. 118
736 P. 149-150
714 P. 130

MC 1000