


COPY

LAND N/F OF THE METHODIST CHURCH

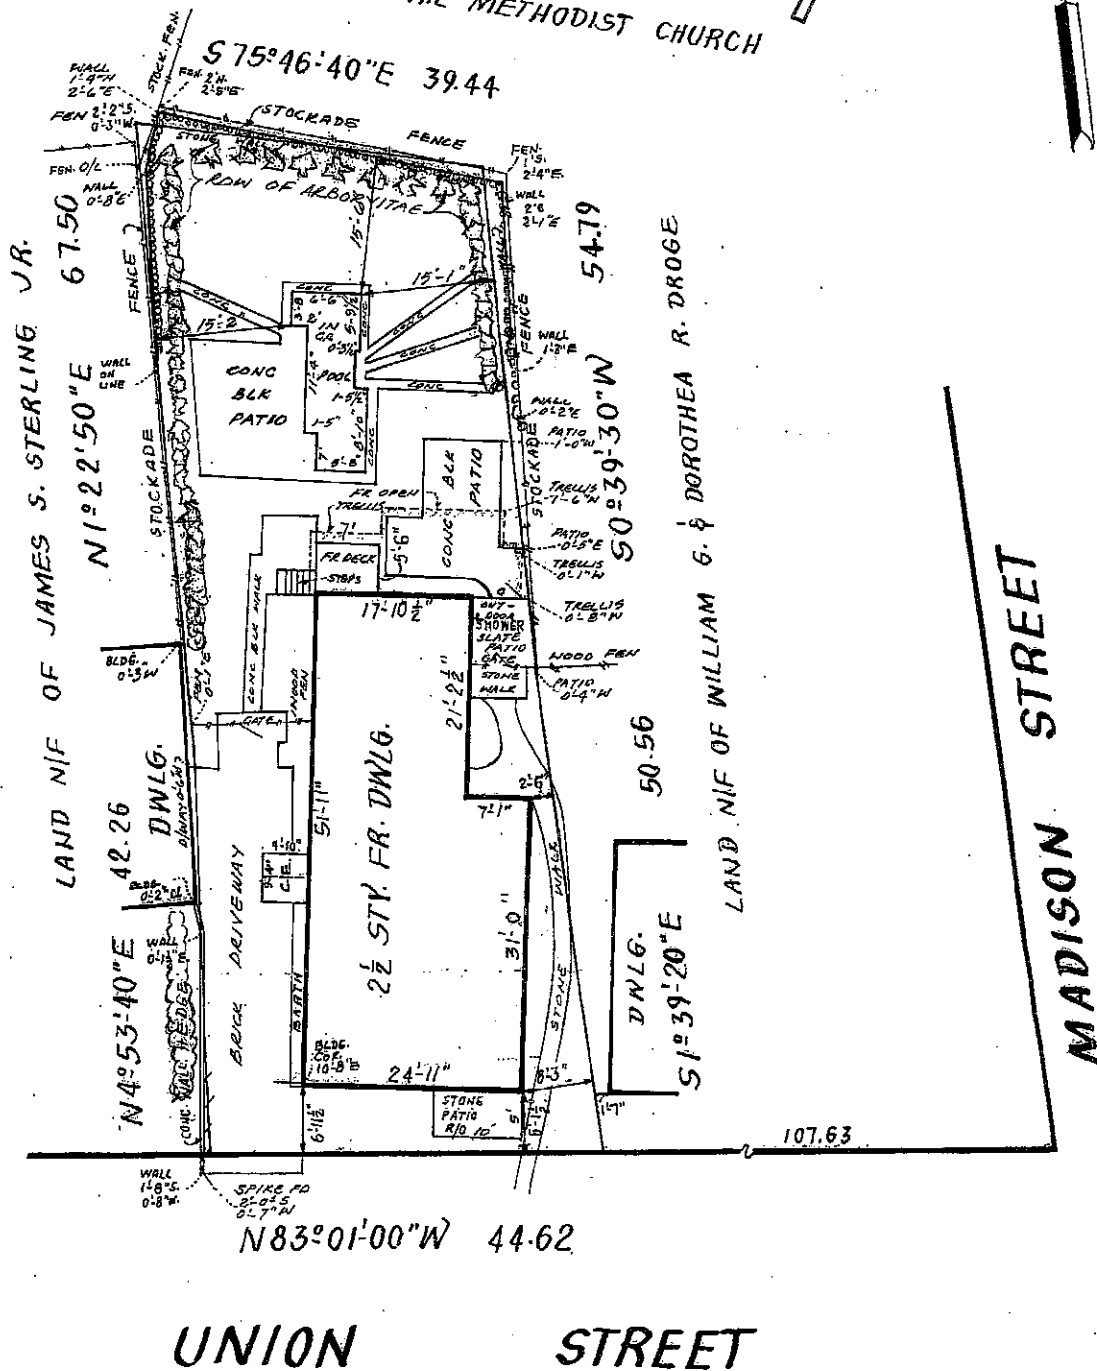

Situated in The Incorporated Village of

SUFFOLK COUNTY
NEW YORK

Scale: 1" = 16'

Surveyed
by

Smith, Jung & Gillis

Ernest G. Jung
Professional Land Surveyor
120 Medford Avenue
Patchogue, NY 11772
Phone: 631-475-3192

Dates Surveyed: FEBRUARY 24, 2006; JULY 6, 2006; JULY 26, 2007.

BEEGAN