

MAP OF PROPERTY **LOTS 26-30 and 93-97** **MONTAUK SHORES**

Filed: MAY 21, 1927 - Map No. 156

SITUATE

Town Of East Hampton, Suffolk Co., N.Y.

Scale: 1"=30'

Area: 20,000 S.F. or 0.459 Acres

Certified To:

Stewart Title Ins. Co.

Bridgehampton National Bank

PERMITTED CLEARING = 15,000 S.F.
 EXISTING CLEARING = 6,881 S.F.

Surveyed: October 17, 2011

GEORGE WALBRIDGE SURVEYORS, P.C.

Land Surveyors & Land Planners


360 Parkside Plaza - Suite 116

East Hampton, Long Island, N.Y. 11937

Phone: (631) 324-3412 Fax: (631) 324-9849

E-mail: gwalbridge@aol.com

c:\land projects dave\1106-102.dwg survey

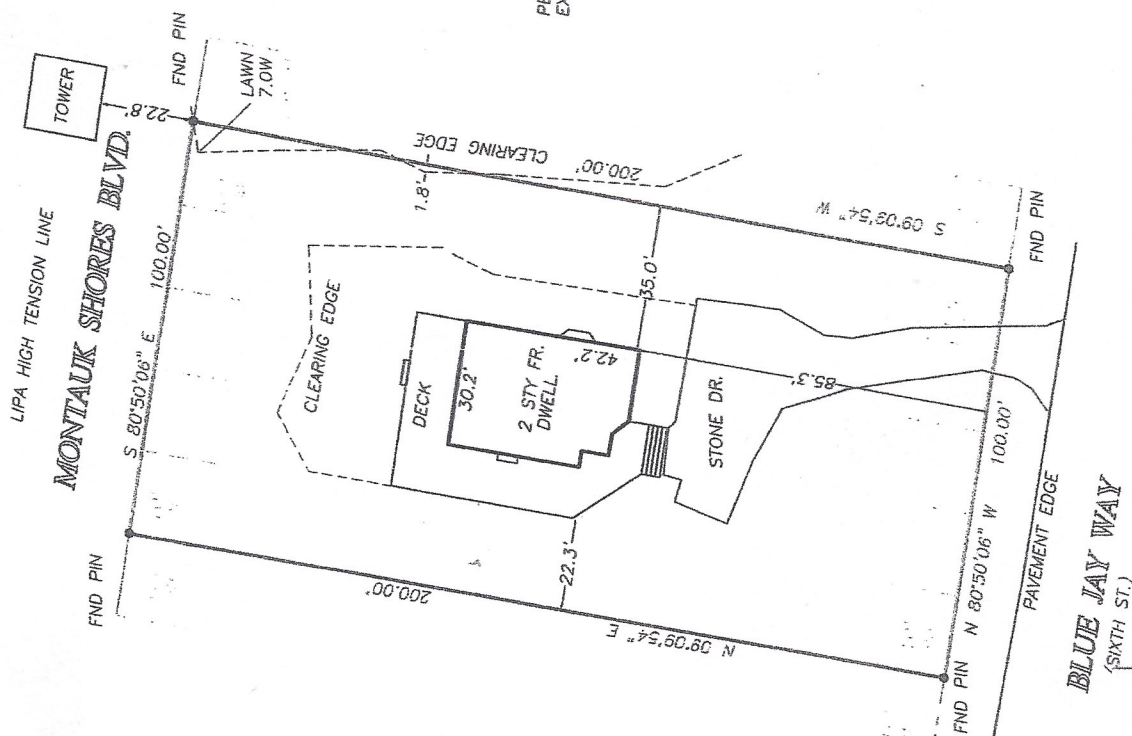

authorized alteration or addition to a survey
 made by George Walbridge Surveyors, P.C.
 in accordance with the provisions of the
 Surveyors' Law of the State of New York.
 The original of this survey map
 is on file in the office of the Surveyor
 General for the State of New York.
 This map is a true and correct copy
 of the original and is intended to be a
 permanent record of the survey.
 It is to be used only for the purpose
 for which it was made and is not to be
 used for any other purpose without the
 written consent of George Walbridge
 Surveyors, P.C.

corcoran
 corcoran group real estate

Nancy Howell
 Licensed Associate Real Estate Broker

nancy.howell@corcoran.com
 o: 631.907.1503
 m: 631.875.2049
 f: 631.488.2748

51 Main Street
 East Hampton NY 11937