


LONG ISLAND RAIL ROAD

QUOGUE - RIVERHEAD ROAD (C.R. 104)

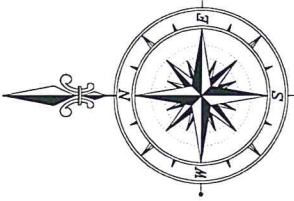

RECEIVED

OCT 27 2015

INC. VILLAGE QUOGUE, NY

*Handwritten signature: M. J. Murphy*

DATE: SEPT. 29, 2015  
JOB NO: 2015-553


CERTIFIED TO:  
SEAN GLICKENHAUS &  
PAULA GLICKENHAUS  
GUARDHILL FINANCIAL CORP.

*Handwritten signature in red ink.*

DAVID H. FOX, L.S. P.C. N.Y.S.L.S. #50234  
**FOX LAND SURVEYING**  
64 SUNSET AVENUE  
WESTHAMPTON BEACH, N.Y. 11978  
(631) 288-0022

UNAUTHORIZED ALTERATION OR ADDITION TO THIS SURVEY IS A VIOLATION OF SECTION 7209 OF THE NEW YORK STATE EDUCATION LAW. ANY PERSON WHO VIOLATES THIS SECTION SHALL BE CONSIDERED TO BE A VALID TRUE COPY.  
CERTIFICATION INDICATED HEREON SHALL RUN ONLY TO THE PERSON FOR WHOM THE SURVEY IS PREPARED AND ON HIS BEHALF TO THE TITLE COMPANY, GOVERNMENTAL AGENCY AND LENDING INSTITUTION LISTED HEREON, AND TO THE ASSIGNEES OF THE LENDING INSTITUTION. CERTIFICATIONS ARE NOT TRANSFERABLE TO OTHER INSTITUTIONS OR SUBSEQUENT OWNERS.

DWG: 2015-553

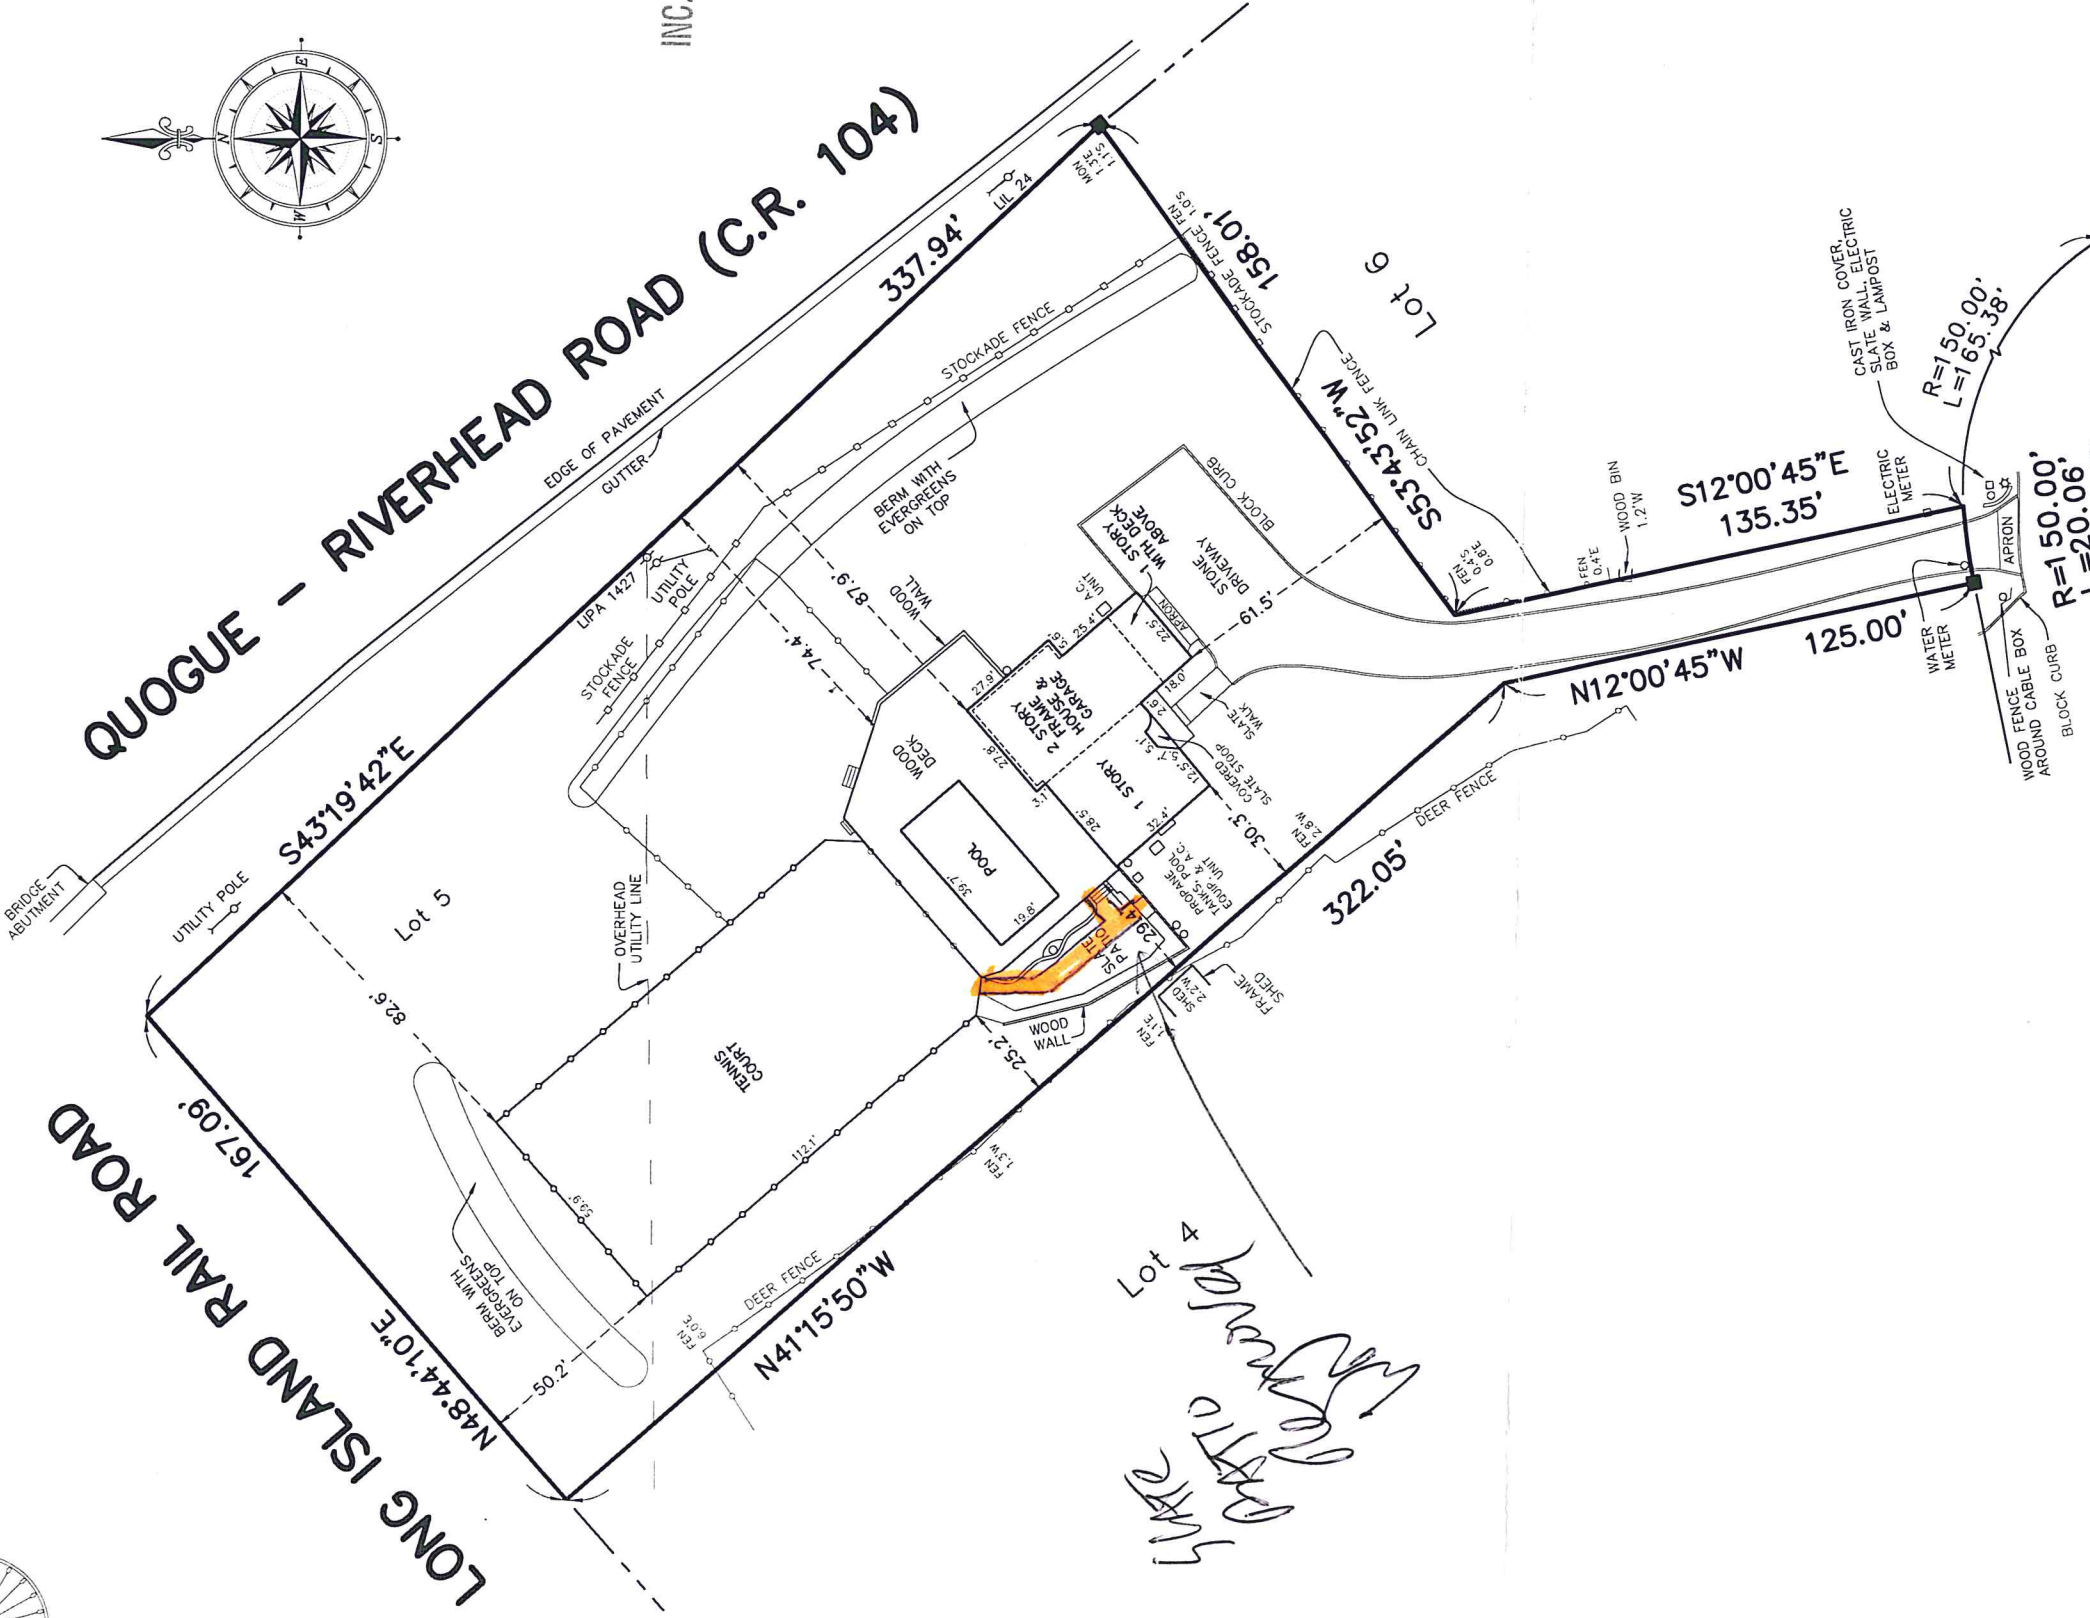

DEERFIELD

Survey for:


SEAN GLICKENHAUS &  
PAULA GLICKENHAUS

Lot 5, "Barry Beil"

At

Quogue  
Town of  
Southampton  
Suffolk County, New York

S.C.T.M.: 0902-001.00-01.00-018.005

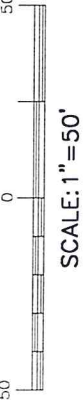

SCALE: 1"=50'

RECEIVED

OCT 27 2015

INC. VILLAGE OF QUOGUE, NY

- NOTES:
1. AREA = 59,680 S.F.
  2. ■ = MONUMENT FOUND, ▲ = STAKE FOUND.
  3. SUBDIVISION MAP "BARRY BEIL" FILED IN THE OFFICE OF THE CLERK OF SUFFOLK COUNTY ON OCT. 27, 1983 AS FILE NO. 7247