

SUFFOLK COUNTY HEALTH DEPARTMENT

DATE **AUG 19 1976**


H. D. REF. # **650-28**

The sewage disposal and water supply facilities for this location have been inspected by this department and found to be satisfactory.

R. Winters
Chief of General Engineering Services
(vacant)

Test Hole

35.8 LANE
HORTON'S
601.74 to Soundview R.

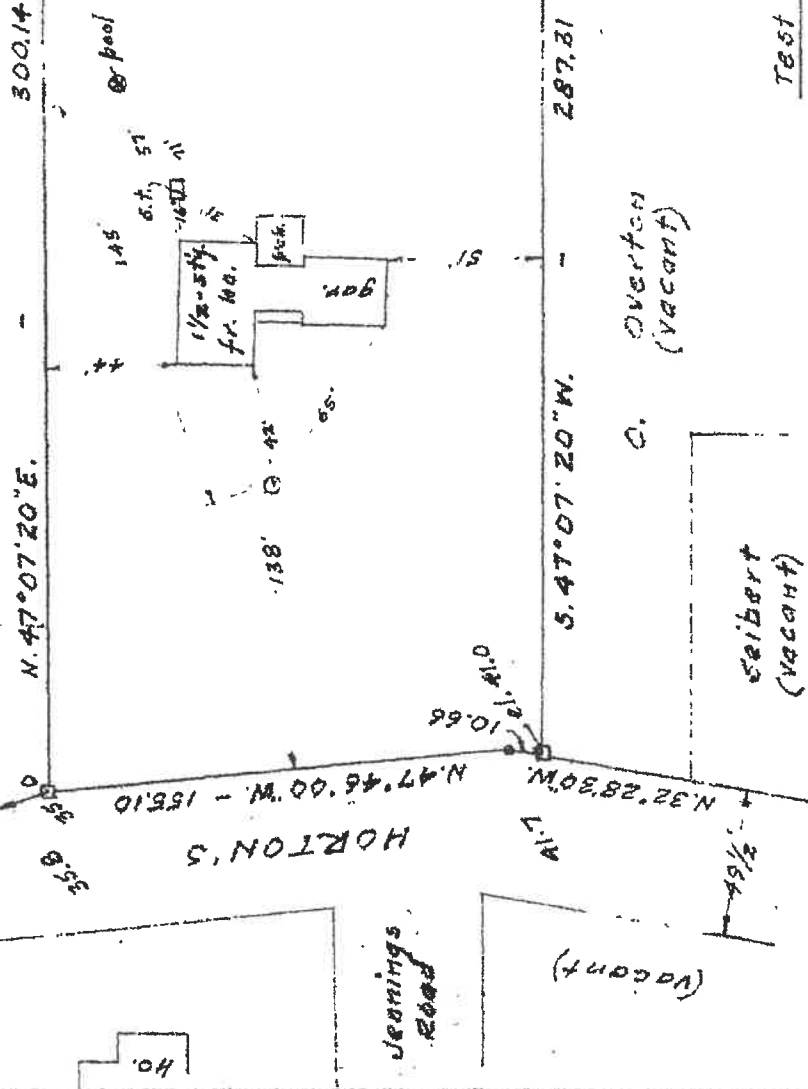

MAP OF PROPERTY
SURVEYED FOR
GARY WINTERS
AT
SOUTHOLD
SUFFOLK CO., N.Y.

Scale: 50' = 1"

Guaranteed to U.S. Life Title Insurance Co. and to Southold Savings Bank as surveyed May 15, 1976

Roderick Van Tuyl, P.C.

Roderick Van Tuyl
Licensed Land Surveyors
Greenport, N.Y.

Village of Greenport (vacant)

Test Hole

0	1'	3'	10'	14'
top-soil	loam	gravel	sandy clay	clay & rocks

Area: 48,249 sq. ft.

□ = Monument

● = 76 JUL 20 AM 10:28 Piped

Elevations referred to N.T.S. datum
Elev. 35.0 at N.W. cor. of monument

UNAUTHORIZED ALTERATION OR ADDITION TO THIS SURVEY IS A VIOLATION OF SECTION 2229 OF THE NEW YORK STATE EDUCATION LAW
COPIES OF THIS SURVEY AT N.T. BEARING NO LAND SURVEYOR'S SEAL OR SIGNATURE ARE VOID
GUARANTEES THAT THE SURVEY IS ACCURATE AND THAT THE SURVEYOR HAS BEEN ADEQUATELY TRAINED AND EQUIPPED TO PERFORM THE SURVEY
THE SURVEYOR'S LIABILITY IS LIMITED TO THE ACTS AND OMISSIONS OF THE SURVEYOR AND HIS EMPLOYEES AND TO THE ACCURACY OF THE INSTRUMENTS AND EQUIPMENT USED
NO ADDITIONAL INSTRUMENTS OR SURVEYS