


ALL LOTS AS SHOWN ON MAP OF  
HAMPTON MEADOWS (SECTION ONE)  
FILED MARCH 14, 1978, AS MAP  
NUMBER 6657

TAX MAP  
DISTRICT 0900  
SECTION 369  
BLOCK 3  
LOT 57.44

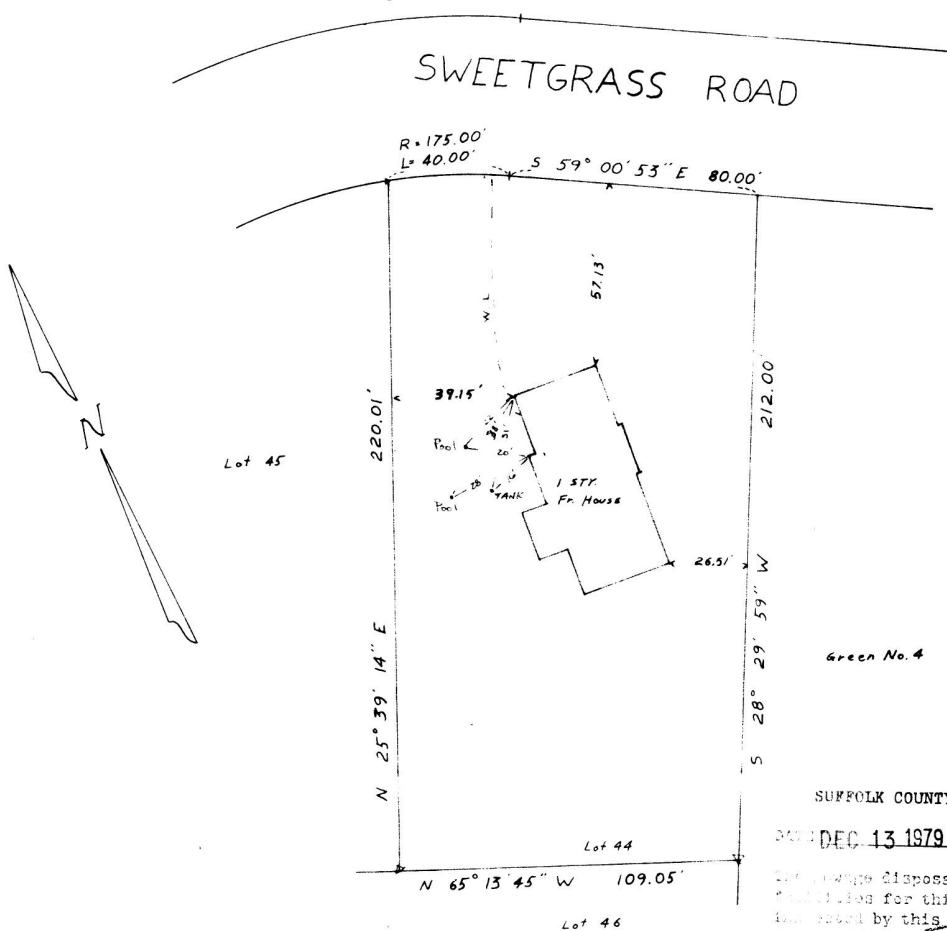

Green No. 4

SUFFOLK COUNTY HEALTH DEPARTMENT

DEC 13 1979 H. D. REF. #9-SH-243

The sewage disposal and water supply  
facilities for this location have been  
inspected by this department and found  
to be satisfactory.

*Robert A. Vella*

Chief of General Engineering  
Services

# MAP OF PROPERTY

WESTHAMPTON  
TOWN OF SOUTHAMPTON  
SUFFOLK COUNTY, N.Y.  
SURVEYED: JUNE 28, 1979 SCALE: 1 INCH = 40 FEET  
UNDER CONSTRUCTION: SEPT. 13, 1979  
FINAL: NOV 23, 1979

DEC 13 PM 12 25

DEPARTMENT OF HEALTH

C5945

SEPTIC AND WATER LINE LOCATION  
BY OTHERS

CERTIFIED TO:  
SOUTHOLD SAVINGS BANK  
ISLAND ABSTRACT INC.  
CHICAGO TITLE INSURANCE CO.

Pa 37  
C. M. RAYNOR  
LICENSED LAND SURVEYOR  
QUOGUE NY

AREA 24,898 ±  
ACRE:

C.M. Raynor LS 36187