


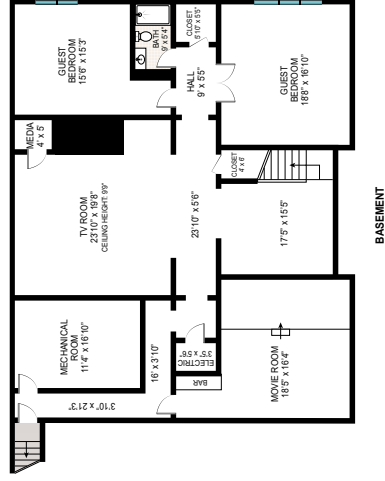

FIRST FLOOR: 2700 ft²
SECOND FLOOR: 2530 ft²
LOWER LEVEL: 2240 ft²
TOTAL: 7470 ft²
GARAGE: 470 ft²

Scale in feet. Indicative only. Dimensions are approximate. All information contained herein is gathered from sources we believe to be reliable. However, we cannot guarantee its accuracy and interested persons should rely on their own enquiries.

SURVEY OF PROPERTY
PROPERTY LOCATED AT SAGAPONACK
LOT No. 5
MAP OF EAST WOODS AT WAINSCOTT
FILED: MAY 3, 1988; FILE No. 8520
TOWN OF SOUTHAMPTON
SUFFOLK COUNTY, NEW YORK
S.C.T.M. # 900-056-03-5
AREA = 58.176 SF. = 1.3355 ACRES
SCALE: 1"=50'

NOTE: THE EXISTENCE OF RIGHTS OF WAYS,
WETLANDS AND/OR EASEMENTS OF RECORD
IF ANY, NOT SHOWN ARE NOT GUARANTEED.
PROPERTY ZONED: CR-60 (PER FILED MAP)
AQUIFER PROTECTION OVERLAY DISTRICT

NOTE: SEPTIC SYSTEM LOCATION BY OTHERS
WELL LOCATION BY SURVEYOR
B.O.H. REF. No. R08-11-0077
WELL & SEPTIC LOCATION

	"A"	"B"	"C"	"D"
S.T.	11.5'	14.1'		
L.P. 1	32'	32'		
L.P. 2	35'			
WELL				

NOV 23 2011
H.S. BARYLSKI
R08-11-0077
The property shown and well survey at this location have been
inspected and approved by the Department of Health Services and found to
be satisfactory for a single family residence and 2 bedrooms.

Office of Wastewater Management
Walter J. Hilbert, P.E., Chief
Office of Wastewater Management

SUFFOLK COUNTY DEPARTMENT OF HEALTH SERVICES
APPROVAL OF CONSTRUCTED WORKS FOR
A SINGLE FAMILY RESIDENCE AND
2 BEDROOMS




UNAUTHORIZED ALTERATION OR ADDITION TO THIS SURVEY IS A VIOLATION
OF SECTION 2209 OF THE NEW YORK STATE EDUCATION LAW.

COPIES OF THIS SURVEY MAP NOT BEARING THE LAND SURVEYORS INKED
OR EMBOSSED SEAL SHALL NOT BE CONSIDERED TO BE A VALID TRUE COPY.

GUARANTEES OR CERTIFICATIONS INDICATED HEREON SHALL RUN ONLY TO
THE PERSON FOR WHOM THE SURVEY IS PREPARED AND ON HIS BEHALF TO
THE TITLE COMPANY, GOVERNMENT AGENCY AND LENDING INSTITUTION.
GUARANTEES OR CERTIFICATIONS ARE NOT TRANSFERABLE TO ADDITIONAL
INSTITUTIONS OR SUBSEQUENT OWNERS.

2302-1H1

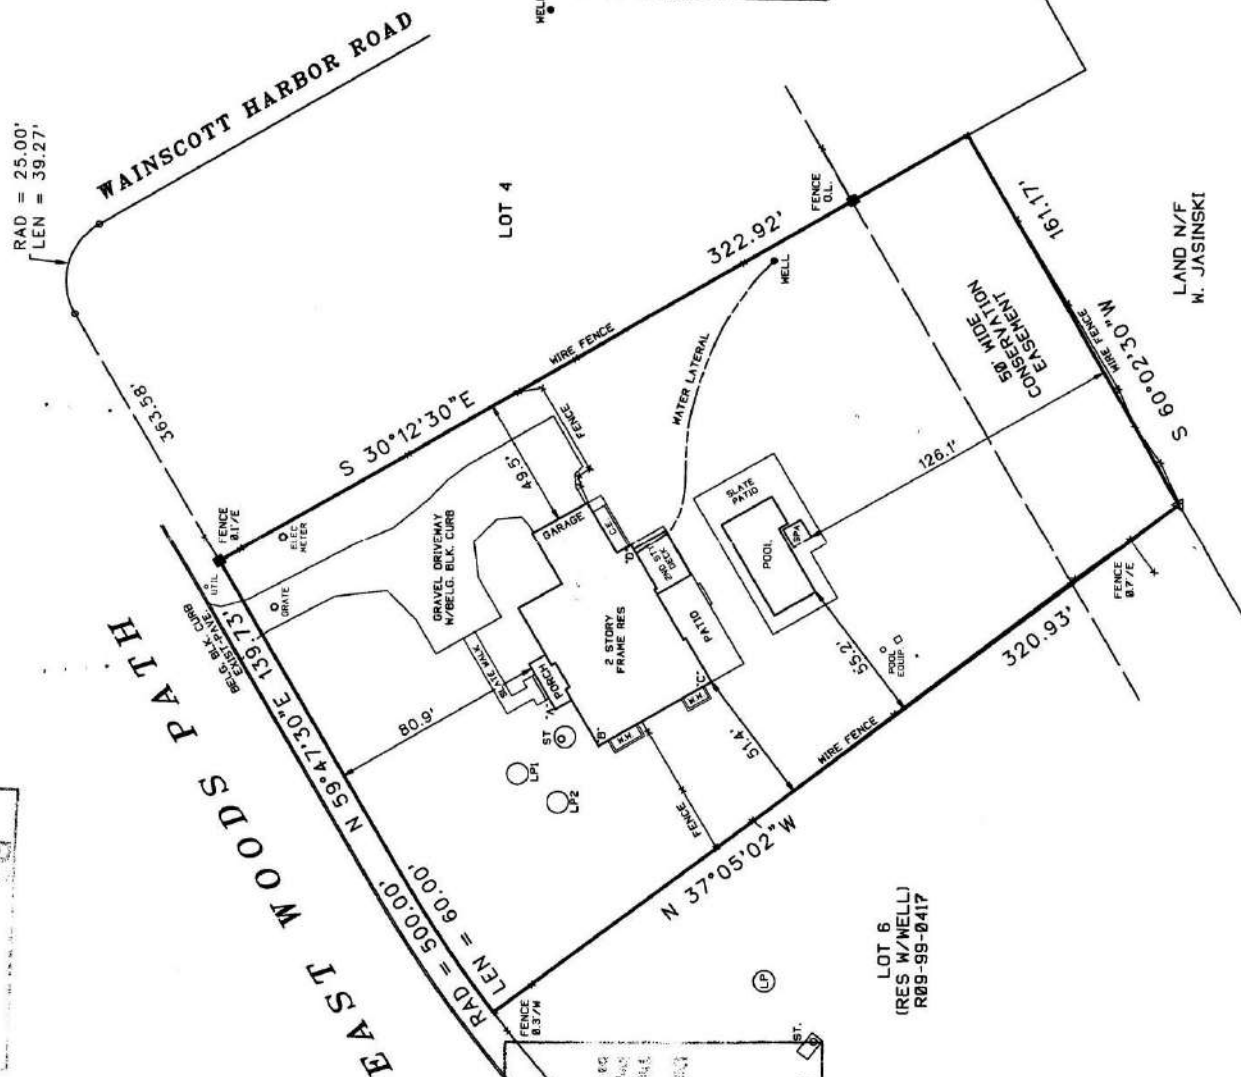

NOV 23 2011

The sewage disposal and well supply facilities at this location have been
inspected and approved by the Department of Health Services and found to
be satisfactory for a single family residence and 2 bedrooms.

Walter J. Hilbert, P.E., Chief
Office of Wastewater Management

SURVEYED BY:
STEVEN BARYLSKI
N.Y.S. Lic. No. 050453
41 MEETING HOUSE LANE
SOUTHAMPTON, N.Y. 11968
MARCH 9, 2011

3-11-2011: ADD SITE PLAN
4-1-2011: REVISED SITE PLAN
4-22-2011: STAKEOUT HOUSE
10-12-2011: FINAL SURVEY
11-15-2011: ADD NEIGHBORING
WELL AND SANITARY.