

Title No. 647 - S - 1904

DISTRICT	0900
SECTION	028.000
BLOCK	01.00
PARCEL	041.000

■ INDICATES MONUMENT

SINGLE FAMILY DWELLING ONLY

Approval of Constructed Works

Date JUN 29 1995 H.S. Ret. No. 100-100000

NOTED: The sewage disposal and water supply facilities at this location have been inspected and/or WELL: confirmed by this OCA/OPS. PER: other agencies S.C.H. No. 109-540031. It is found to be satisfactory.

Stephen A. Costa

Stephen A. Costa, P.E., Chief
Office of Water and Wastewater Management

Certified To:
Colin W. & Susan Brown
First American Title Insurance Company of N.Y.


SURVEYED: DEC. 6, 1993
REVISED: April 27, 1995 (final)

LESTER HOLDEN U.S. No. 49548

SQUIRES, HOLDEN, WEISENBACHER & SMITH

LAND SURVEYORS ENGINEERS

SOUTHAMPTON NEW YORK

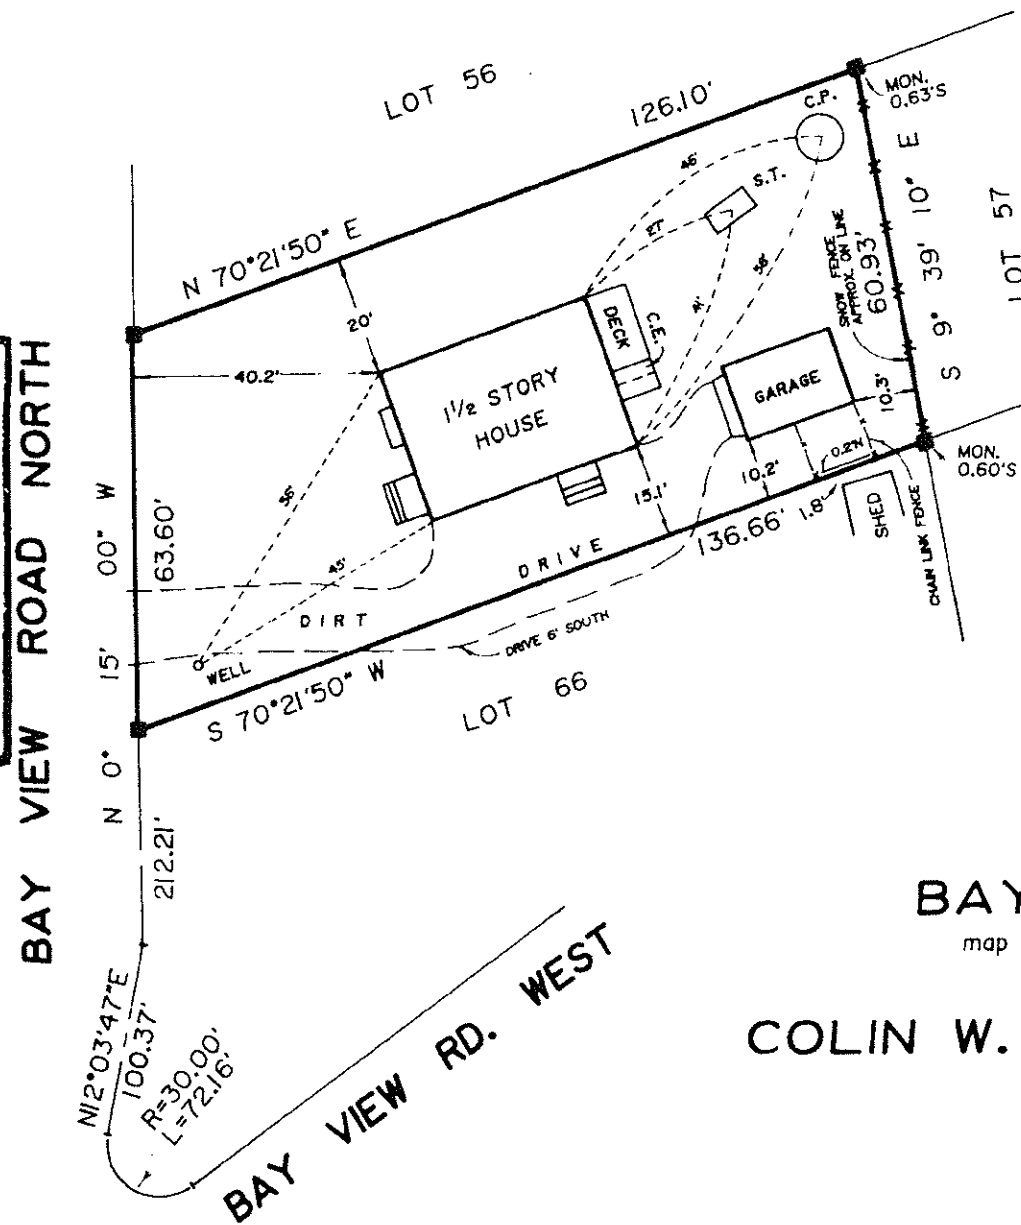

SURVEY OF LOT No. 67
SUBDIVISION MAP OF

BAY VIEW OAKS

map no. 1594 - filed: Dec. 12, 1947

FOR

COLIN W. & SUSAN BROWN

SITUATE

NOYACK

TOWN OF SOUTHAMPTON
SUFFOLK COUNTY, N.Y.

SCALE: 1" = 30'

AREA= 7,884 S.F. (0.181 ACRE)

RECEIVED

MAY 9 1995

S.C. DEPT. OF
HEALTH SERVICES