

3419⁻³ B7150

SUFFOLK COUNTY TAX MAP

DISTRICT: 0900
SECTION: 272.00
BLOCK: 01.00
PARCEL: 021.6

C-9708

NOTE:

SUBJECT PREMISES
CONSISTS OF PARCEL
NO. 3, AS SHOWN ON MINOR
SUBDIVISION OF JOHN W.
OLSON.


UNAUTHORIZED ALTERATION OR ADDITION
TO THIS SURVEY IS A VIOLATION OF
SECTION 7209 OF THE NEW YORK STATE
EDUCATION LAW.

COPIES OF THIS SURVEY
THE LAND SURVEYOR'S SEAL AND
EMBOSSED SEAL SHALL BE KEPT
TO BE A VALID TRUE COPY

GUARANTEES INDICATED HEREIN ARE NOT
ONLY TO THE PERSON FOR WHOM THE SURVEY
IS PREPARED, AND OF HIS BEHALF TO THE
TITLE COMPANY, INTERMEDIATE AGENCY AND
LENDING INSTITUTION, AND TO THE ASSIGNEE OF THE LENDING INSTI-
TUTION. GUARANTEES ARE NOT TRANSFERABLE
TO ADDITIONAL INSTITUTIONS OR SUBSEQUENT
OWNERS.

SURVEYED: SEPT. 13, 1984
(UNDER CONSTRUCTION)
SURVEYED: OCT. 7, 1985 (FINAL)
REVISED: JAN. 21, 1986 (WELL)

Carl W. Weisenbacher
SQUIRES, HOLDEN,
WEISENBACHER & SMITH
LAND SURVEYORS - ENGINEERS
SOUTHAMPTON, N.Y.

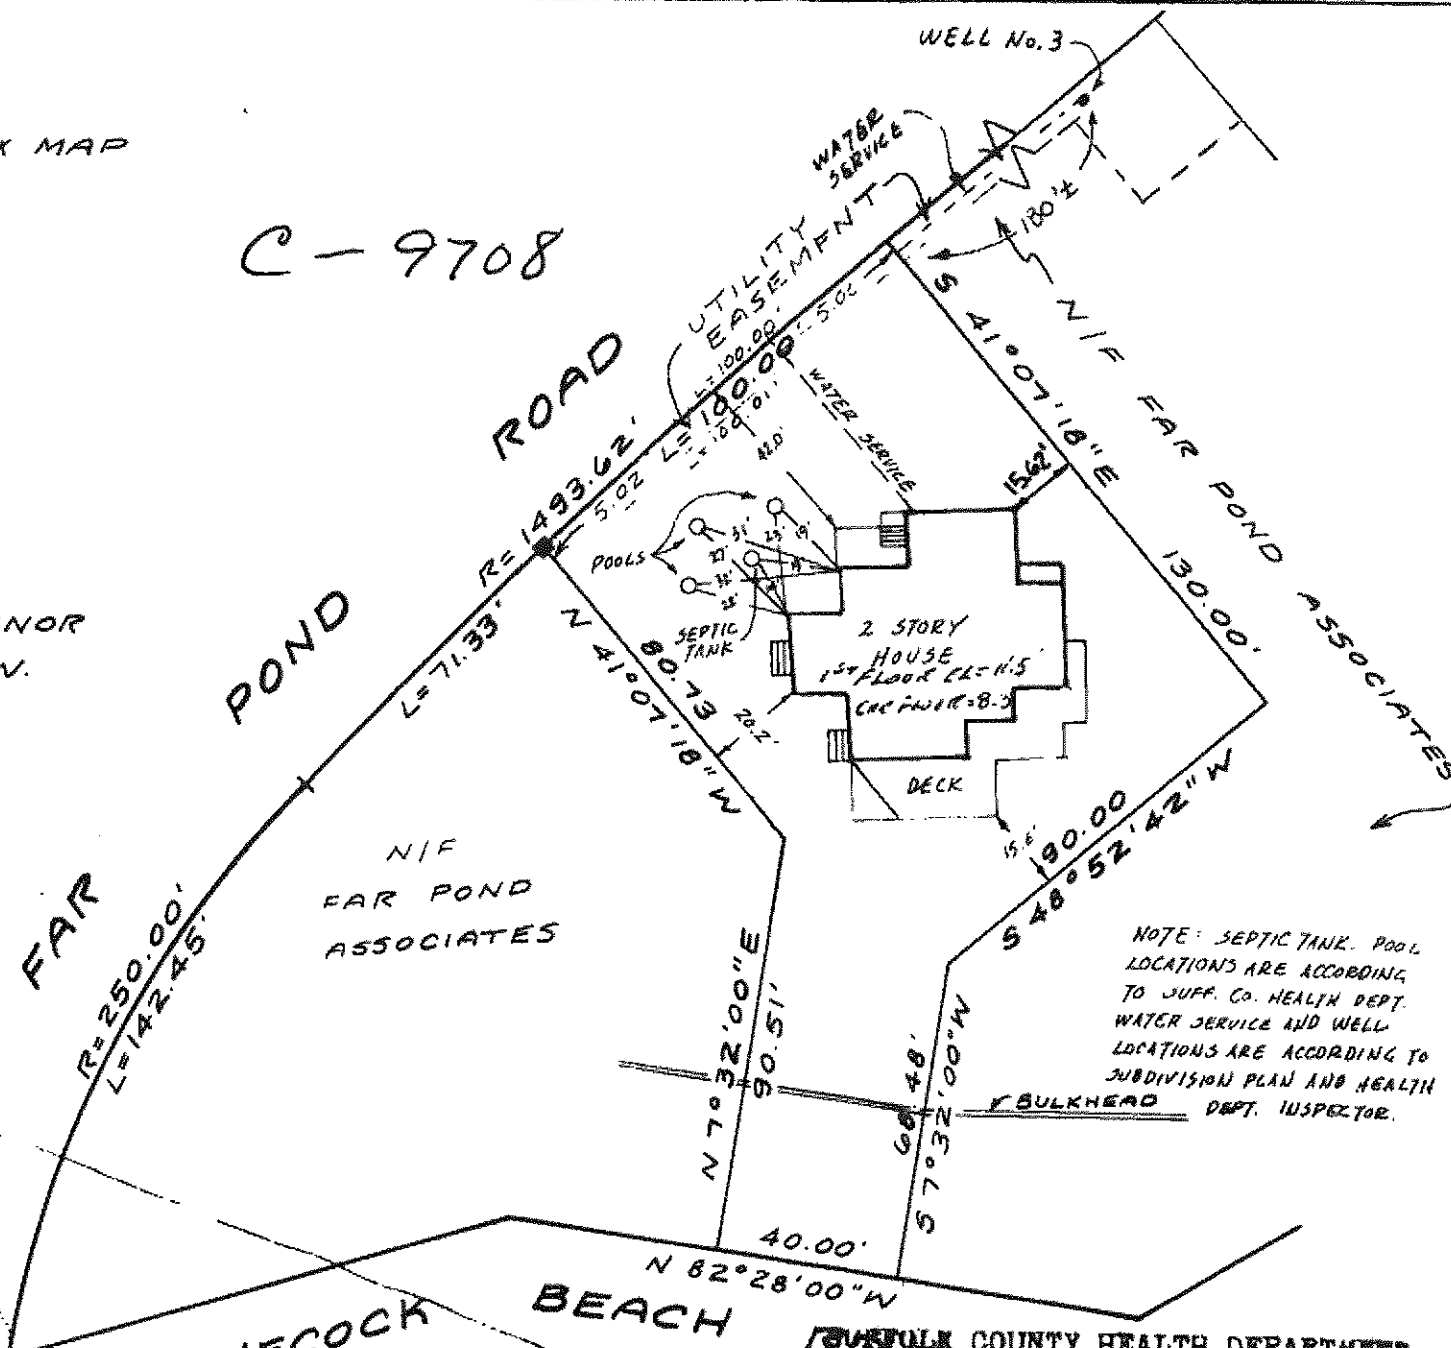

CERTIFIED TO:

• THE CHICAGO TITLE INS. CO.
IN ACCORDANCE WITH THE
MIN. STANDARDS FOR TITLE
SURVEYS OF THE N.Y. STATE
ASSOC. OF PROFESSIONAL
LAND SURVEYORS
• SOUTHOLD SAVINGS BANK
• CHARLES THOMPSON &
DARIOUSH TORABY

HEALTH DEPT. REF. NO. - 13-SH-19

APPLICANT: DARIUS TORABY
242 W. 27TH ST.
N.Y., N.Y.
10001
TEL: 212-242-2955

MAP OF PART OF LOT NO. 6
BLOCK 127
AMENDED MAP "A"
WESTERLY PART OF

SHINNECOCK HILLS

MAP NO. 213 ~ FILED: OCT. 22, 1925
for

CHARLES THOMPSON &
DARIOUSH TORABY

SITUATE

SHINNECOCK HILLS

TOWN OF SOUTHAMPTON

SUFFOLK COUNTY N.Y.

SCALE: 1" = 50'

AREA = 15.766 Sq. Ft.)

SUFFOLK COUNTY HEALTH DEPARTMENT

DATE FEB 11 1986

H. D. REF. #13SH-19

The sewage disposal and water supply
facilities for this property have been
inspected by the health department and found
to be satisfactory.

Chief of General Engineering

INDICATES MONUMENT

BOOK - PAGE
464 77

SHINNECOCK

BEACH

