


AGRICULTURAL RESERVE

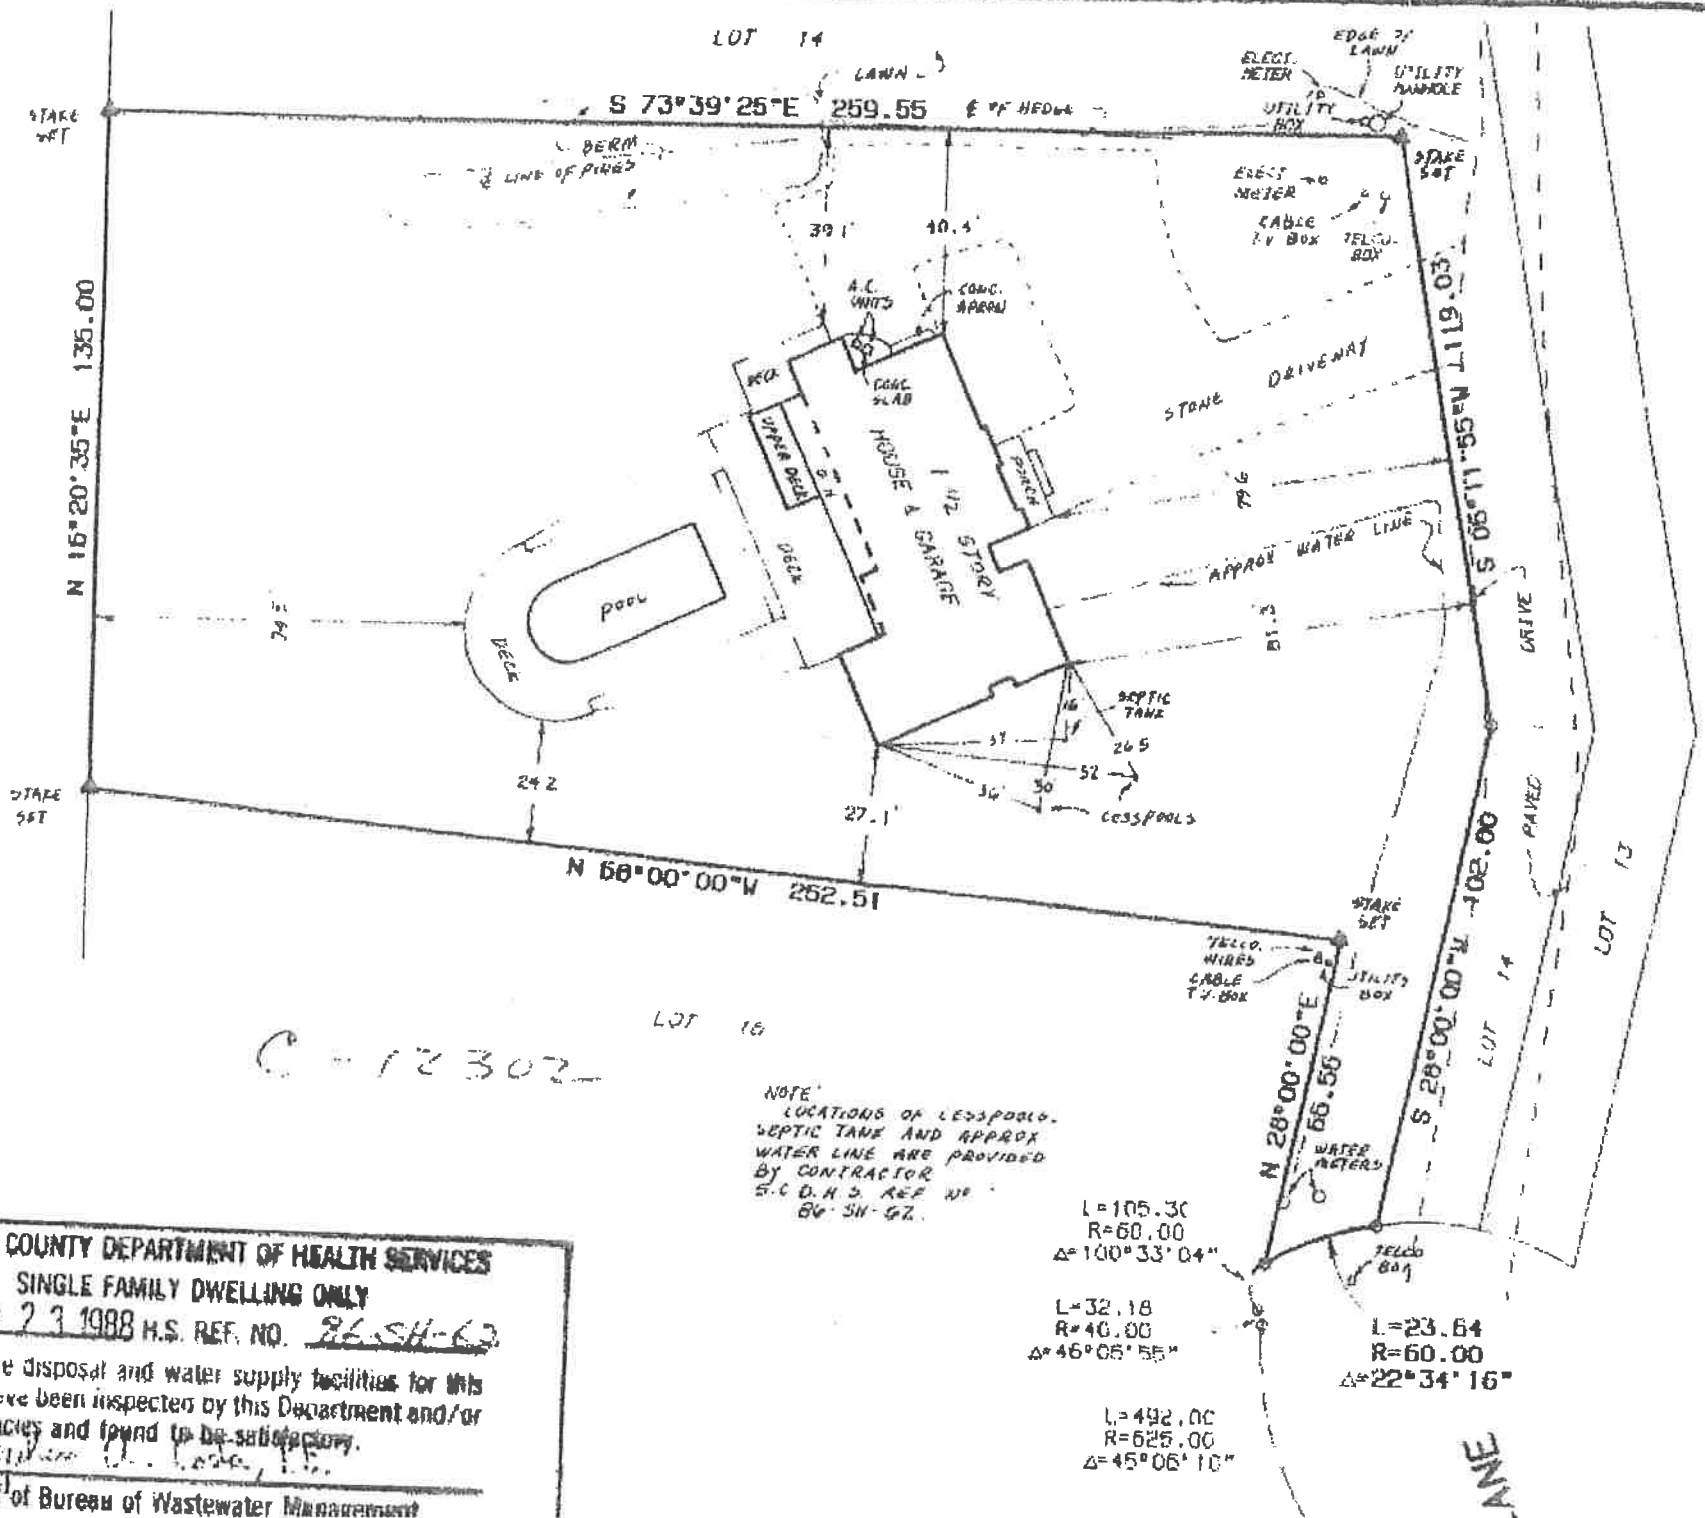

SUFFOLK COUNTY DEPARTMENT OF HEALTH SERVICES

SINGLE FAMILY DWELLING ONLY

DATE SEP 23 1988 H.S. REF. NO. 86-SH-62

The sewage disposal and water supply facilities for this location have been inspected by this Department and/or other agencies and found to be satisfactory.

Chief of Bureau of Wastewater Management