


FILE NO. C-2273

TITLE NO. S-521482

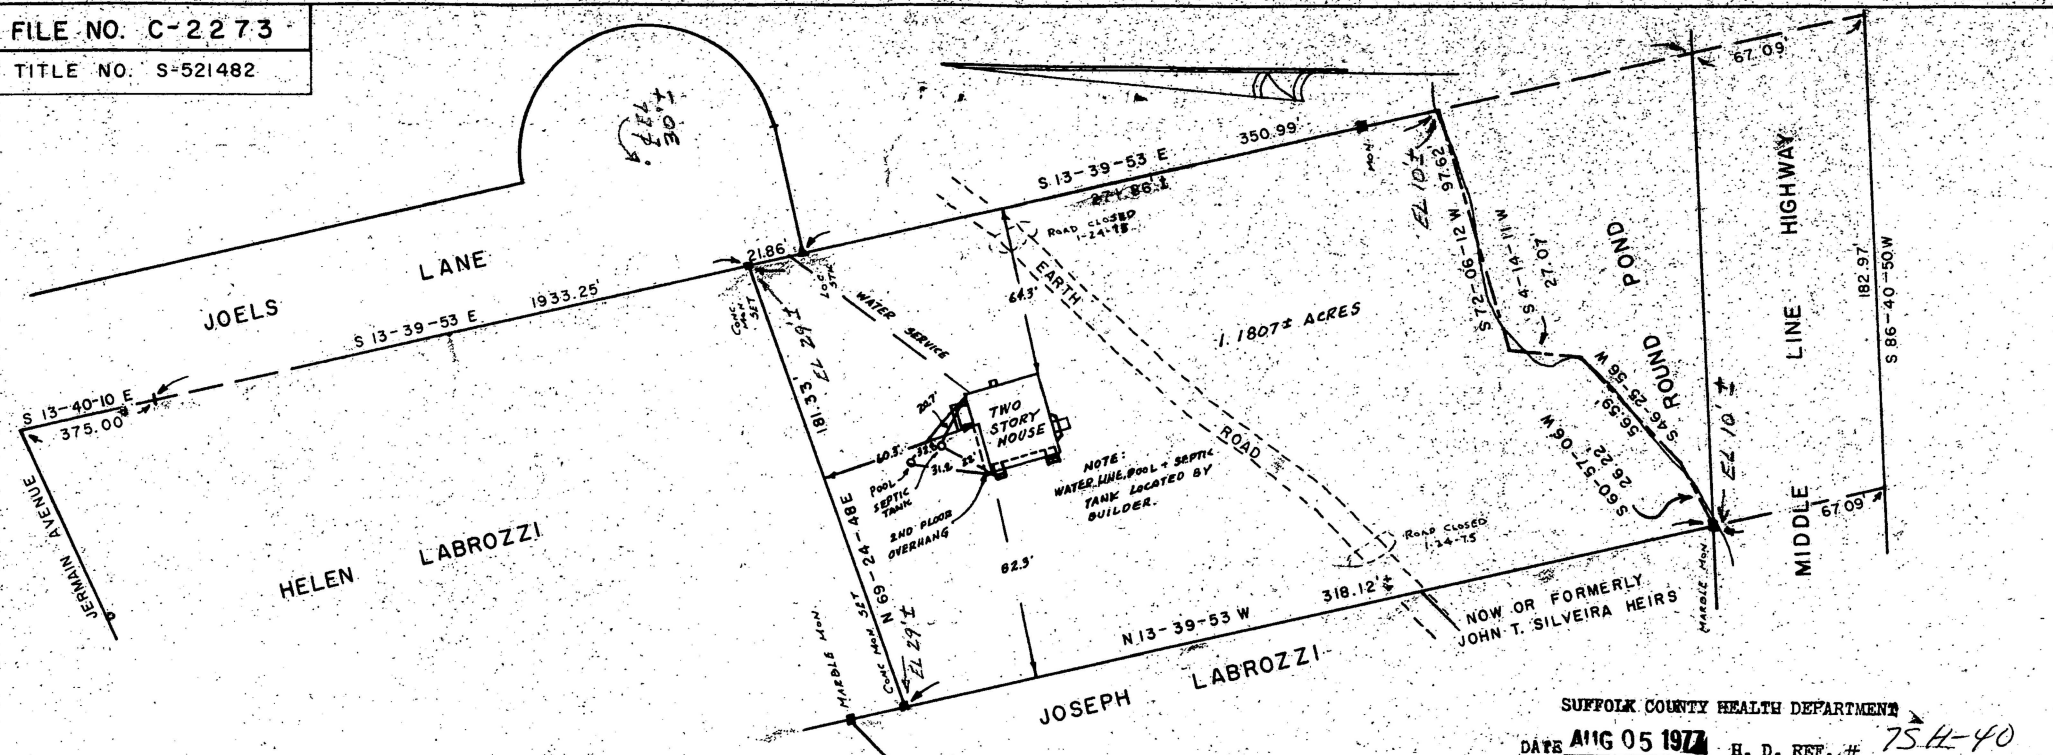

MAP OF PROPERTY
FOR

ANTONIO L. & DIANNE M. GIL, JR.

SITUATE
INC. VILLAGE OF SAG HARBOR
TOWN OF SOUTHAMPTON
SUFFOLK COUNTY N.Y.

GUARANTEED TO
SECURITY TITLE & GUARANTY CO.
SAG HARBOR SAVINGS BANK

SURVEYED MAY 21, 1974, NOVEMBER 20, 1974

SQUIRES & HOLDEN
Theodore F. Squires
THEODORE F. SQUIRES
LIC. LAND SURVEYOR 15683
SOUTHAMPTON, N.Y.

REDATED JAN. 24, 1975; MONUMENTS SET MAR. 7, 1975
REDATED: FEB. 25, 1977 (U.C.)
REDATED: JULY 8, 1977 (FINAL)

ELEVATIONS BASED ON U.S.C. & G.S.
MEAN SEA LEVEL DATUM 1929.

SUFFOLK COUNTY HEALTH DEPARTMENT

DATE AUG 05 1974 H. D. REF. # 75-H-40

The sewage disposal and water supply
facilities for this location have been
inspected by this department and found
to be satisfactory.

Robert A. Villa
Chief of General Engineering
Services



UNAUTHORIZED ALTERATION OR ADDITION
TO THIS SURVEY IS A VIOLATION OF
SECTION 7209 OF THE NEW YORK STATE
EDUCATION LAW.

COPIES OF THIS SURVEY MAP NOT BEARING
THE LAND SURVEYOR'S INKED SEAL OR
EMBOSSED SEAL SHALL NOT BE CONSIDERED
TO BE A VALID TRUE COPY.

GUARANTEES INDICATED HEREON SHALL RUN
ONLY TO THE PERSON FOR WHOM THE SURVEY
IS PREPARED, AND ON HIS BEHALF TO THE
TITLE COMPANY, GOVERNMENT AGENCIES AND
LENDING INSTITUTION LISTED HEREON, AND
TO THE ASSIGNEES OF THE LENDING INSTI-
TUTION. GUARANTEES ARE NOT TRANSFERABLE
TO ADDITIONAL INSTITUTIONS OR SUBSEQUENT
OWNERS.

77 AUG 5 1974

SCALE 1"=50'

DEPARTMENT OF HEALTH

BOOK PAGE
318 87-89, 118
366 40