


RD 3-95-0276

Permitted - 21,500 sq. Ft.
As Built - 11,900± sq. Ft. ± 21100
Proposed - 3,000± sq. Ft.
(1001)
Total Proposed 14,900± sq. Ft.

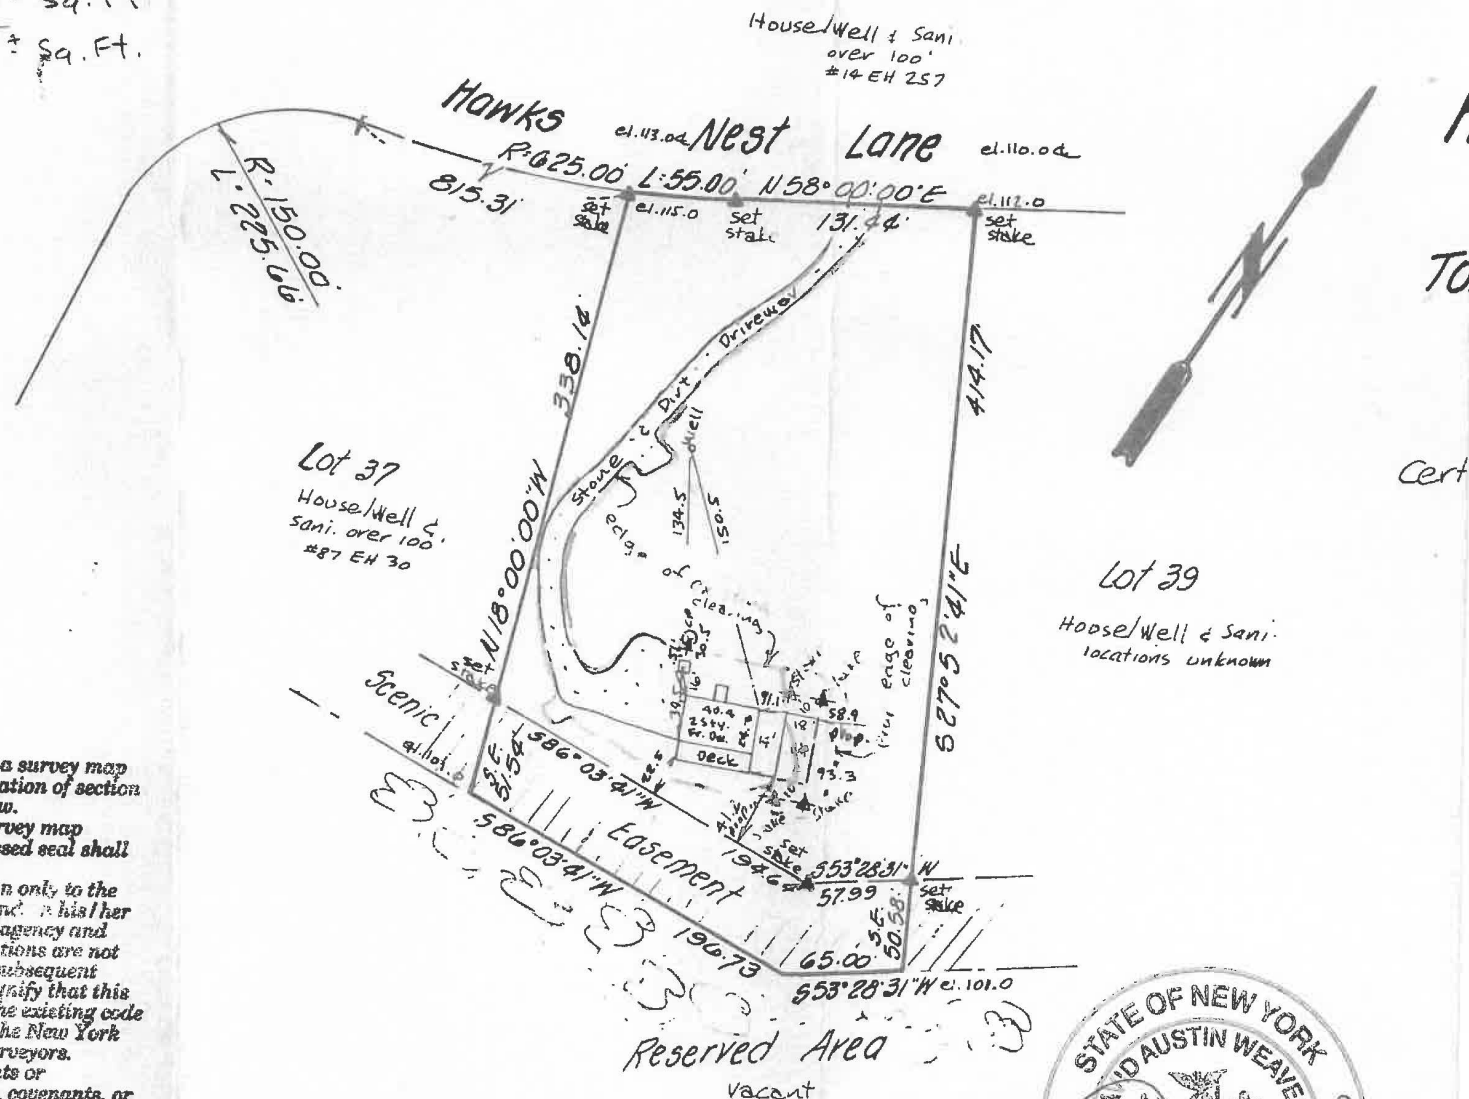

Unauthorized alteration or addition to a survey map
ing a licensed surveyor's seal is a violation of section
of the New York State Education Law.
Only copies from the original of this survey map
ing an original land surveyor's embossed seal shall
nsidered to be a valid copy.
Certifications indicated hereon shall run only to the
for whom the survey is prepared, and to his/her
o the title company, governmental agency and
institution listed hereon. Certifications are not
rable to additional institutions or subsequent
rs. Certifications indicated hereon signify that this
was prepared in accordance with the existing code
actice for land surveyors adopted by the New York
s Association of Professional Land Surveyors.
he existence of subsurface improvements or
rochments, or wetlands, or easements, covenants, or
estrictions of record, if any, not shown are not certified.

Datum: v.s.c. e G.S.

S.C.T.M. 0300-151-04-07

