


NOTE: LOCATIONS OF WELLS AND CESSPOOLS ARE NOT CERTIFIED TO BE CORRECT.

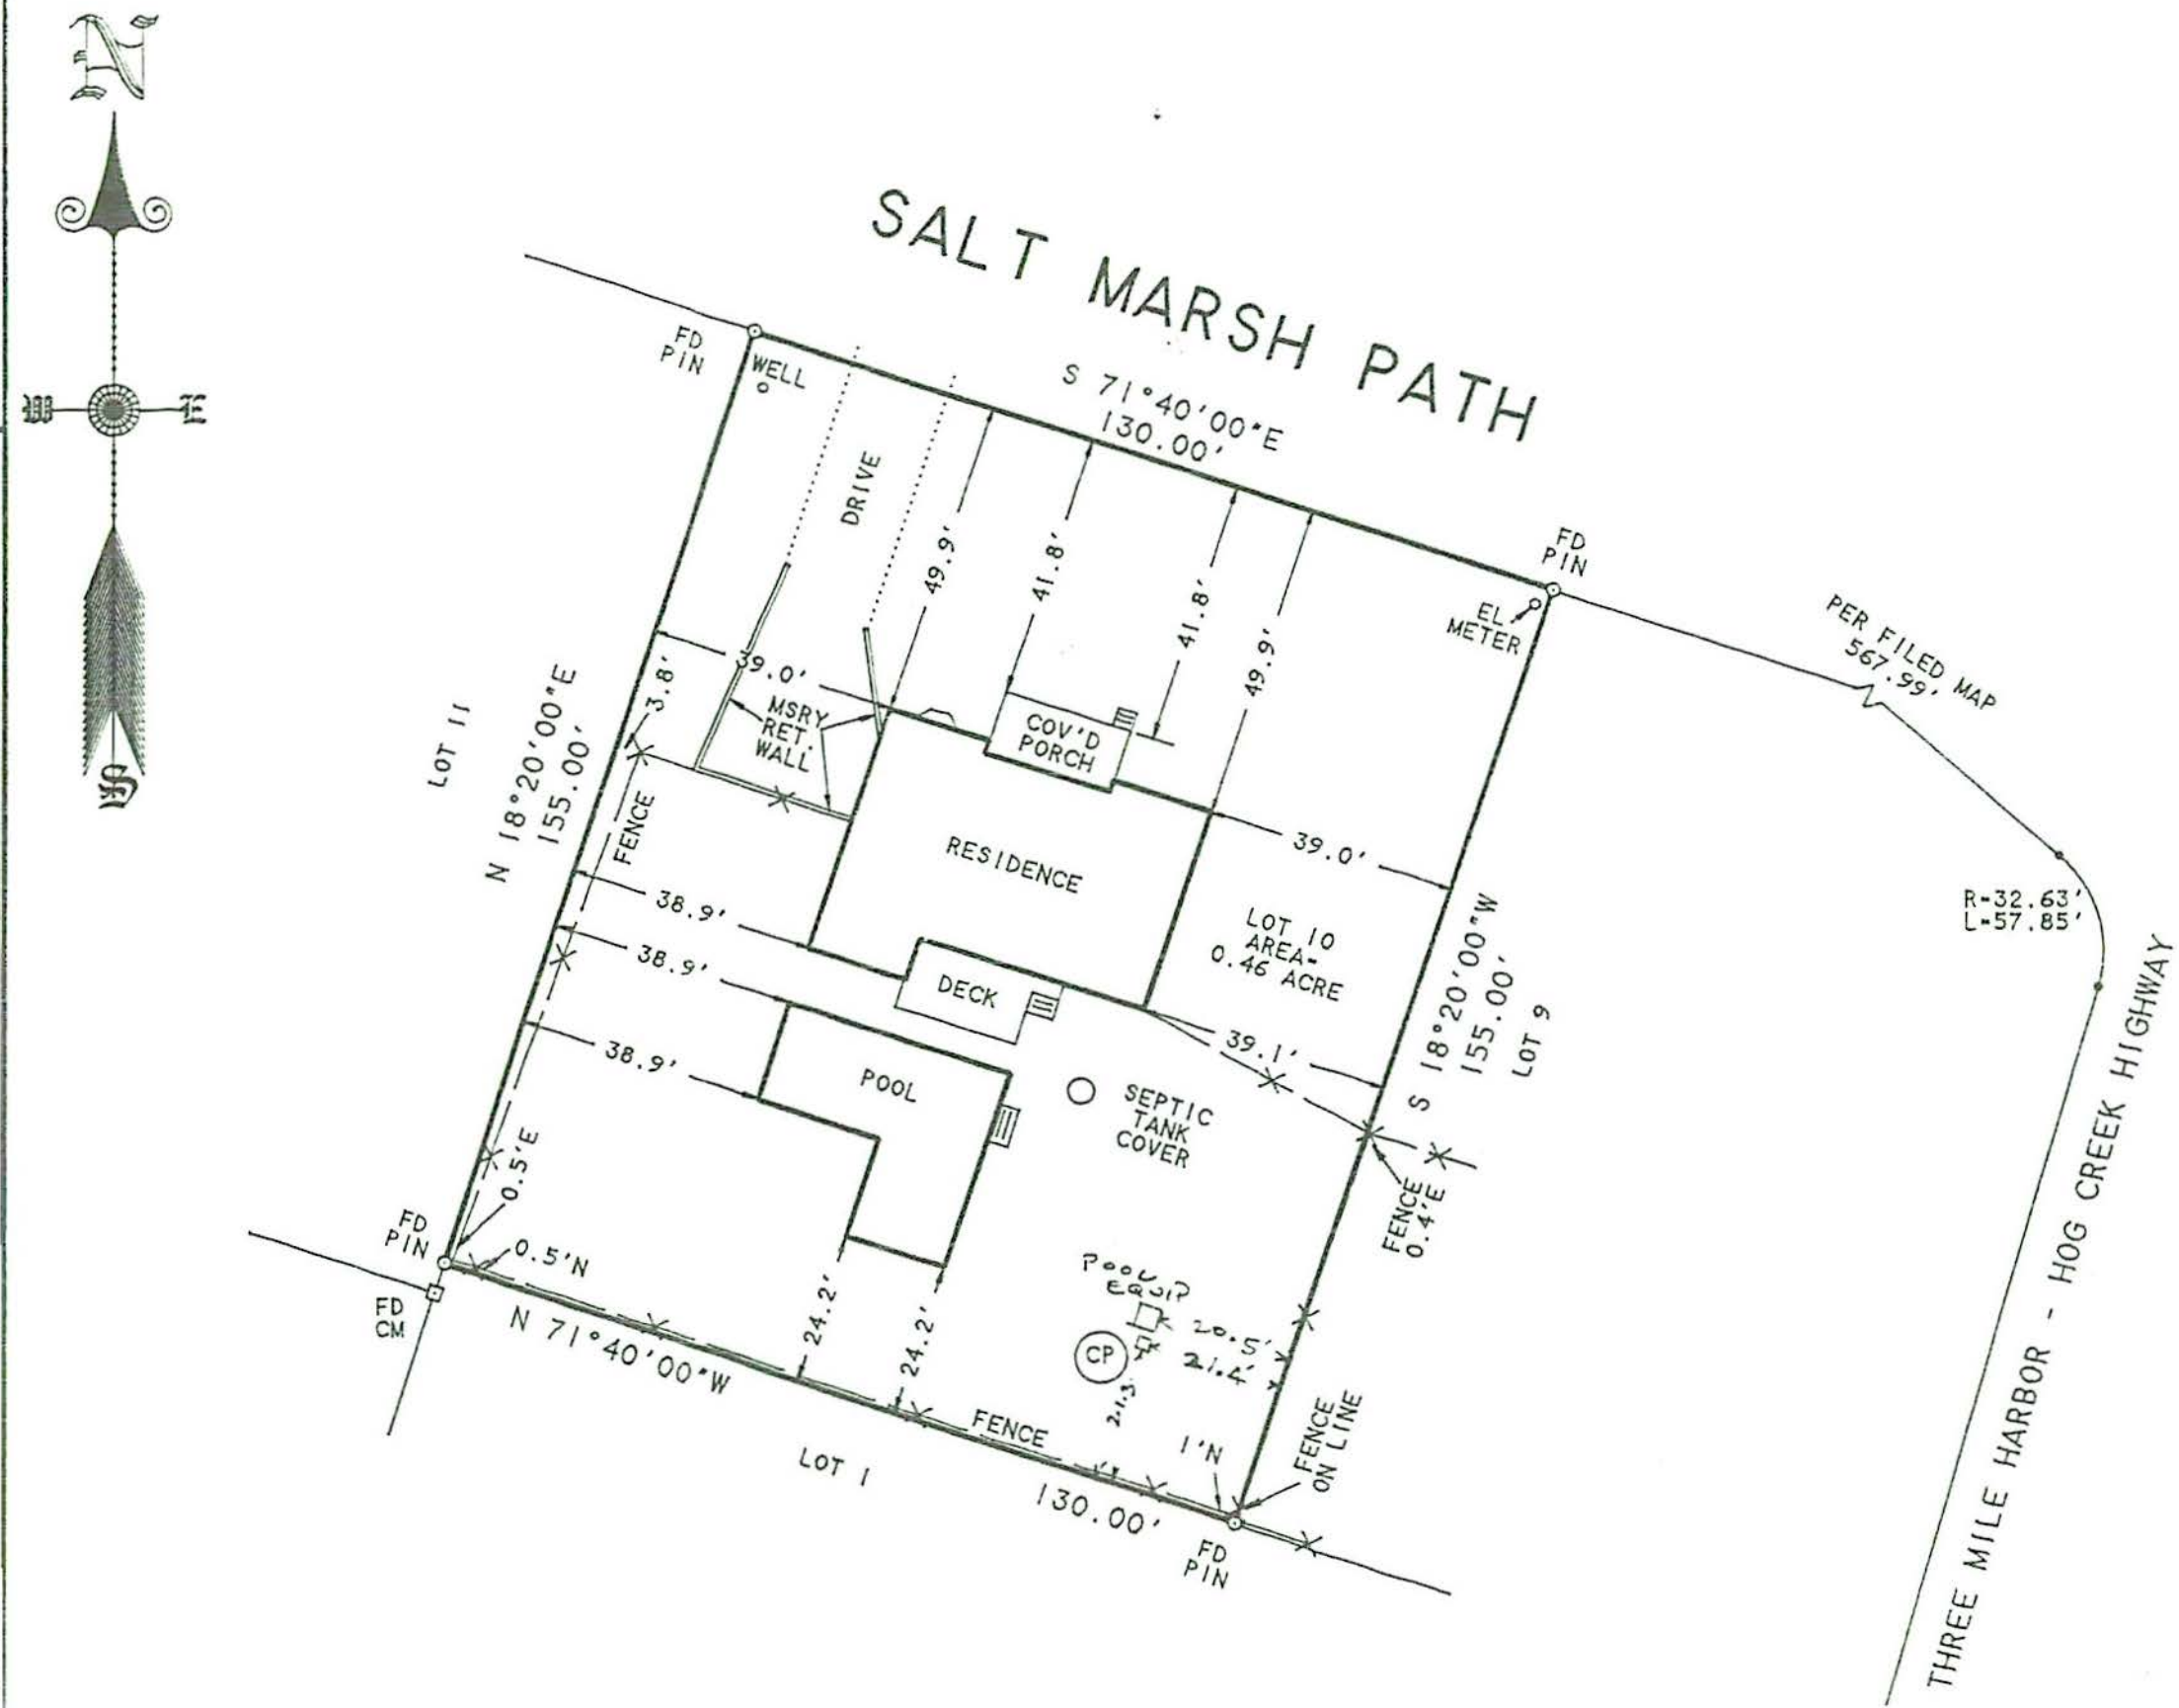

REVISED: DECEMBER 16, 1996 "POOL EQUIP. MOVED"

SURVEYED: DECEMBER 10, 1996