


EAST MORICHES BLVD.

B.O.M. NO. 88 - BR - 119

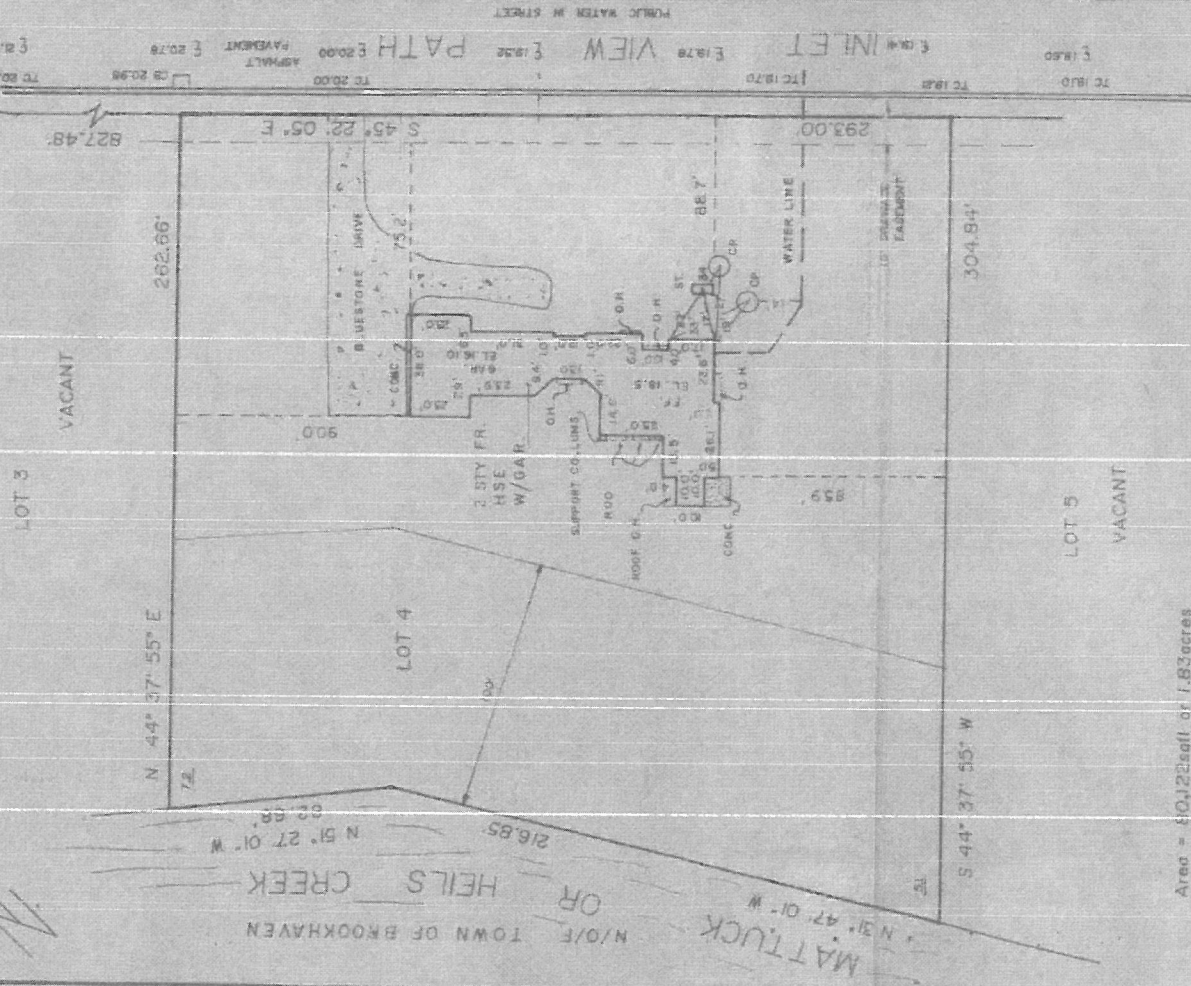

Area = 60.22± sq ft or 1.83± acres

CERTIFIED TO
THOMAS LONANTO
FIRST AMERICAN TITLE INSURANCE COMPANY OF NEW YORK
SOUTHOLD SAVING BANK
ACQUEDAGUE ABSTRACT CORPORATION
TITLE NO 532 S 1146

SUFFOLK COUNTY DEPARTMENT OF HEALTH SERVICES
SINGLE FAMILY DWELLING ONLY
DATE OCT 22 1988 S. REF. NO. 88-BR-119
This sewage disposal and water supply facilities for this location have been inspected by this Department and/or other agencies and found to be satisfactory.
[Signature]
Chief of Bureau of Wastewater Management

Suffolk County Reference #
88 BR 119

SURVEY OF
LOT 4
MAP OF
BAYWOOD SEC ONE
FILED NOV. 21, 1984 FILE NO. 7800
AT EAST MORICHES
TOWN OF BROOKHAVEN
SUFFOLK COUNTY, N.Y.
0200 - 759 - 06 - 04
Scale 1" = 50'
Sept. 8, 1987
MAR. 9, 1988
JUNE 2, 1988 (FEDERATION)
SEPT. 21, 1988 (FINAL)

RECEIVED
OCT 18 1988
S.C. DEPT. OF
HEALTH SERVICES



JOSEPH A. MEEGANO
LICENSED LAND SURVEYOR
No. 1068
N.Y.S. LIC. NO. 4966R
P.O. BOX 903
MAIN ROAD
L.I. CITY, N.Y. 11548

Convenience Copy Do Not Rescan

Prepared in accordance with the minimum standards for title surveys as established by the L.I.A.L.S. and approved and adopted for such use by the New York State Land Surveyors' Association.

Printed from location on 10/25/2004 15:54:29 by SCIOLOMBARDO Please RESCAN material by N.Y. Mail on 11

87-178