

DEPARTMENT OF HEALTH
FISHHEAD, N.Y.

'73 OCT 9 PM 1:00

LOT 147

MAP OF

HAMPTON WATERS

SECTION No. 2

Filed May 25, 1962 as Map No. 3574
LOCATED AT THREE MILE HARBOR
TOWN OF EAST HAMPTON, SUFFOLK CO., N.Y.
Scale: 1" = 40'

NOTE:

The existence of right of ways and/or easements
of record, if any, not shown are not guaranteed.

Guaranteed to

Gloria M. Shapiro
Security Title & Guaranty Co.
Sag Harbor Savings Bank

STATE OF NEW YORK
COUNTY OF SUFFOLK
JULY 1973

ALL RIGHTS RESERVED
NO PART OF THIS MAP
SHALL BE REPRODUCED
WITHOUT THE WRITTEN
CONSENT OF THE
SURVEYOR

THIS MAP WAS PREPARED
FOR THE PURPOSE OF
RECORDING THE
PROPERTY LINES
AND EASEMENTS
OF THE ABOVE
DESCRIBED
PROPERTY

BY


Jeffrey James

Revised Sept 21, 1973

Revised April 20, 1973

Surveyed March 12, 1973

GEORGE H. WALBRIDGE, L.L.C.
Land Surveyors & Land Planners
East Hampton, L.I., New York

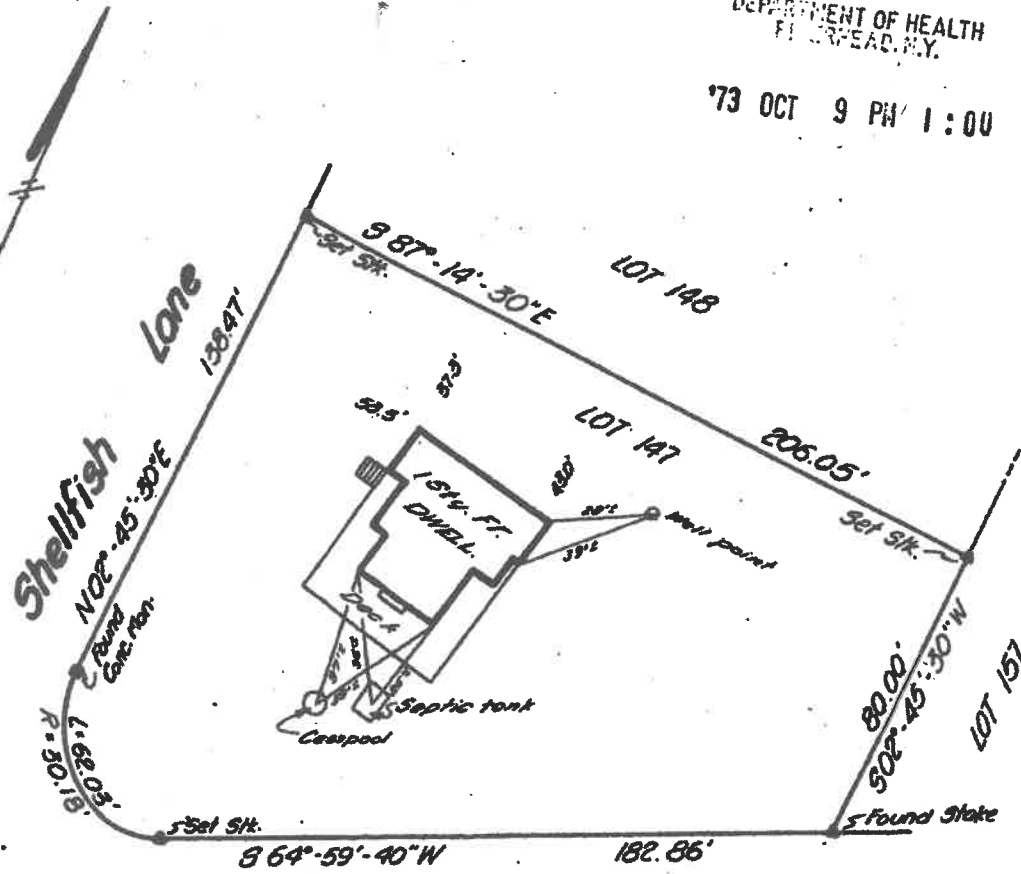

Oyster Pond Lane

SUFFOLK COUNTY HEALTH DEPARTMENT

DATE NOV 7 1973 H. D. REP. #EH-2295

The sewage disposal and other sanitary
facilities for this lot have been
inspected by this department and found
to be satisfactory.

Robert A. Vill

Chief or General Engineering
Services

Owner - Robert Shapiro
Bldr. - Island East
Const. Co.