

Olind Assoc.
46 Newtown Lane
East Hampton, N.Y. 11937
324-6262

TEST HOLE NO. 1
ground elevation 52.6'
sand 1'-4"
Red Sand 4'-5"
sand & Gravel 3'-7"
Ground Water El. 3.3'

SUFFOLK COUNTY HEALTH DEPARTMENT
DATE FEB 22 1979 H. D. REF. # 8-EH-19


LOT 94
SETTLER'S LANDING SEC. 1

FILED: June 17, 1966 as Map No. 4656

SITUATE

THREE MILE HARBOR, Town of East Hampton
SUFFOLK COUNTY, N.Y.

SCALE: 1" = 50'

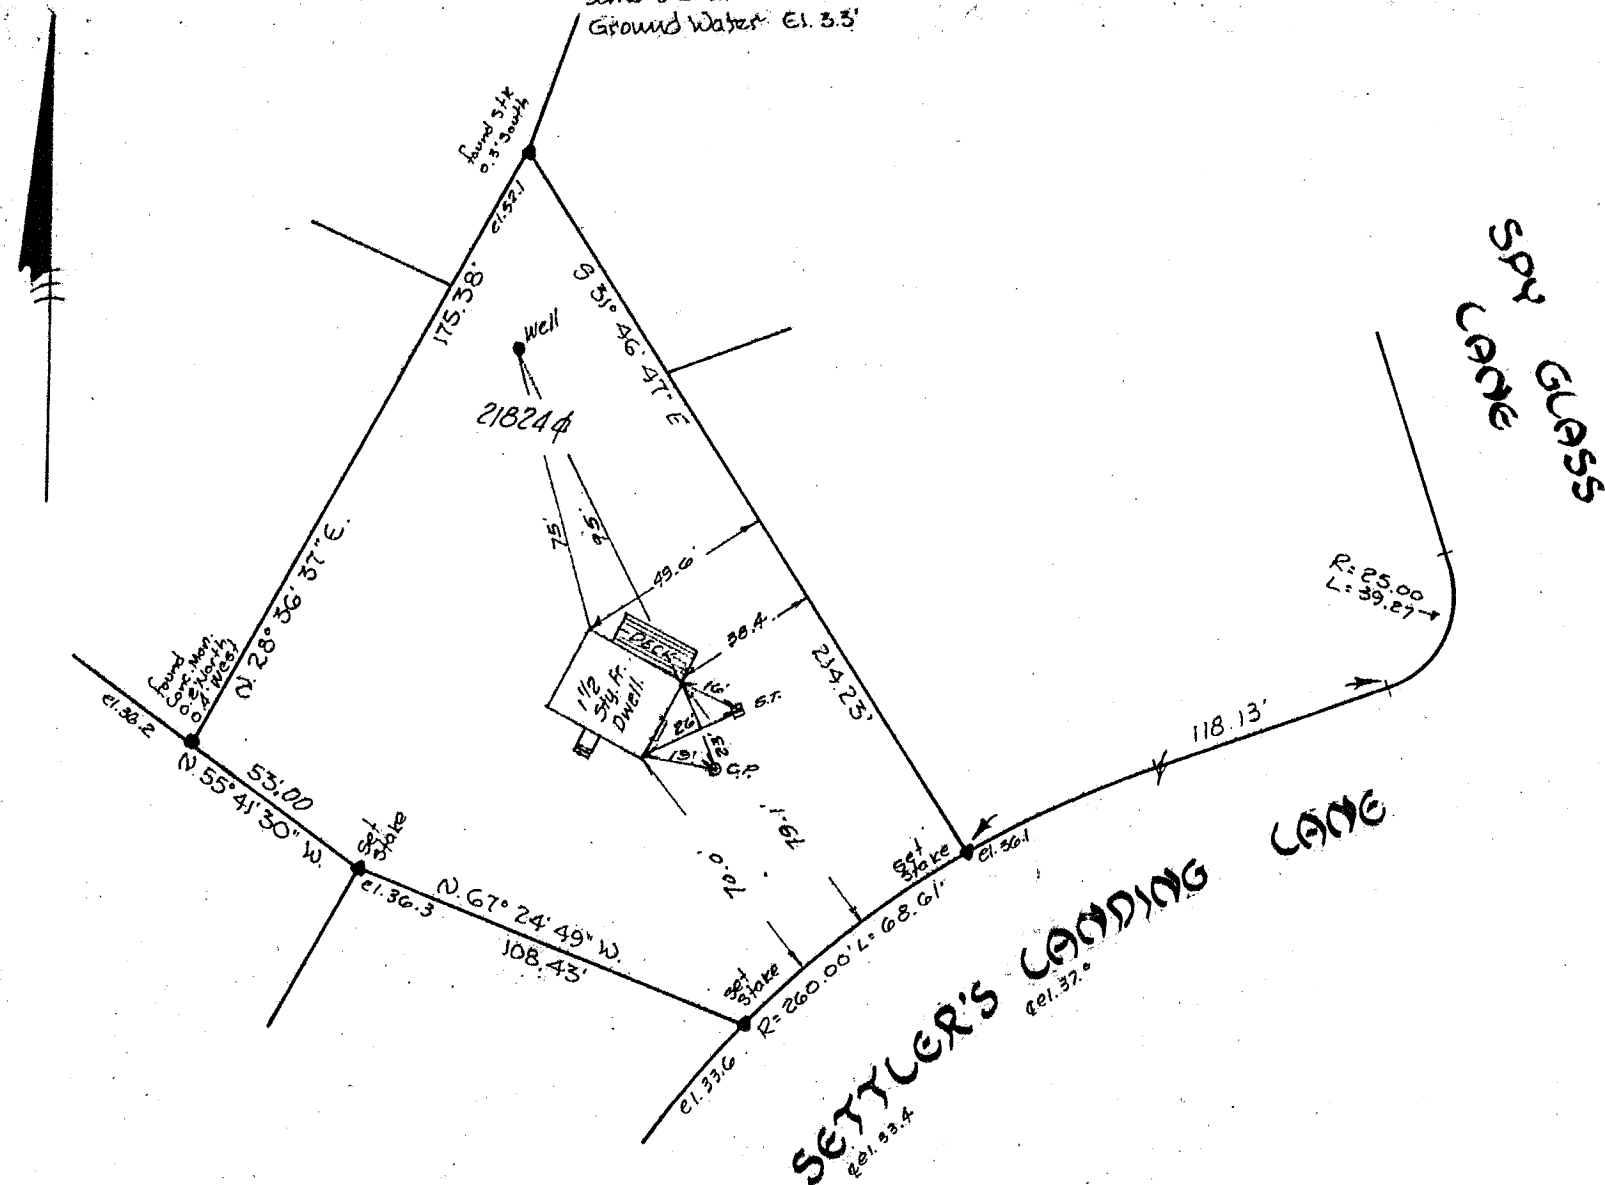

Note:

The existence of right of ways and/or easements of record, if any, not shown are not guaranteed.

Revised: Nov. 8, 1978 (Final)
Revised: July 5, 1978 (under const.)
Revised Feb 9, 1978 Area
Surveyed: January 31, 1978
GEORGE H. WALBRIDGE CO.
Land Surveyors & Land Planners
East Hampton, N.Y.

0300-074-01-31