
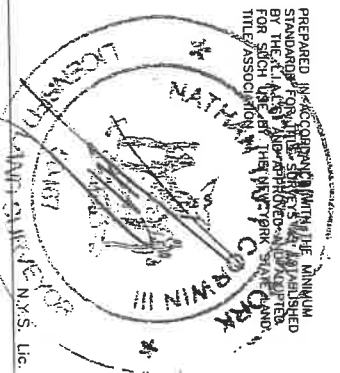


SURVEY OF PROPERTY
SITUATED AT
SHELTER ISLAND
TOWN OF SHELTER ISLAND
SUFFOLK COUNTY, NEW YORK
S.C. TAX No. 700-15-01-01
SCALE 1"=40'
JANUARY 30, 2006

AREA = 71,617.43 sq. ft.
1.644 ac.

FERRY ROAD (S.R. 114)

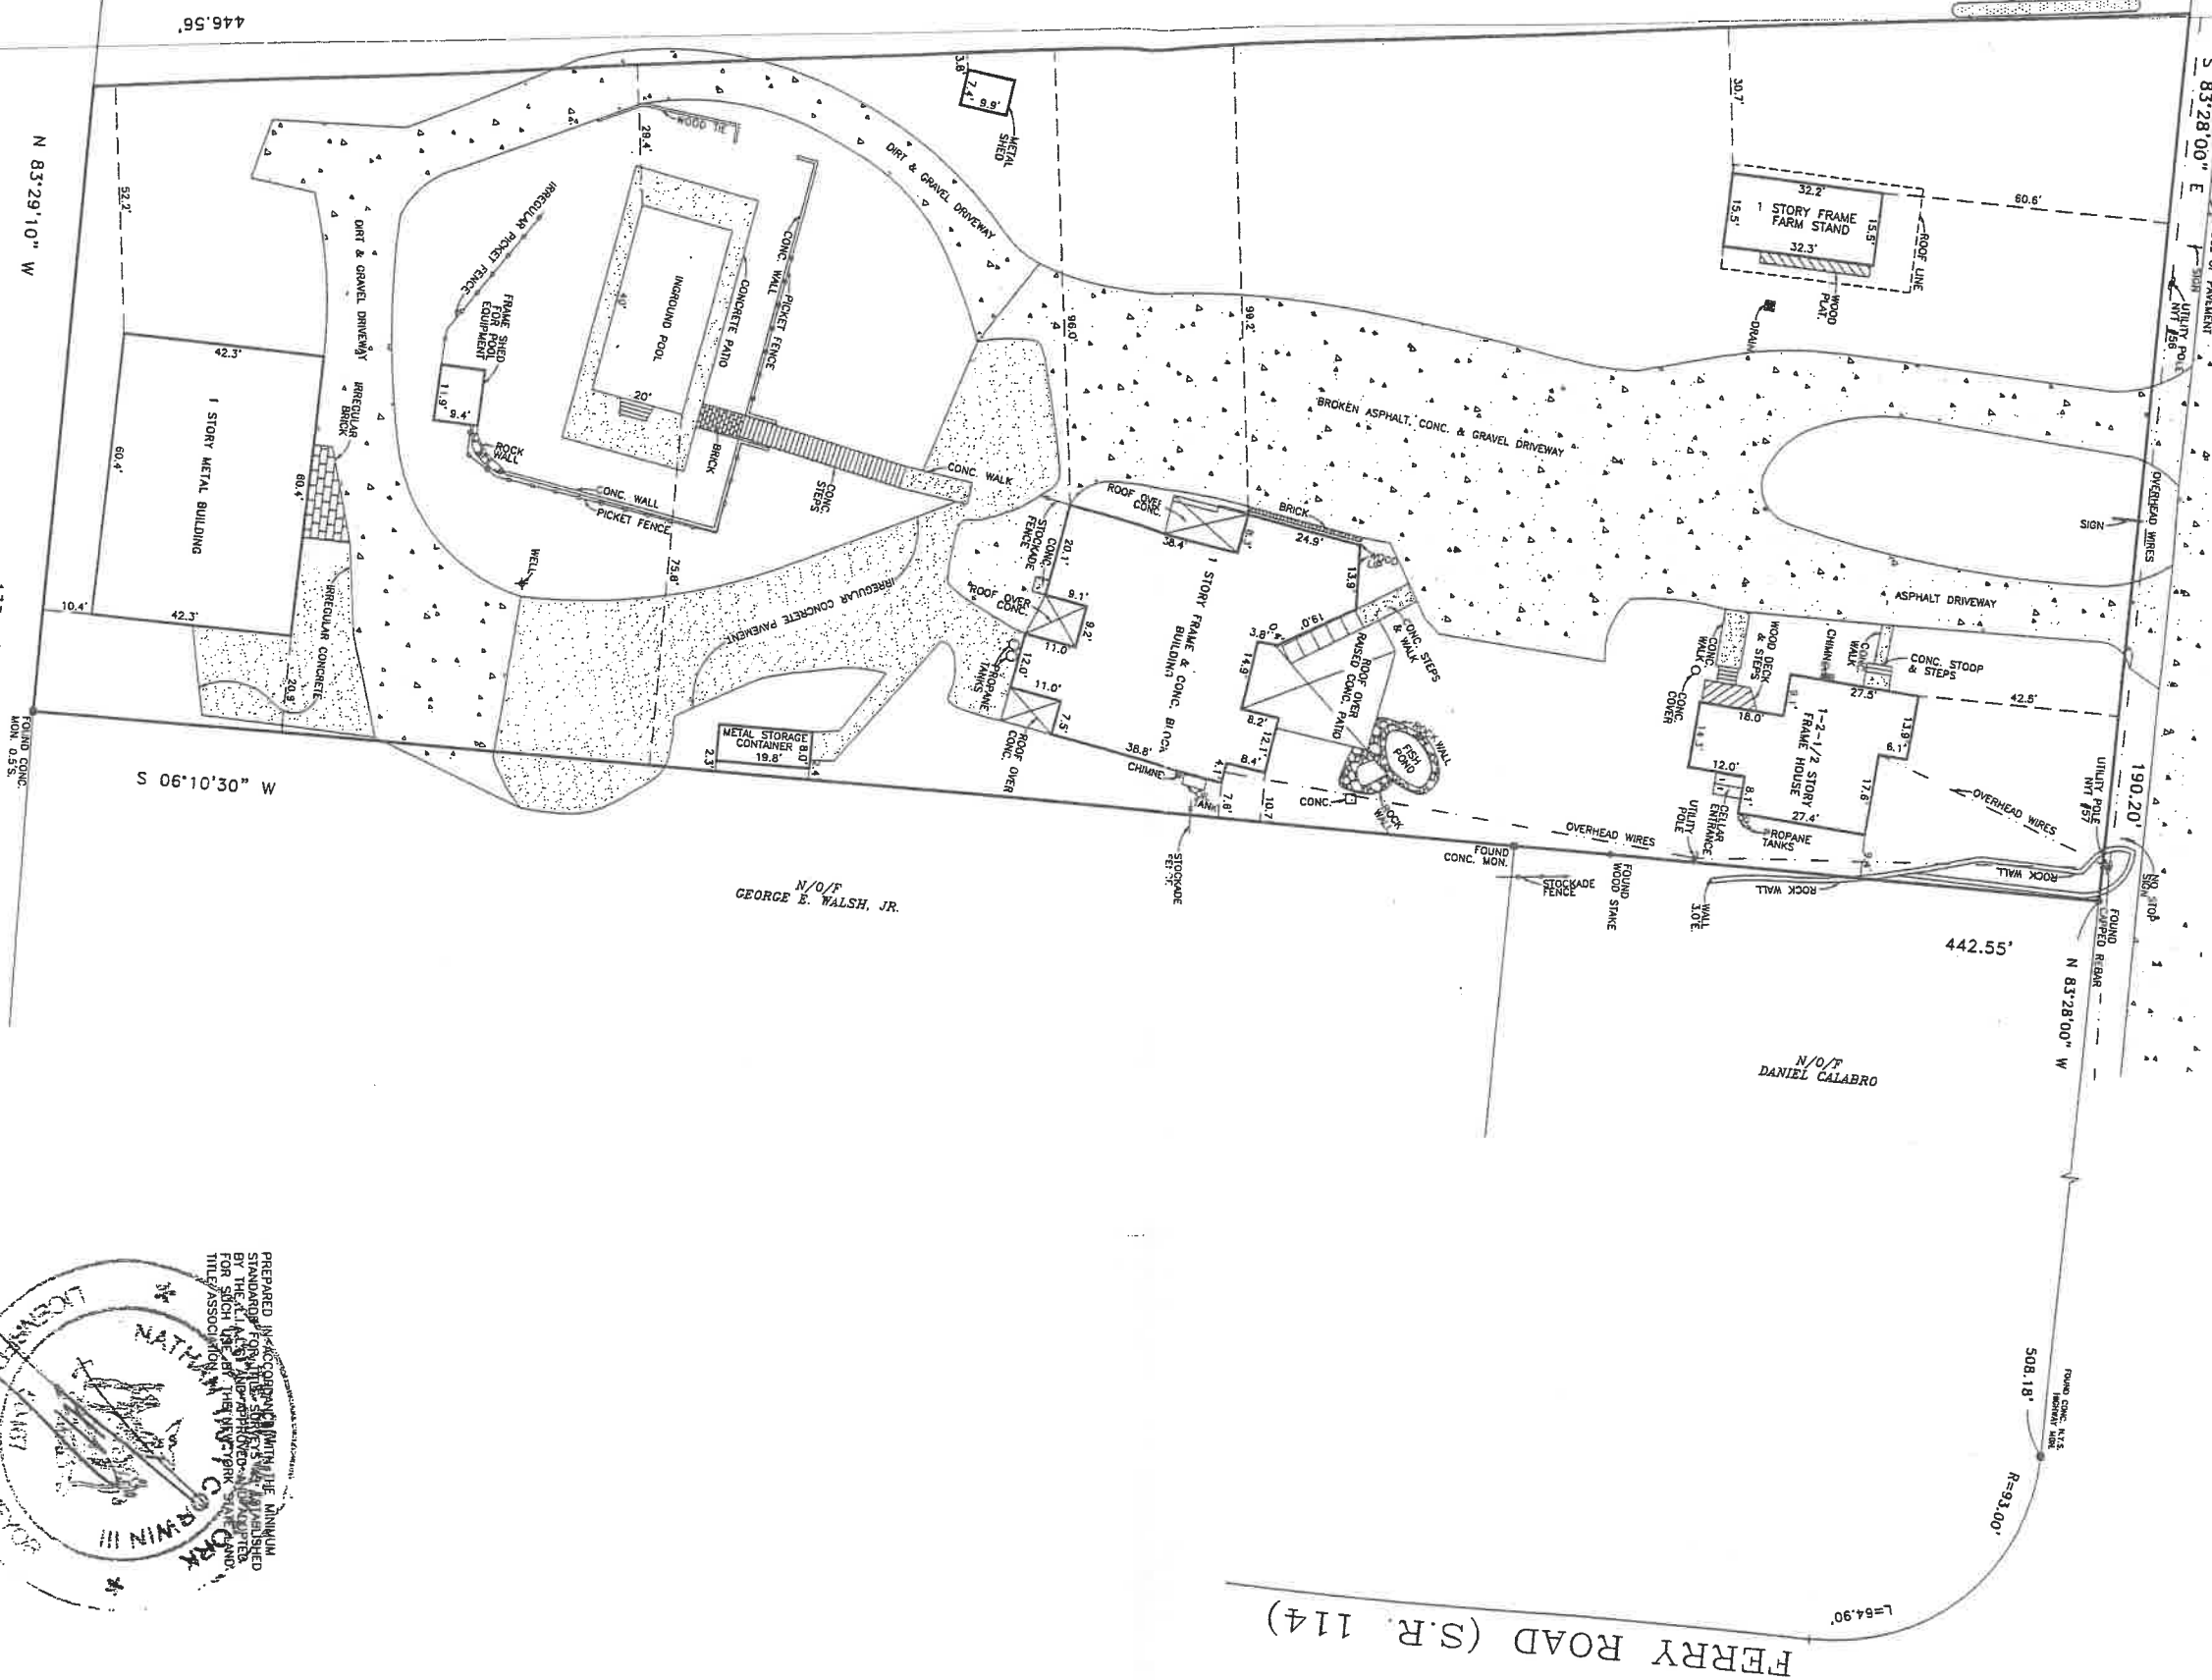

Nathan Tait Corwin III
Land Surveyor

UNAUTHORIZED ALTERATION OR ADDITION TO THIS SURVEY IS A VIOLATION OF SECTION 7209 OF THE NEW YORK STATE EDUCATION LAW.
COPIES OF THIS SURVEY MAP NOT BEARING THE LAND SURVEYOR'S INKED SEAL OR EMBOSSED SEAL SHALL NOT BE CONSIDERED TO BE A VALID TRUE COPY.
CERTIFICATIONS INDICATED HEREON SHALL RUN ONLY TO THE PERSON FOR WHOM THE SURVEY IS PREPARED, AND ON HIS BEHALF TO THE LENDING INSTITUTION LISTED HEREON, AND TO THE ASSIGNEES OF THE LENDING INSTITUTION. CERTIFICATIONS ARE NOT TRANSFERABLE.

Successor To: Stanley J. Iakson, Jr. L.S.
Joseph A. Ingegnio L.S.
Title Surveys — Subdivisions — Site Plans — Construction Layout
PHONE (631)727-2090
OFFICES LOCATED AT
1586 Main Road
Jamestown, New York 11947
Fax (631)727-1727
MAILING ADDRESS
P.O. Box 16
Jamestown, New York 11947