


JOB # : 12385 ~ C5183

SUFFOLK COUNTY TAX MAP
DISTRICT 0900
SECTION 100.00
BLOCK 02.00
PARCEL 015.000

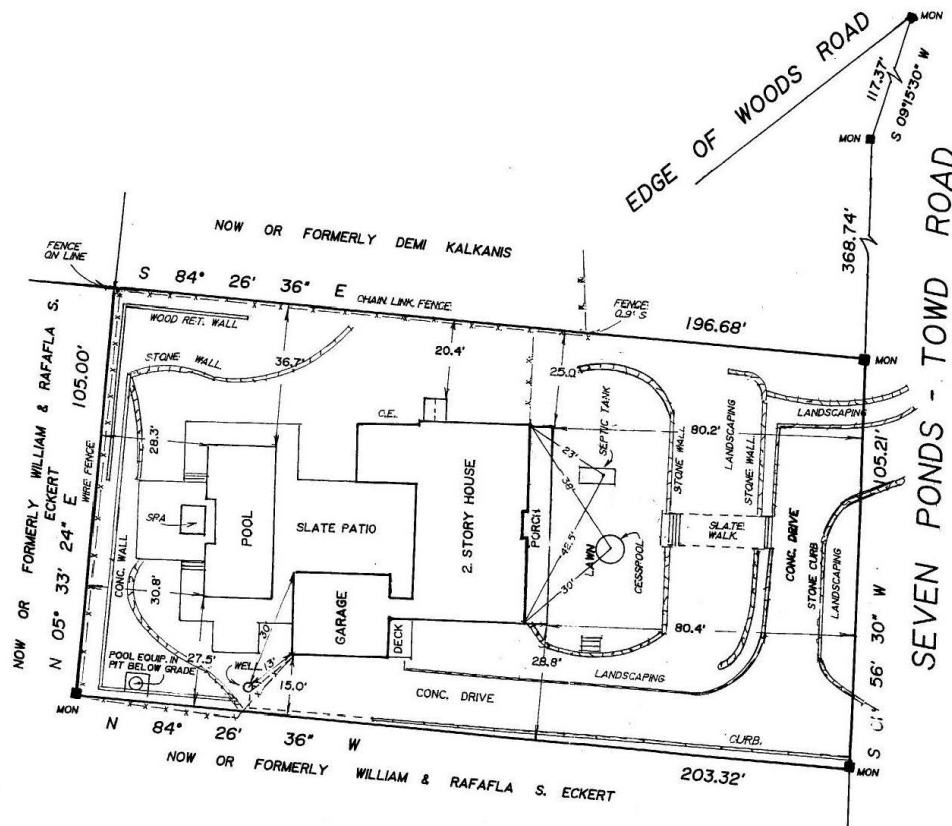

NOTE:
SANITARY LOCATIONS BY CONTRACTOR
S.C.H.D. REF. No. R09-98-0635
1) 1000 GAL. SEPTIC TANK
2) 8" DIA. x 12" DEEP CESSPOOL

SITUATE
WATER MILL
TOWN OF SOUTHAMPTON
SUFFOLK COUNTY, NEW YORK
SCALE 1" = 30'
AREA = 21,000 Sq.Ft.
(0.482 ACRE)

REVISED: JUNE 3, 2002 (REVISE SANITARY LOCATIONS)
SURVEYED: NOV. 27, 2000 (FINAL)



Lester Holden
LESTER HOLDEN L.S. No. 49548
S.H.W. & S., LAND SURVEYORS, P.C.
SQUIRES, HOLDEN, WEISENBACHER, & SMITH
LAND SURVEYORS ~ ENGINEERS
SOUTHAMPTON ~ NEW YORK