


LOTS 44 THROUGH 48 INCLUSIVE & P/O 49
" MAP OF SUBDIVISION, SECTION 1,
OLD HOUSE LANDING ESTATES"

FILED 06 JAN, 1953 AS MAP NO. 2007

LOCATED AT NORTHWEST,
 TOWN OF EAST HAMPTON,
 CO. OF SUFFOLK, STATE OF N.Y.

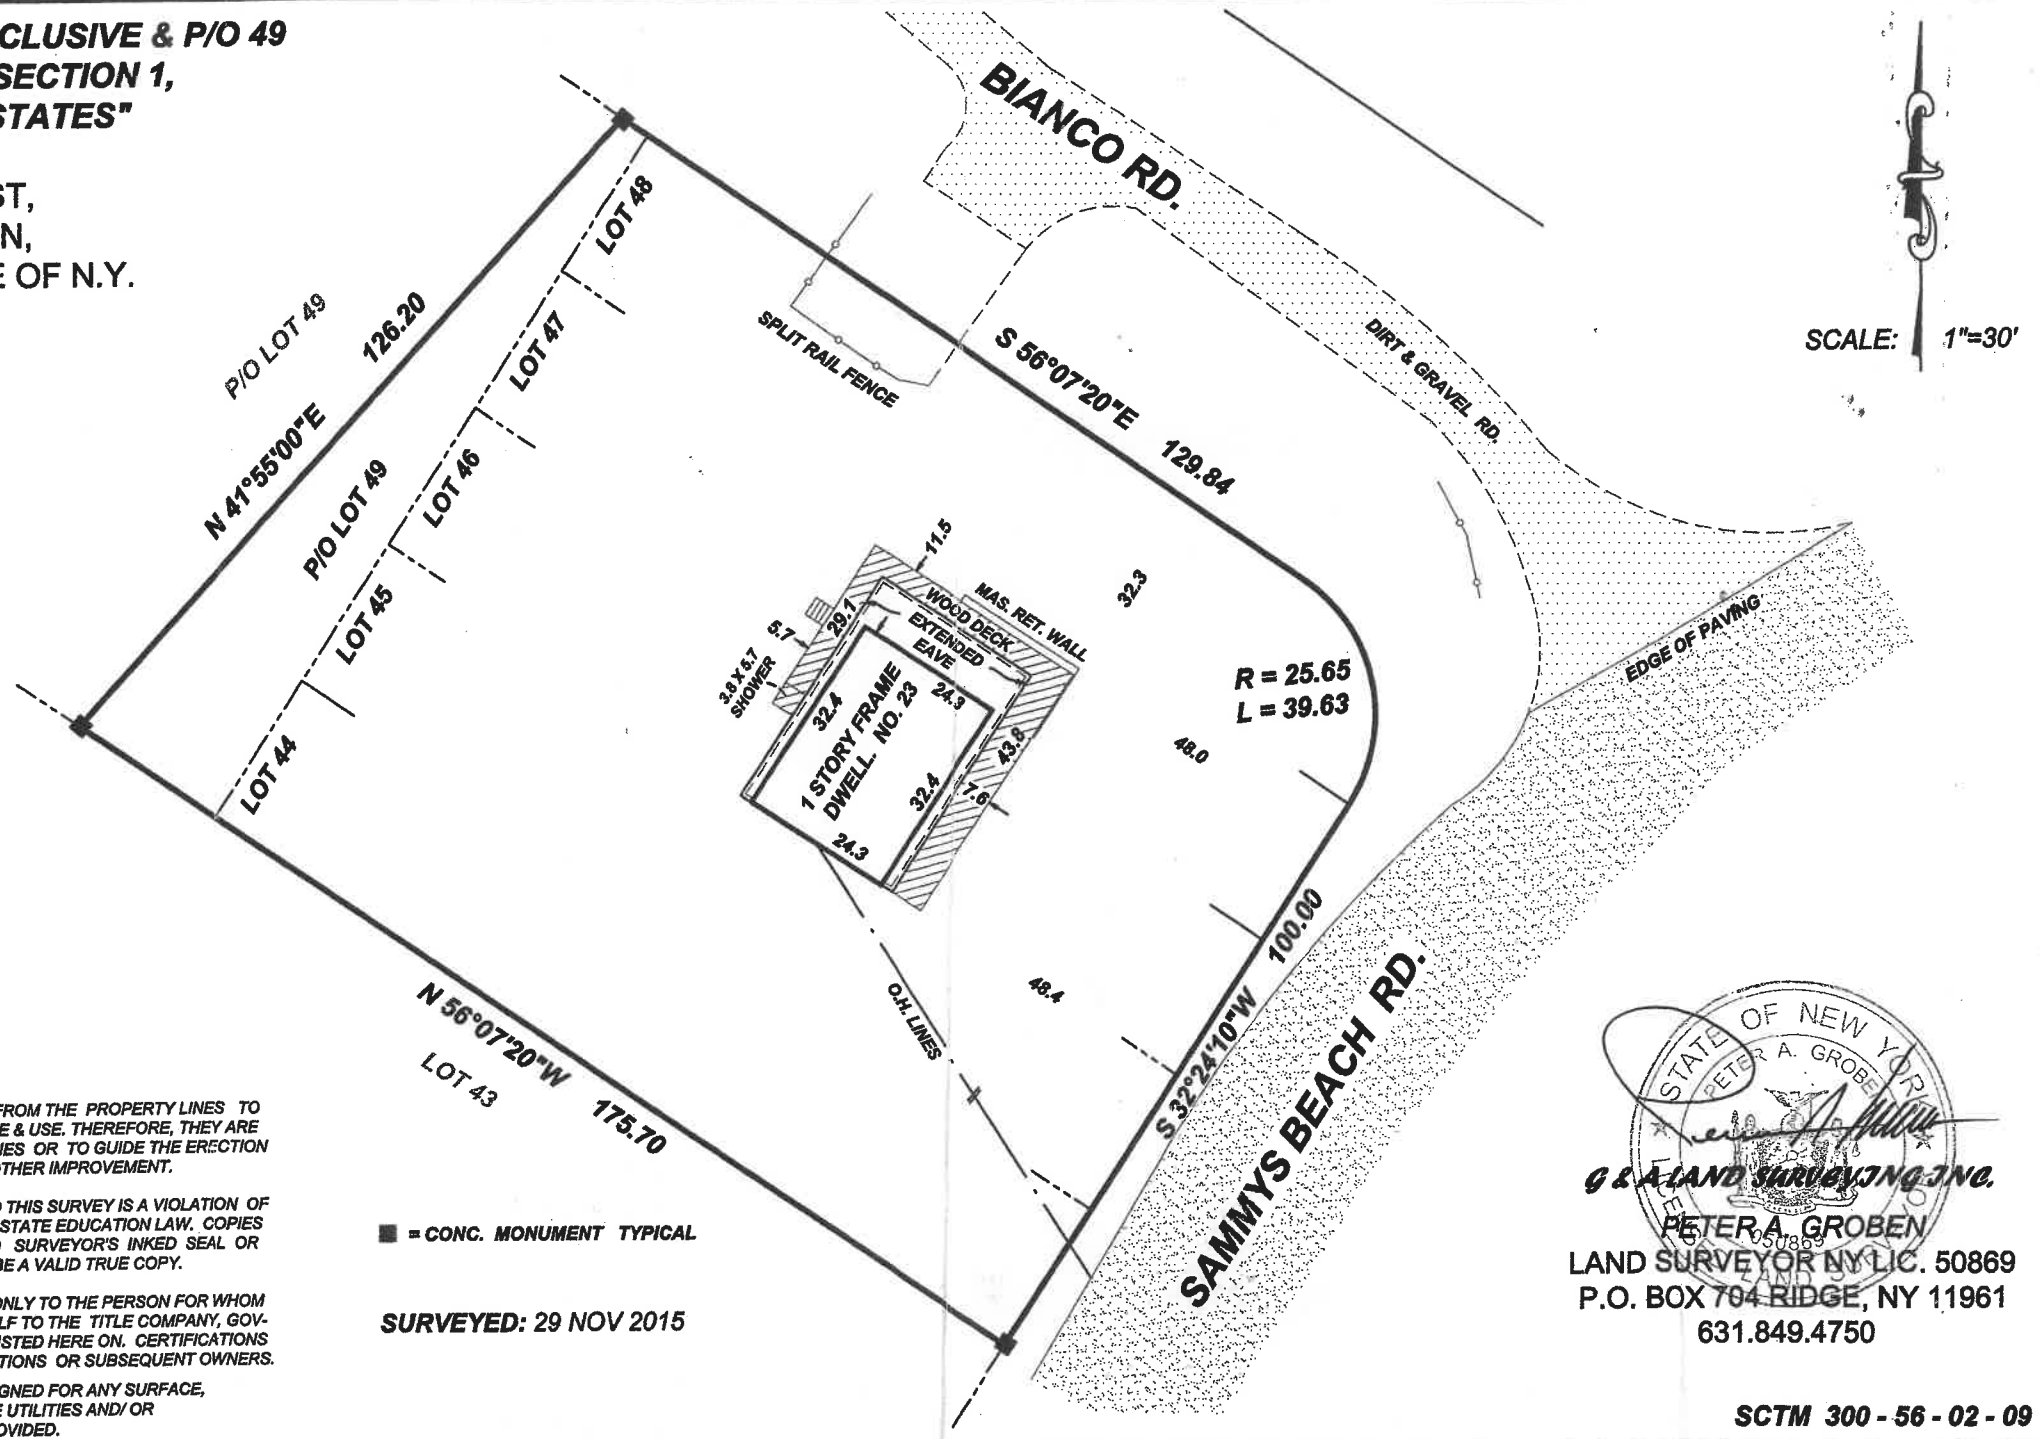

SCALE: 1"=30'

THE OFFSETS OR DIMENSIONS SHOWN HEREON FROM THE PROPERTY LINES TO THE STRUCTURES ARE FOR A SPECIFIC PURPOSE & USE. THEREFORE, THEY ARE NOT INTENDED TO MONUMENT THE PROPERTY LINES OR TO GUIDE THE ERECTION OF FENCES, ADDITIONAL STRUCTURES OR ANY OTHER IMPROVEMENT.

UNAUTHORIZED ALTERATIONS OR ADDITIONS TO THIS SURVEY IS A VIOLATION OF SECTION 7209 SUBDIVISION 20 OF THE NEW YORK STATE EDUCATION LAW. COPIES OF THIS SURVEY MAP NOT BEARING THE LAND SURVEYOR'S INKED SEAL OR EMBOSSED SEAL SHALL NOT BE CONSIDERED TO BE A VALID TRUE COPY.

CERTIFICATIONS INDICATED HEREON SHALL RUN ONLY TO THE PERSON FOR WHOM THE SURVEY IS PREPARED, AND ON THEIR BEHALF TO THE TITLE COMPANY, GOVERNMENT AGENCY AND LENDING INSTITUTION LISTED HERE ON. CERTIFICATIONS ARE NOT TRANSFERABLE TO ADDITIONAL INSTITUTIONS OR SUBSEQUENT OWNERS.

NO RESPONSIBILITY IS ASSUMED BY THE UNDERSIGNED FOR ANY SURFACE, SUB-SURFACE, AERIAL EASEMENTS, SUB-SURFACE UTILITIES AND/OR STRUCTURES IN OR OUT OF EASEMENTS IF SO PROVIDED.

■ = CONC. MONUMENT TYPICAL

SURVEYED: 29 NOV 2015

STATE OF NEW YORK
 PETER A. GROBEN
 G & A LAND SURVEYING INC.
 PETER A. GROBEN
 LAND SURVEYOR NY LIC. 50869
 P.O. BOX 704 RIDGE, NY 11961
 631.849.4750

SCTM 300 - 56 - 02 - 09