



TITLE NO: BAC 4033 S

CERTIFIED TO:


**Barristers Abstract Corporation
The Greater New York Savings Bank
Thomas M. Fahey
Patricia Shaefer**

Elevation Datum is based upon High Water of May 1916.

Elevations shown fix +19.00'

SECTION 369 BLOCK 1 LOT 101 & 100.1

COUNTY OF SUFFOLK TOWN OF SOUTHAMPTON STATE OF NEW YORK.

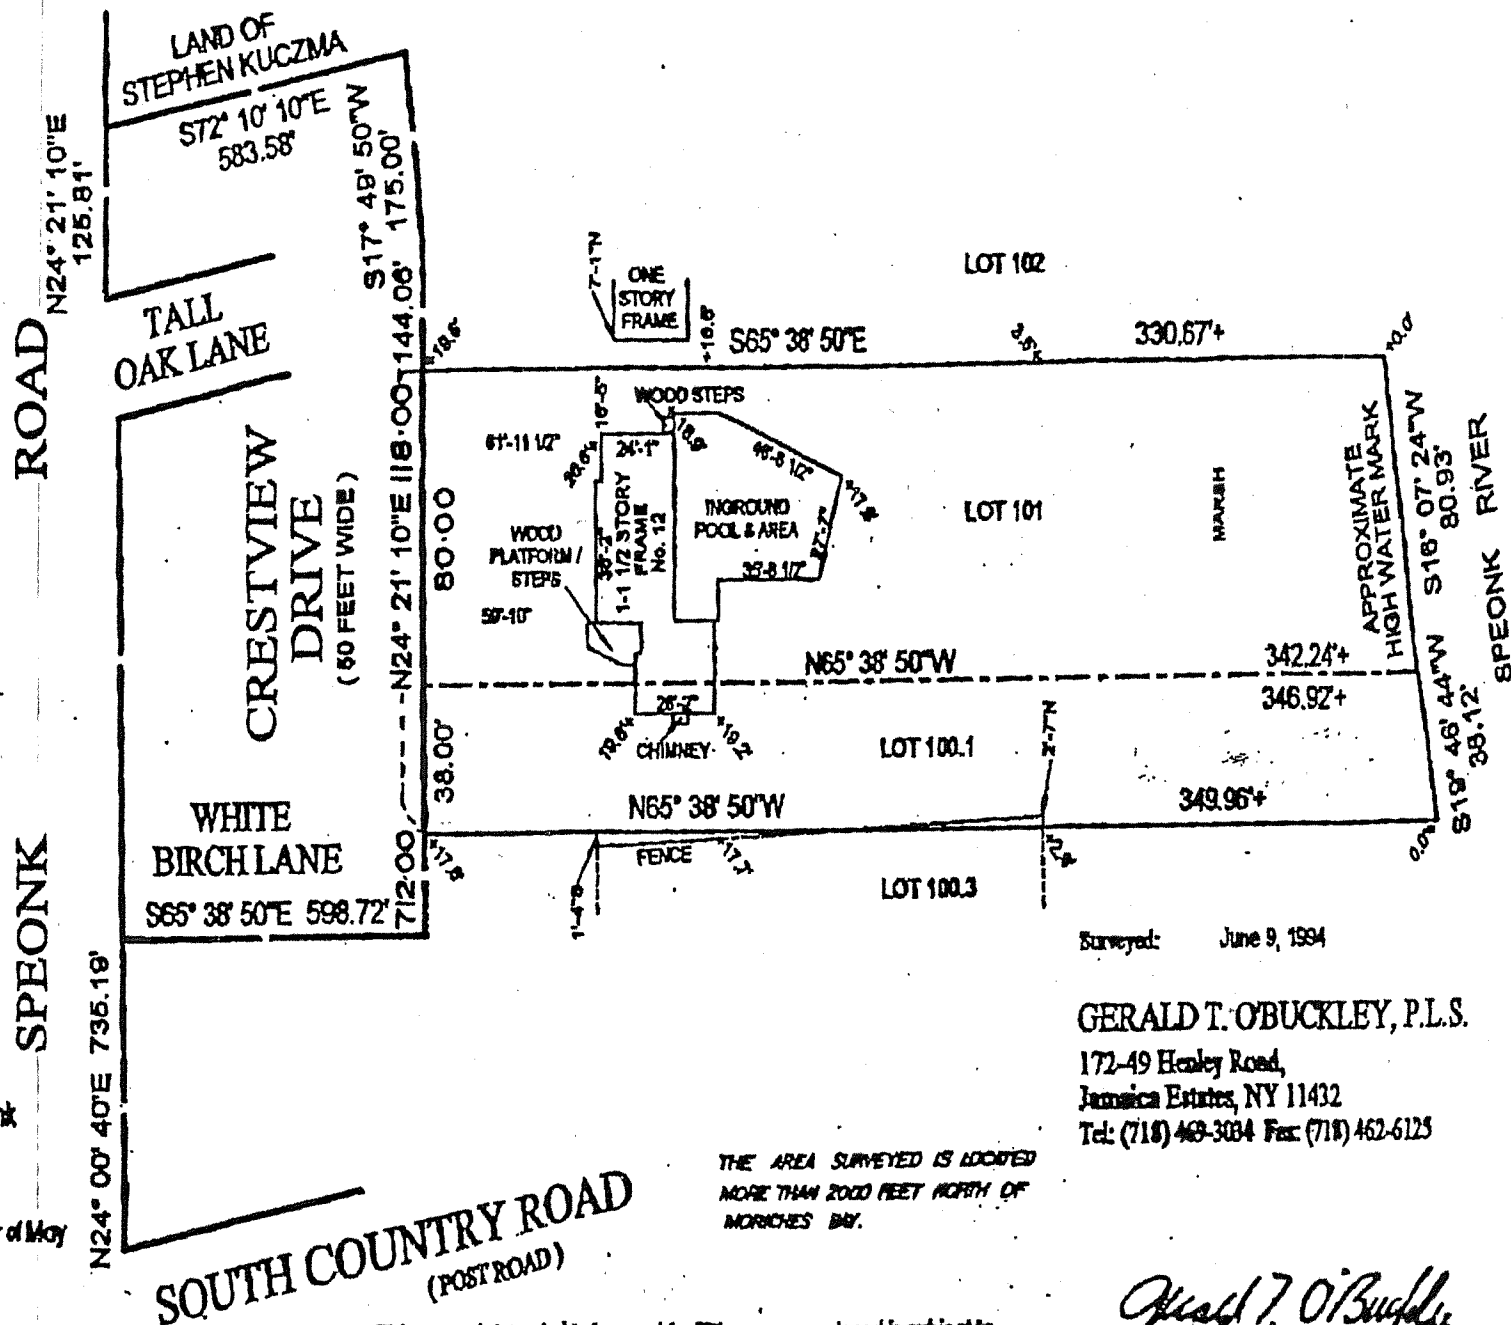

Surveyed: June 9, 1994

GERALD T. O'BUCKLEY, P.L.S.

172-49 Henley Road,
Jamaica Estates, NY 11432

Tel: (718) 469-3084 Fax: (718) 462-6125

THE AREA SURVEYED IS LOCATED
MORE THAN 2000 FEET NORTH OF
MORICHES BAY.

This survey is intended to be used for Title purposes only and is subject to whatever a more complete title search may reveal. It is not to scale and using it to locate new construction may result in problems for which this surveyor will not be liable.

Guest 7. O'Brady