


JOB No.15220 ~ CWB541

NOTE:

1. SUBJECT PARCEL FALLS WITHIN THE STORMWATER
MANAGEMENT DISTRICT.

**STORMWATER MANAGEMENT
REGULATIONS APPLY**

- 1) Silt fenced and hay bales where
required to contain runoff.
- 2) Leaders, gutters and downspouts
required.
- 3) Downspouts to catch runoff on driveways
required.
- 4) Pool downspouts required.

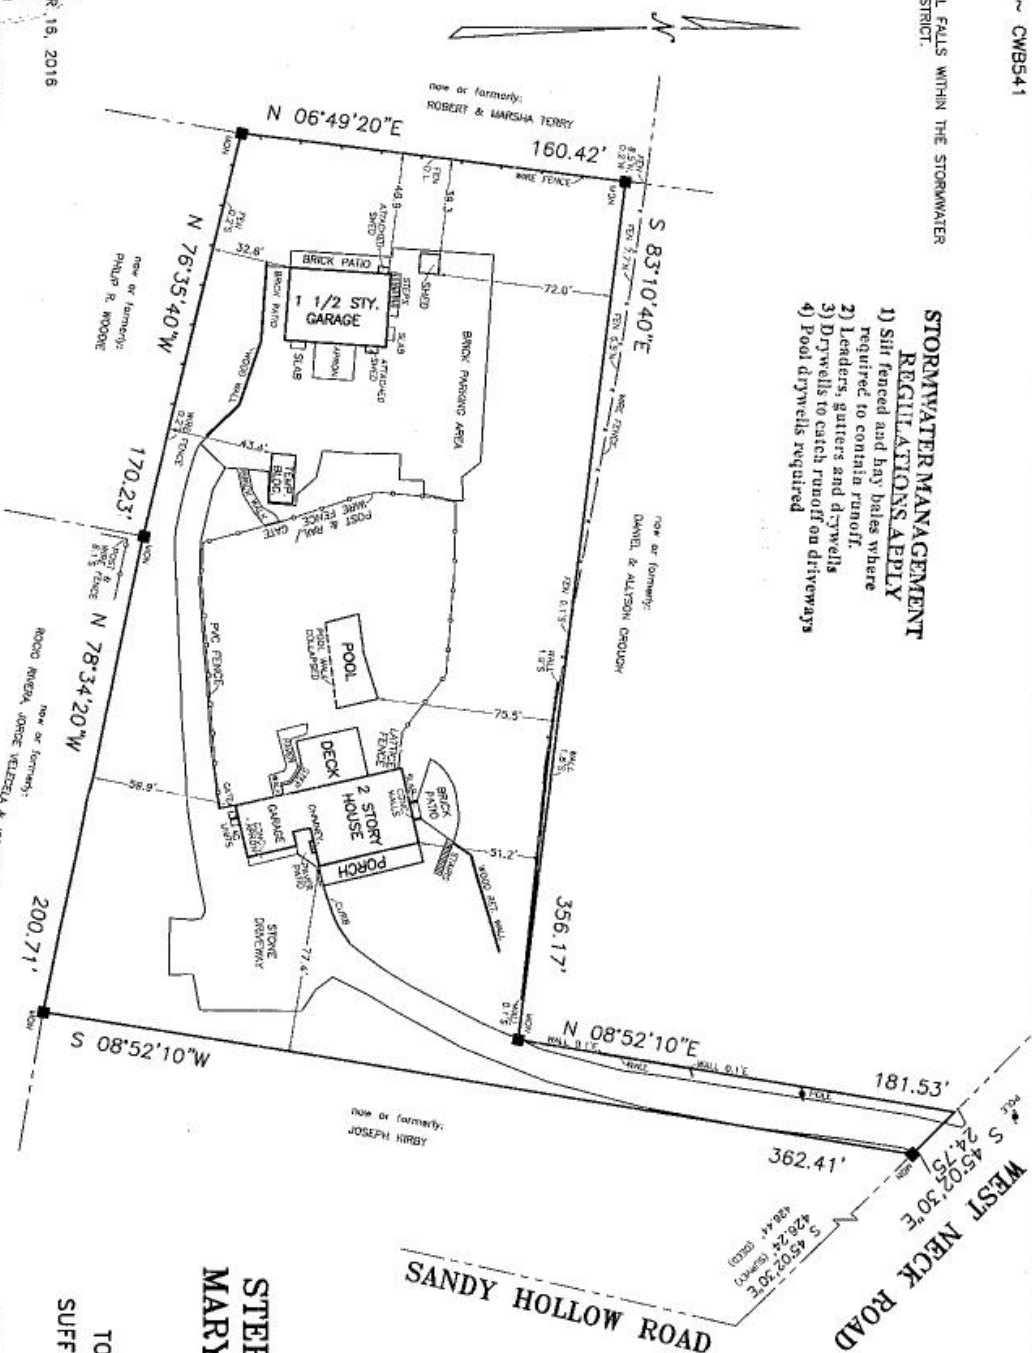

SUFFOLK COUNTY TAX MAP

DISTRICT 0900
SECTION 111.00
BLOCK 03.00
PARCEL 021.002

NO OVERSIGHT, ERROR OR OMISSION ON THE
PART OF THE BUILDING INSPECTOR OR HIS
REPRESENTATIVE SHALL LEGALIZE THE ERECT-
ING, CONSTRUCTION, ALTERATION, REMOVAL,
USE OR OCCUPANCY OF A BUILDING OR
STRUCTURE THAT DOES NOT CONFORM TO THE
PROVISIONS OF THE NY STATE FIRE PREVENTION
AND BUILDING CODE AND THE CODE OF THE
TOWN OF SOUTHAMPTON ZONING REGULATIONS

MAP OF PROPERTY

FOR

**STEFFEN STEUDTE &
MARY ELLEN STEUDTE**

SITUATE

TUCKAHOE

TOWN OF SOUTHAMPTON

SUFFOLK COUNTY, NEW YORK

AREA = 70.553 S.F. (1.620 ACRE)

SCALE: 1" = 50'

SUBMITTED: NOVEMBER 18, 2016

DESTER HOLDEN, L.S. 49548

S. H. W. and S., LAND SURVEYORS P.C.

SQUIRES, HOLDEN, WEISENBACHER & SMITH

LAND SURVEYING ~ LAND PLANNING ~ ENGINEERING
SOUTHAMPTON ~ NEW YORK