


SUFFOLK COUNTY TAX MAP

NOTES

1. PARCEL LIES IN STORM WATER MANAGEMENT DISTRICT.
2. LOCATION OF WATER LINE IS SHOWN AS PER OWNER.
3. EXISTING SANITARY SYSTEM AS PER BUILDER.
4. EXISTING SANITARY SYSTEM CONSISTS OF A 1500 GAL. SEPTIC TANK AND (2) 8" DIAMETER X 6' DEEP CESSPOOLS.
5. S.C.D.H.S. REFERENCE No.: R09-04-0209.

DISTRICT 0900
SECTION 003.00
BLOCK 01.00
PARCEL 037.000

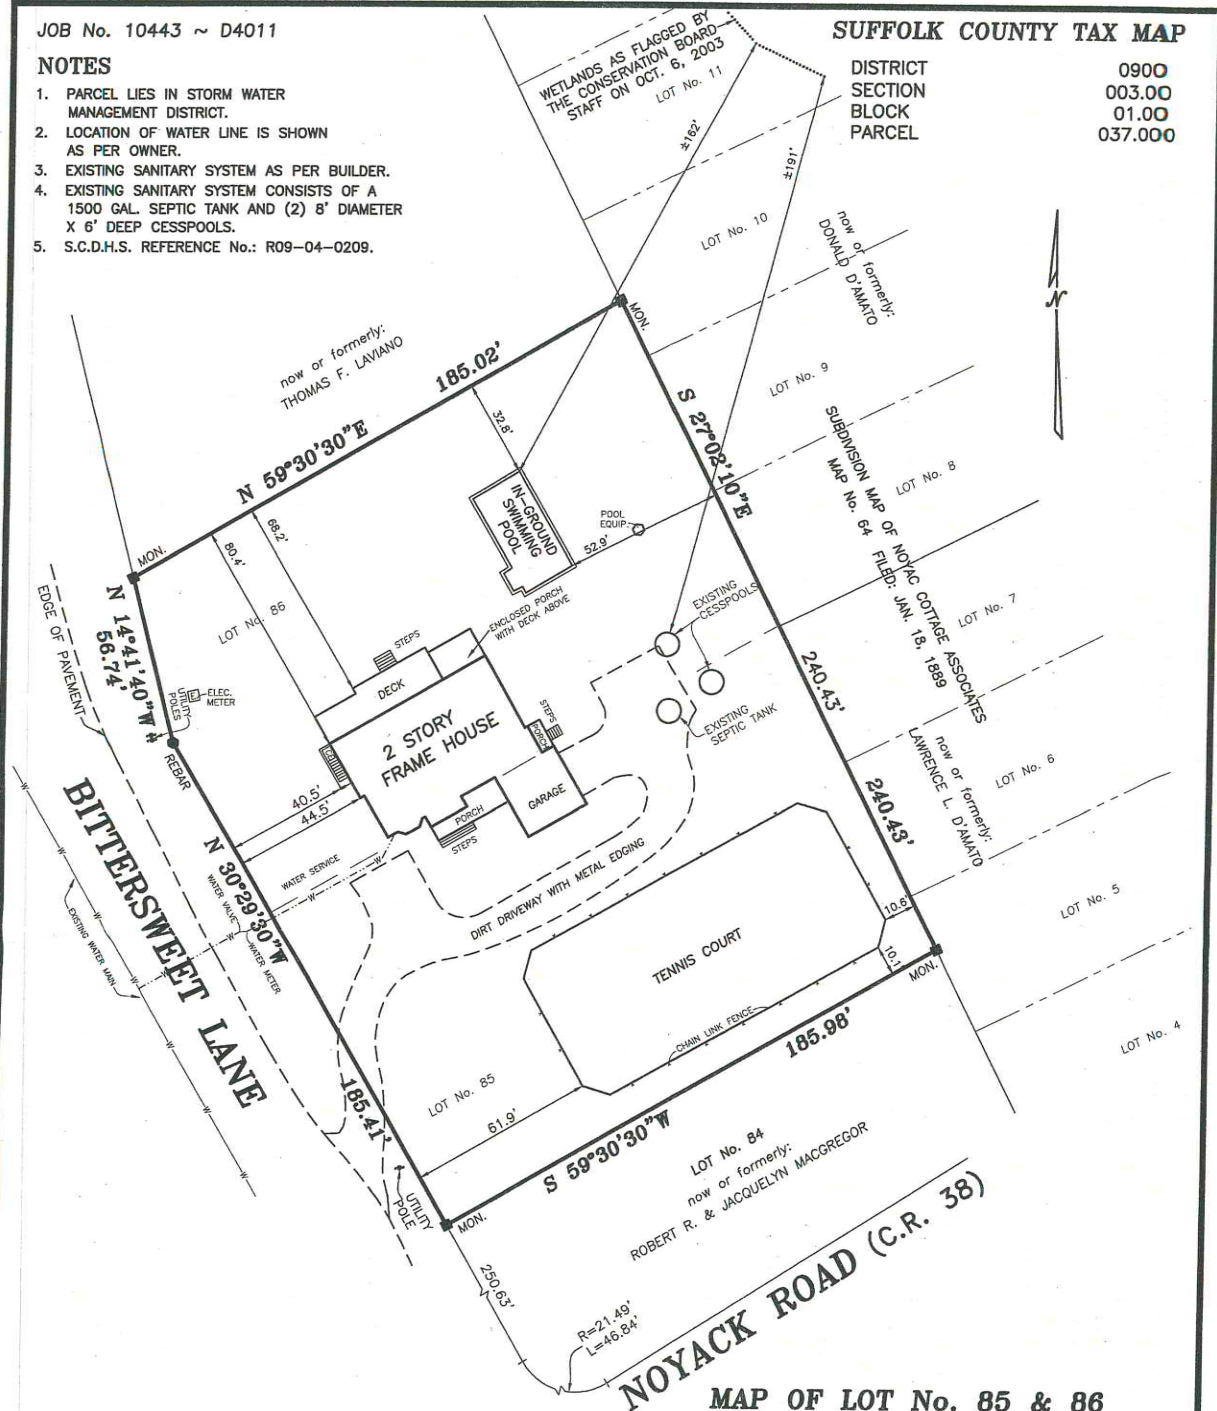

MAP OF LOT No. 85 & 86
SUBDIVISION MAP OF
SUNSET SHORES
 MAP No. 1819 FILED: FEB. 9, 1951
 FOR

MICHAEL SMOLENS

SITUATE
NOYACK

TOWN OF SOUTHAMPTON
SUFFOLK COUNTY, NEW YORK

ROBERT A. SMITH, L.S. No. 49239
S. H. W. & S. LAND SURVEYORS P.C.

SQUIRES, HOLDEN, WEISENBACHER & SMITH
LAND SURVEYORS ~ ENGINEERS
SOUTHAMPTON ~ NEW YORK

AREA = 45,950 S.F. (1.055 ACRES)
SCALE: 1" = 40'