

SUFFOLK COUNTY TAX MAP

DISTRICT: 0900

SECTION: 210.00

BLOCK: 02.00

PARCEL: 036.039

SUFFOLK COUNTY DEPARTMENT OF HEALTH SERVICES

SINGLE FAMILY DWELLING ONLY

DATE JUL 21 1992 H.S. REF. NO. 91-SH-311

The sewage disposal and water supply facilities for this location have been inspected by this Department and/or other agencies and found to be satisfactory.


Stephen A. Costa, P.E.

Chief of Bureau of Wastewater Management

UNRECORDED ALTERATION OR ADDITION TO A SURVEY MAP BEARING A GREEN BELT SEAL IS A VIOLATION OF SECTION 27-01, SUB-DIVISION 2, OF THE NEW YORK EASEMENT LAW. CERTAIN OF THIS SURVEY MAP NOT BEARING THE LAND SURVEYOR'S GREEN PINKED SEAL OR CROSS-SEAL SHALL NOT BE CONSIDERED TO BE A VALID SURVEY. CERTIFICATIONS INDICATED HEREON SIGNIFY THAT THIS SURVEY WAS PREPARED IN ACCORDANCE WITH THE EXISTING CODE OF PRACTICE FOR LAND SURVEYS AS ADOPTED BY THE NEW YORK STATE ASSOCIATION OF PROFESSIONAL LAND SURVEYORS. SAID CERTIFICATIONS APPLY ONLY TO THE PERSON FOR WHOM THE SURVEY IS PREPARED, AND ON BEHALF TO THE TITLE COMPANY, GOVERNMENTAL AGENCY AND LENDING INSTITUTION LISTED HEREON, AND TO THE ASSIGNEES OF THE LENDING INSTITUTION. CERTIFICATIONS ARE NOT SUBJECT TO ADDITIONAL INSTITUTIONS OR SUBSEQUENT OWNERS.



BLACKWATCH COURT

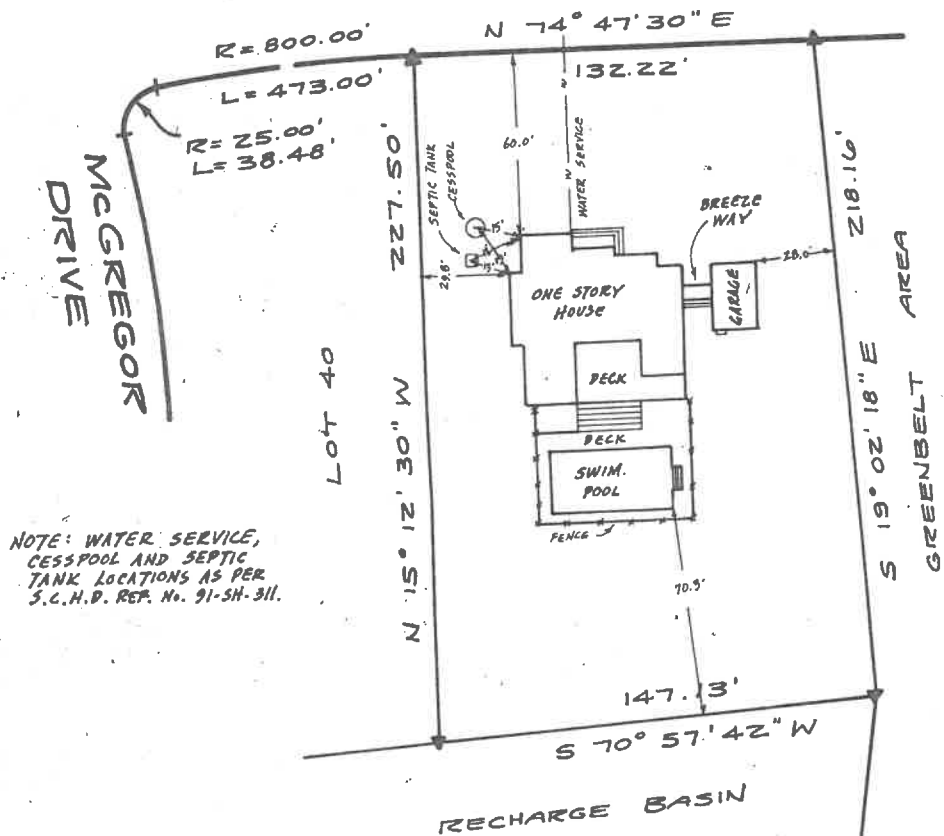

NOTE: WATER SERVICE, CESSPOOL AND SEPTIC TANK LOCATIONS AS PER S.C.H.D. REF. No. 91-SH-311.



THE HARMAT ORGANIZATION
P.O. Box 539
Old Country Road
Quogue, N.Y. 11959

653-3303
91-SH-311

MAP OF LOT NO. 39
SUBDIVISION MAP OF
THE HIGHLANDS
MAP NO 7099 ~ FILED: JULY 27, 1982
FOR

ROBERT LONDON
SITUATE

SHINNECOCK HILLS
TOWN OF SOUTHAMPTON
SUFFOLK COUNTY, N.Y.
SCALE: 1" = 50'

(AREA = 31,090 Sq. Ft.)

SURVEYED: JULY 16, 1992 (FINAL)

Karl W. Weisenbacher

KARL W. WEISENBACHER, L.S. NO. 38195

SQUIRES, HOLDEN,

WEISENBACHER & SMITH

LAND SURVEYORS - ENGINEERS
SOUTHAMPTON, N.Y.