


SURVEYED FOR: JOHN NICHOLS
LOCATED AT: DEERFIELD, T/O SOUTHAMPTON,
SUFF.CO.NY.
LOT: 2
MAP OF: "DEER RUN FARMS"
FILED: 1/6/1988 MAP# 8453
S.C.T.M.# 0900-47-1-6.2
SCALE: 1"=30'

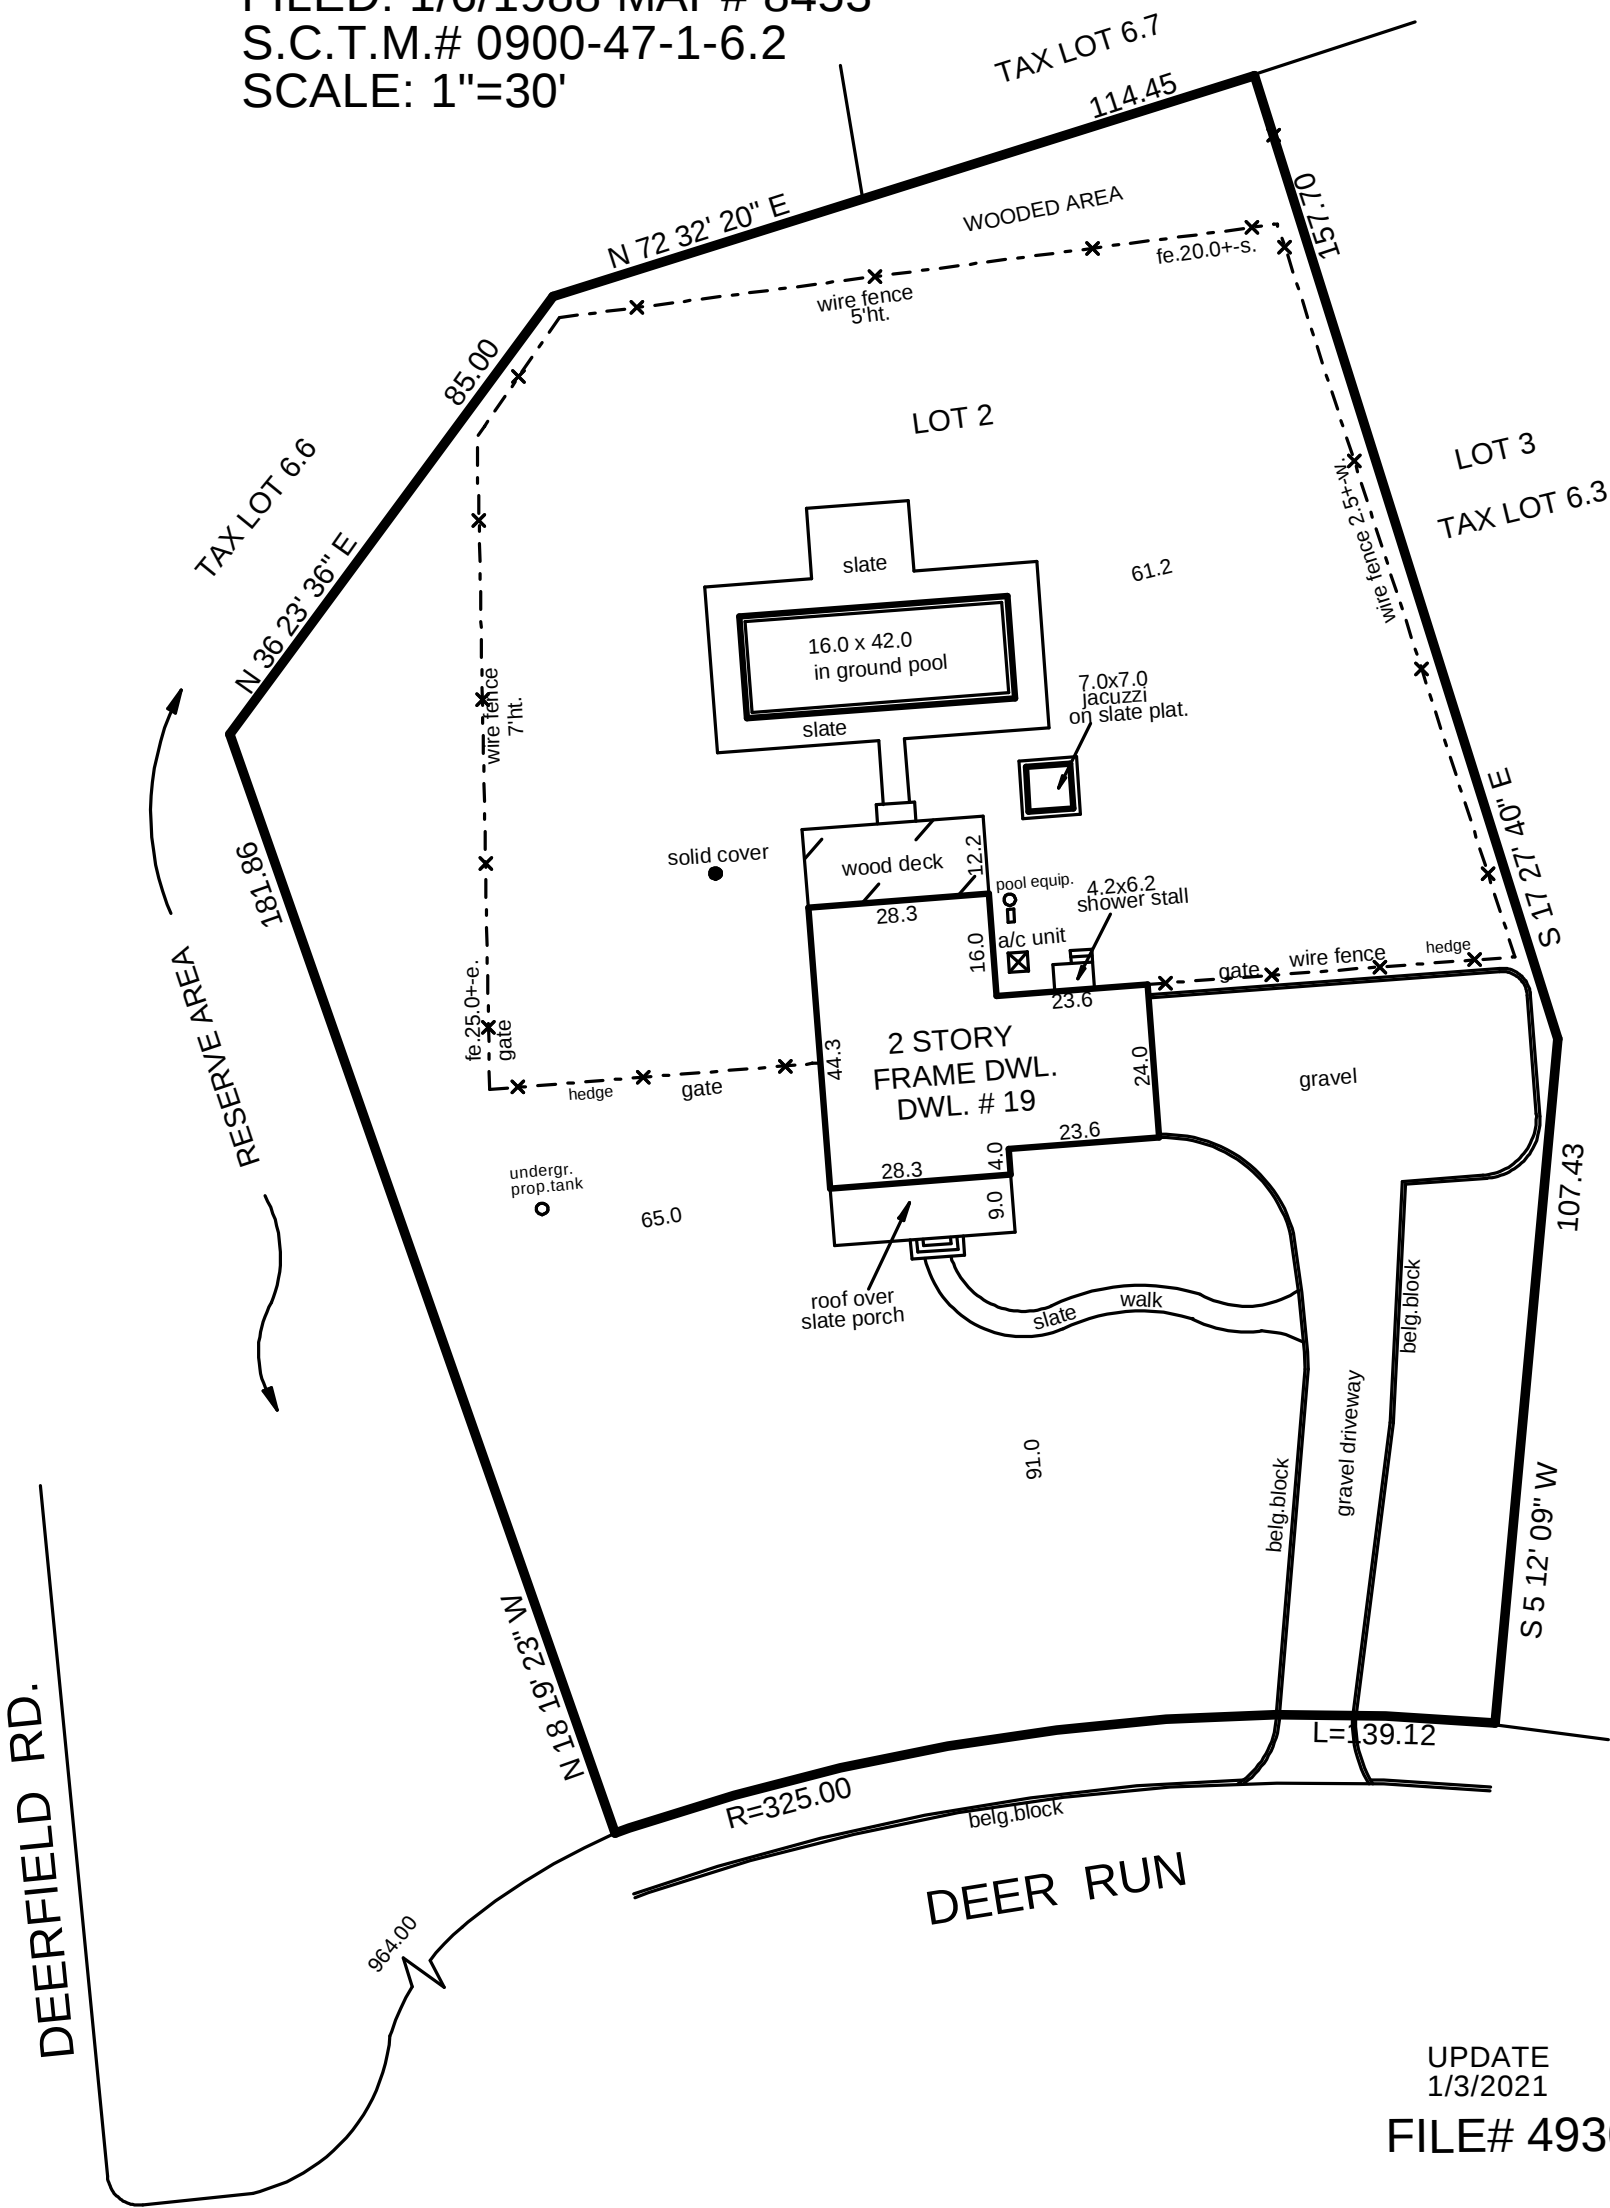

UPDATE
1/3/2021
FILE# 49300

WILLIAM R.SIMMONS 3RD.L.S.P.C.		
128 CARLETON AVE, EAST ISLIP,NY,11730		
PH 631-581-1688 FX 631-581-1691		
DATE: 10/30/2013	SCALE: 1" = 30'	DRAWN BY: E.S.

This document was created with Win2PDF available at <http://www.win2pdf.com>.
The unregistered version of Win2PDF is for evaluation or non-commercial use only.
This page will not be added after purchasing Win2PDF.