


1-259527 (3)

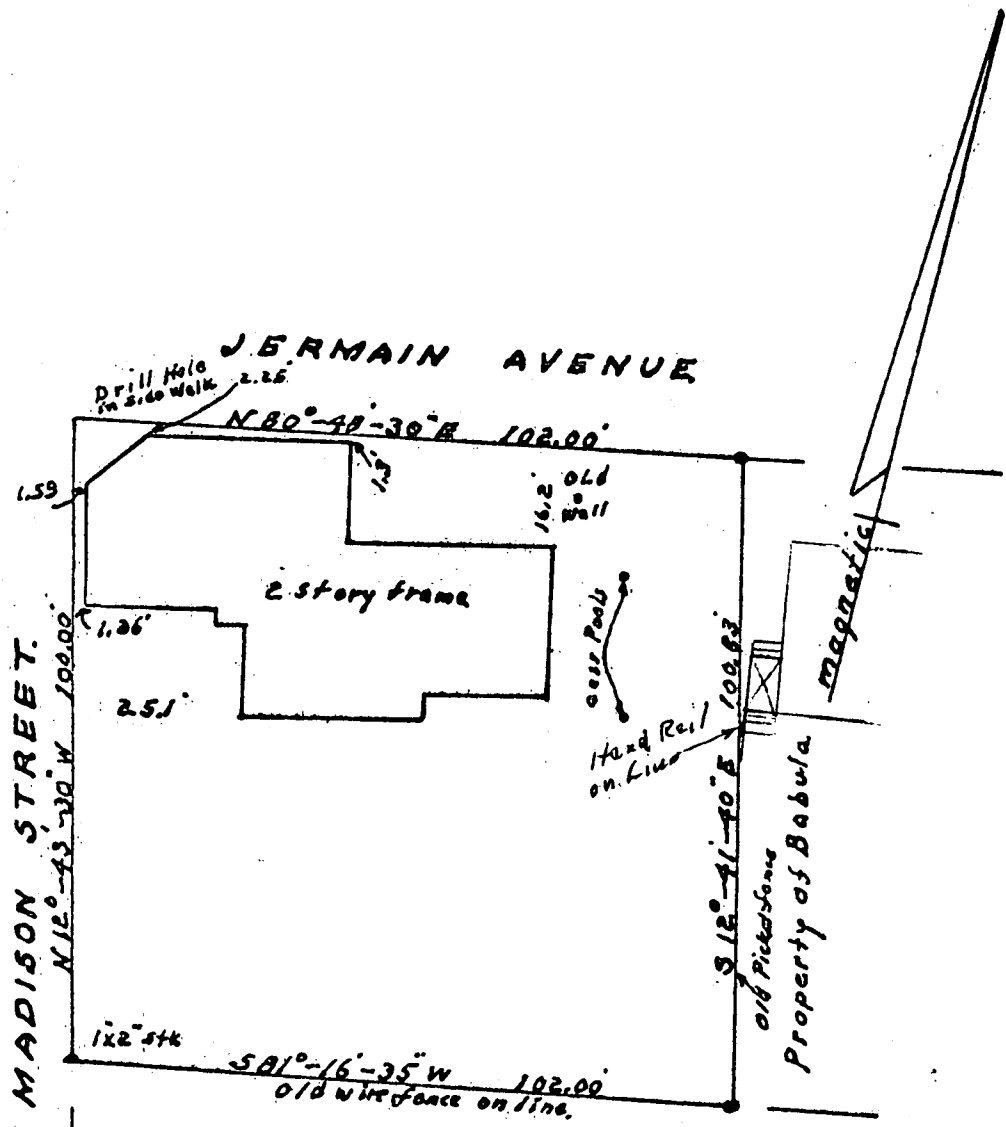

Entire Property of Johnson.

SURVEY OF PROPERTY
FOR
MANUEL CUNHA
AT
SAG HARBOR, N.Y.
Town of Southampton, Suffolk County.
Surveyed Jan. 1966 by Jos. H. Brewer L.S.
Scale 1" = 30'

Guaranteed to
The Security Title & Guaranty Co.
Joseph H. Brewer L.S.