

SURVEY OF PROPERTY

SCTM No. 901-003-1-23
SCDHS Ref. #R09-00-0131

800p80

LOT 1

Map Of

NORTH HAVEN MANOR

Filed March 26, 1947 as map no. 1531

Situate




INCORPORATED VILLAGE OF NORTH HAVEN

Town Of Southampton

Suffolk County, New York

SCALE: 1" = 30'

AREA: 18.071 sq. ft.
or 0.4149 acres

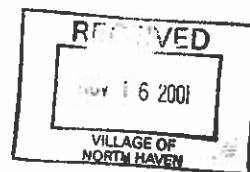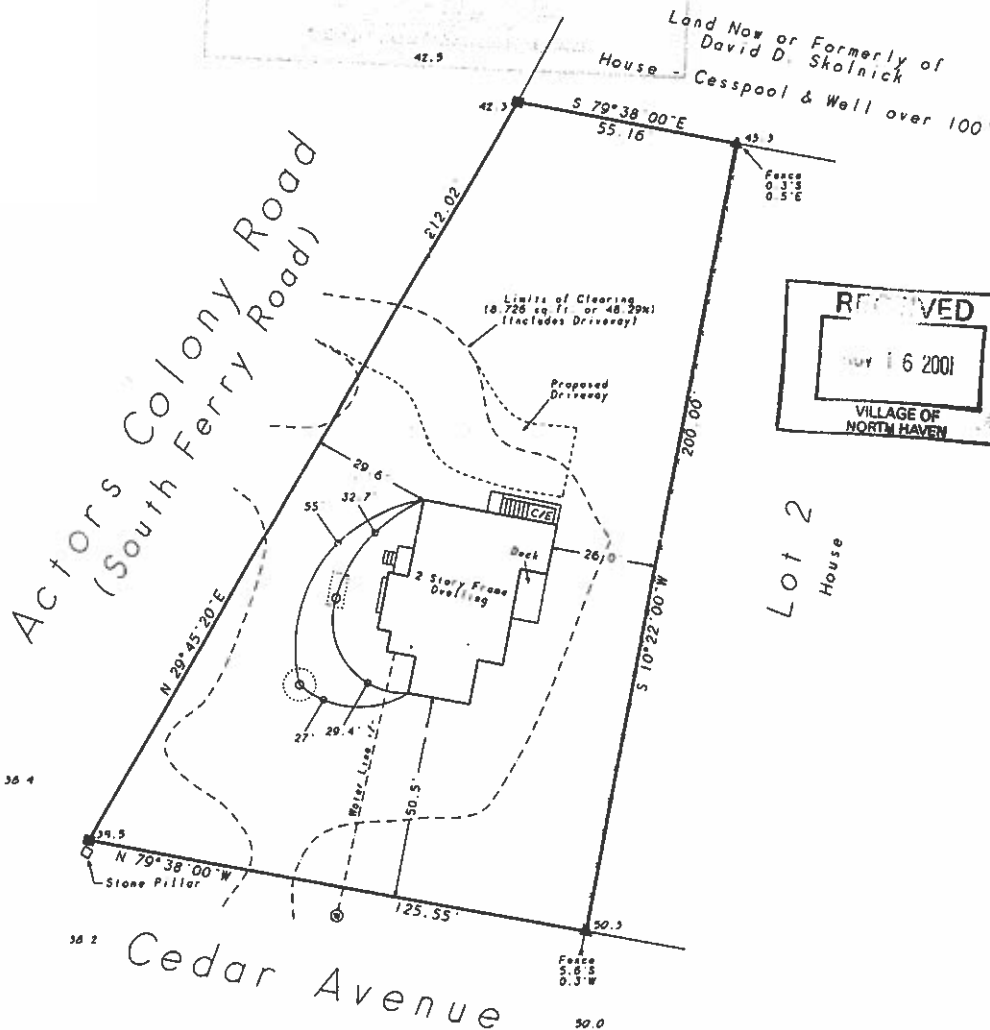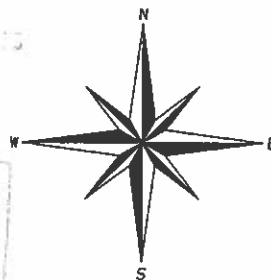

Lot 2
House

- indicates found concrete monument.
- ▲ indicates found stake.
- △ indicates set stake.
- indicates set nail.
- ⊙ indicates water meter.

NOTES:

1. Unauthorized alteration or addition to a survey map bearing a licensed land surveyor's seal is a violation of section 7209, sub-division 2 of the N.Y. State Education Law.
2. Only copies from the original of this survey marked with an original of the land surveyor's embossed seal or inked seal shall be considered to be valid copies.
3. Certifications indicated hereon signify that this survey was prepared in accordance with the existing Code of Practice for Land Surveys adopted by the N.Y. State Association of Professional Land Surveyors. Said certifications shall run only to the person for whom the survey is prepared, and on his behalf to the Title company, governmental agency and Lending institution listed hereon, and to the assignees of the lending institution. Certifications are not transferable to additional institutions or subsequent owners.
4. Underground improvements or encroachments, if any, are not shown hereon.
5. The existence of rights of ways, wetlands and/or easements of record, if any, not shown are not guaranteed.
6. Elevations shown are from assumed datum.

August 14, 2001: Final
December 28, 2000: Under construction
December 8, 2000: Stake house & recertify
locate footings



Surveyed: December 22, 1995
David L. Saskas
N.Y.S. Lic. No. 049960

Saskas Surveying Company, P.C.
124 Cedar Street
East Hampton, New York 11937
(631) 324-6917 329-4768