


LOT No. 4  
now or formerly:  
RAYMOND & JANET BUTLER

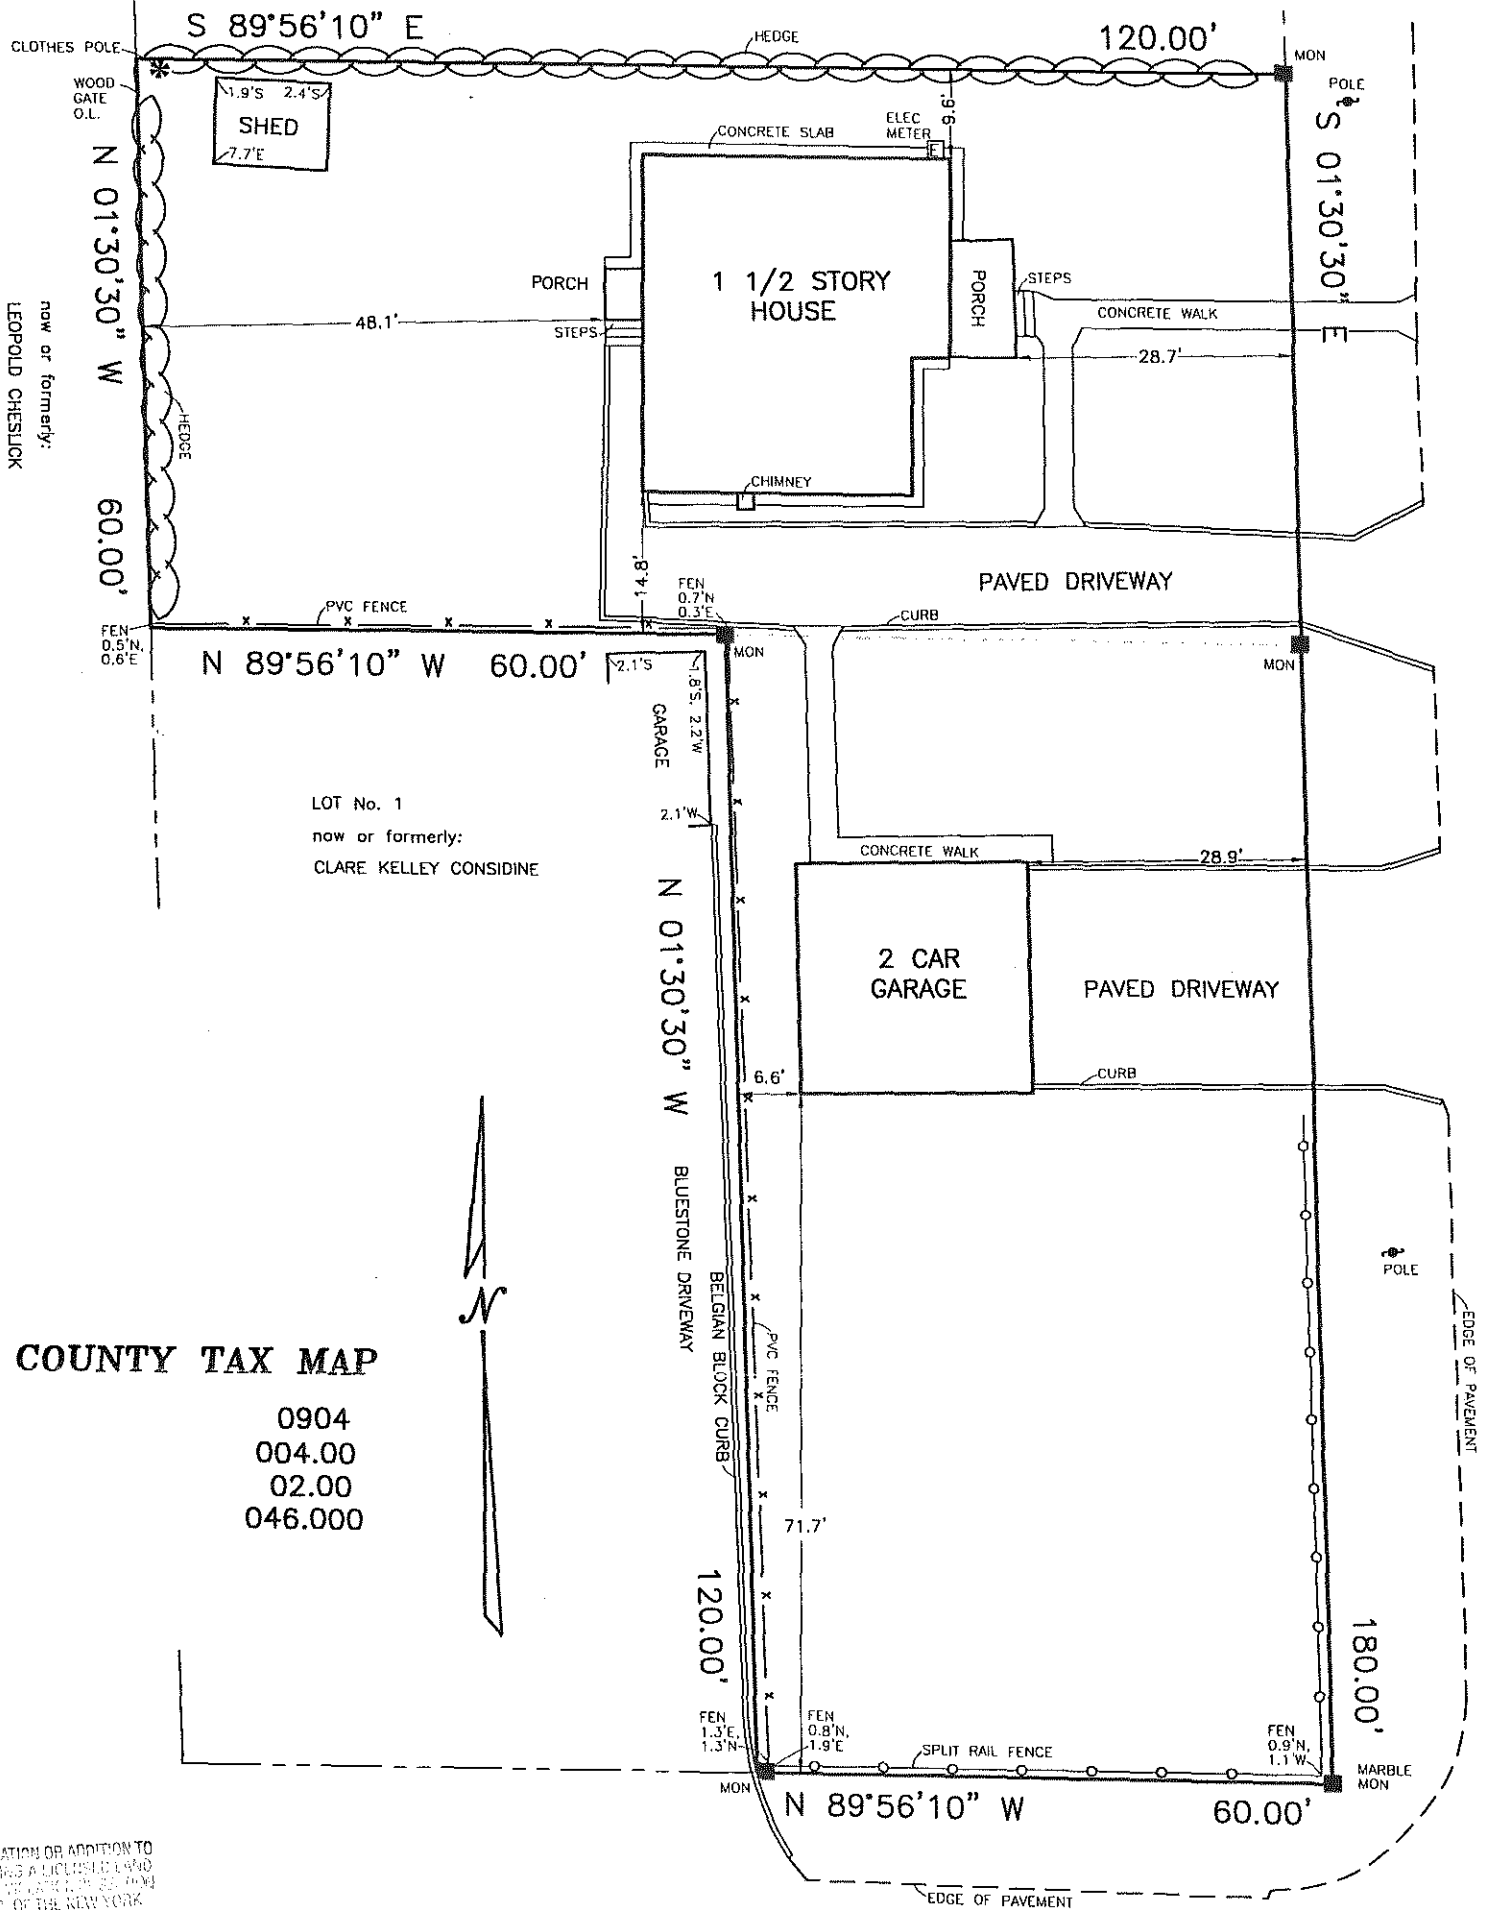

**SUFFOLK COUNTY TAX MAP**

|          |         |
|----------|---------|
| DISTRICT | 0904    |
| SECTION  | 004.00  |
| BLOCK    | 02.00   |
| PARCEL   | 046.000 |

UNAUTHORIZED ALTERATION OR ADDITION TO A CHAINED AND PLANNED A LIGULATED LAND SURVEY MAP NOT BEARING THE SURVEYOR'S SIGNATURE AND SEAL SHALL NOT BE CONSIDERED TO BE A VALID SURVEY MAP. THE SURVEYOR'S SIGNATURE AND SEAL SHALL NOT BE CONSIDERED TO BE A VALID SURVEY MAP. THE SURVEYOR'S SIGNATURE AND SEAL SHALL NOT BE CONSIDERED TO BE A VALID SURVEY MAP.



SURVEYED: NOVEMBER 30, 2016

LESTER HOLDEN, L.S. No. 49548  
S. H. W. AND S., LAND SURVEYORS, P.C.

**SQUIRES, HOLDEN, WEISENBACHER & SMITH**  
LAND SURVEYING ~ LAND PLANNING ~ ENGINEERING  
SOUTHAMPTON ~ NEW YORK

**MAP OF LOT Nos. 2 & 3**  
**SUBDIVISION MAP OF**  
**AMENDED MAP "A"**  
**NORTON HEIGHTS**  
MAP No. 589 ~ FILED: APRIL 28, 1931

FOR  
**AUDREY WELTE**  
SITUATE  
**INC. VILLAGE OF SOUTHAMPTON**  
TOWN OF SOUTHAMPTON  
SUFFOLK COUNTY, NEW YORK

AREA = 14,395 S.F. (0.330 ACRE)

SCALE: 1" = 20'