


GUARANTEES OR CERTIFICATIONS ARE NOT TRANSFERABLE. UNDERGROUND UTILITIES EASEMENTS NOT SHOWN AND UTILITY POLE LOCATIONS ARE NOT GUARANTEED. THE OFFSET DIMENSION SHOWN HEREON FROM THE STRUCTURES TO THE PROPERTY LINES ARE FOR SPECIFIC PURPOSE AND USE, THEREFORE ARE NOT INTENDED TO GUIDE THE ERECTION OF FENCES, RETAINING WALLS, POOLS, PATIOS, PLANTING AREAS, ADDITION TO BUILDINGS AND OTHER CONSTRUCTION. THE EXISTENCE OF RIGHT OF WAYS, WETLANDS AND/OR EASEMENTS OF RECORD, IF ANY, NOT SHOWN ARE NOT GUARANTEED. UNAUTHORIZED ALTERATION OR ADDITION TO THIS SURVEY IS A VIOLATION OF SECTION 7209 OF THE NEW YORK STATE EDUCATION LAW. COPIES OF THIS SURVEY MAP NOT BEARING THE LAND SURVEYORS SIGNATURE AND RED INK OR EMBOSSED SEAL SHALL NOT BE CONSIDERED A TRUE VALID COPY. ALL LOCATIONS OF AND DISTANCES TO WELLS AND CESSPOOLS ARE BY LOCATIONS FROM HOMEOWNERS, FIELD OBSERVATIONS AND/OR INFORMATION OBTAINED FROM OTHERS. SINCE MOST ARE NOT VISIBLE THESE LOCATIONS AND DIMENSIONS CANNOT BE CERTIFIED.

SURVEY OF LOT 14
MAP OF NORTH HAVEN HILLS
SITUATED AT
VILLAGE OF NORTH HAVEN,
TOWN OF SOUTHAMPTON
SUFFOLK COUNTY, NEW YORK

F: 05/14/1980 MAP NO. 6901
S.C.T.M. NO. 901-2-4-4
AREA = 80,099 SQ. FT.
EXIST. LOT CLEARING = 23,854 SQ. FT./29.8%
EXIST. LOT COVERAGE = 4,016 SQ. FT./5%
CERTIFIED TO:
STEWART TITLE INSURANCE COMPANY
HSBC BANK USA, N.A.

NORTH HAVEN WAY
(80' WIDE)

SUNSET BEACH ROAD

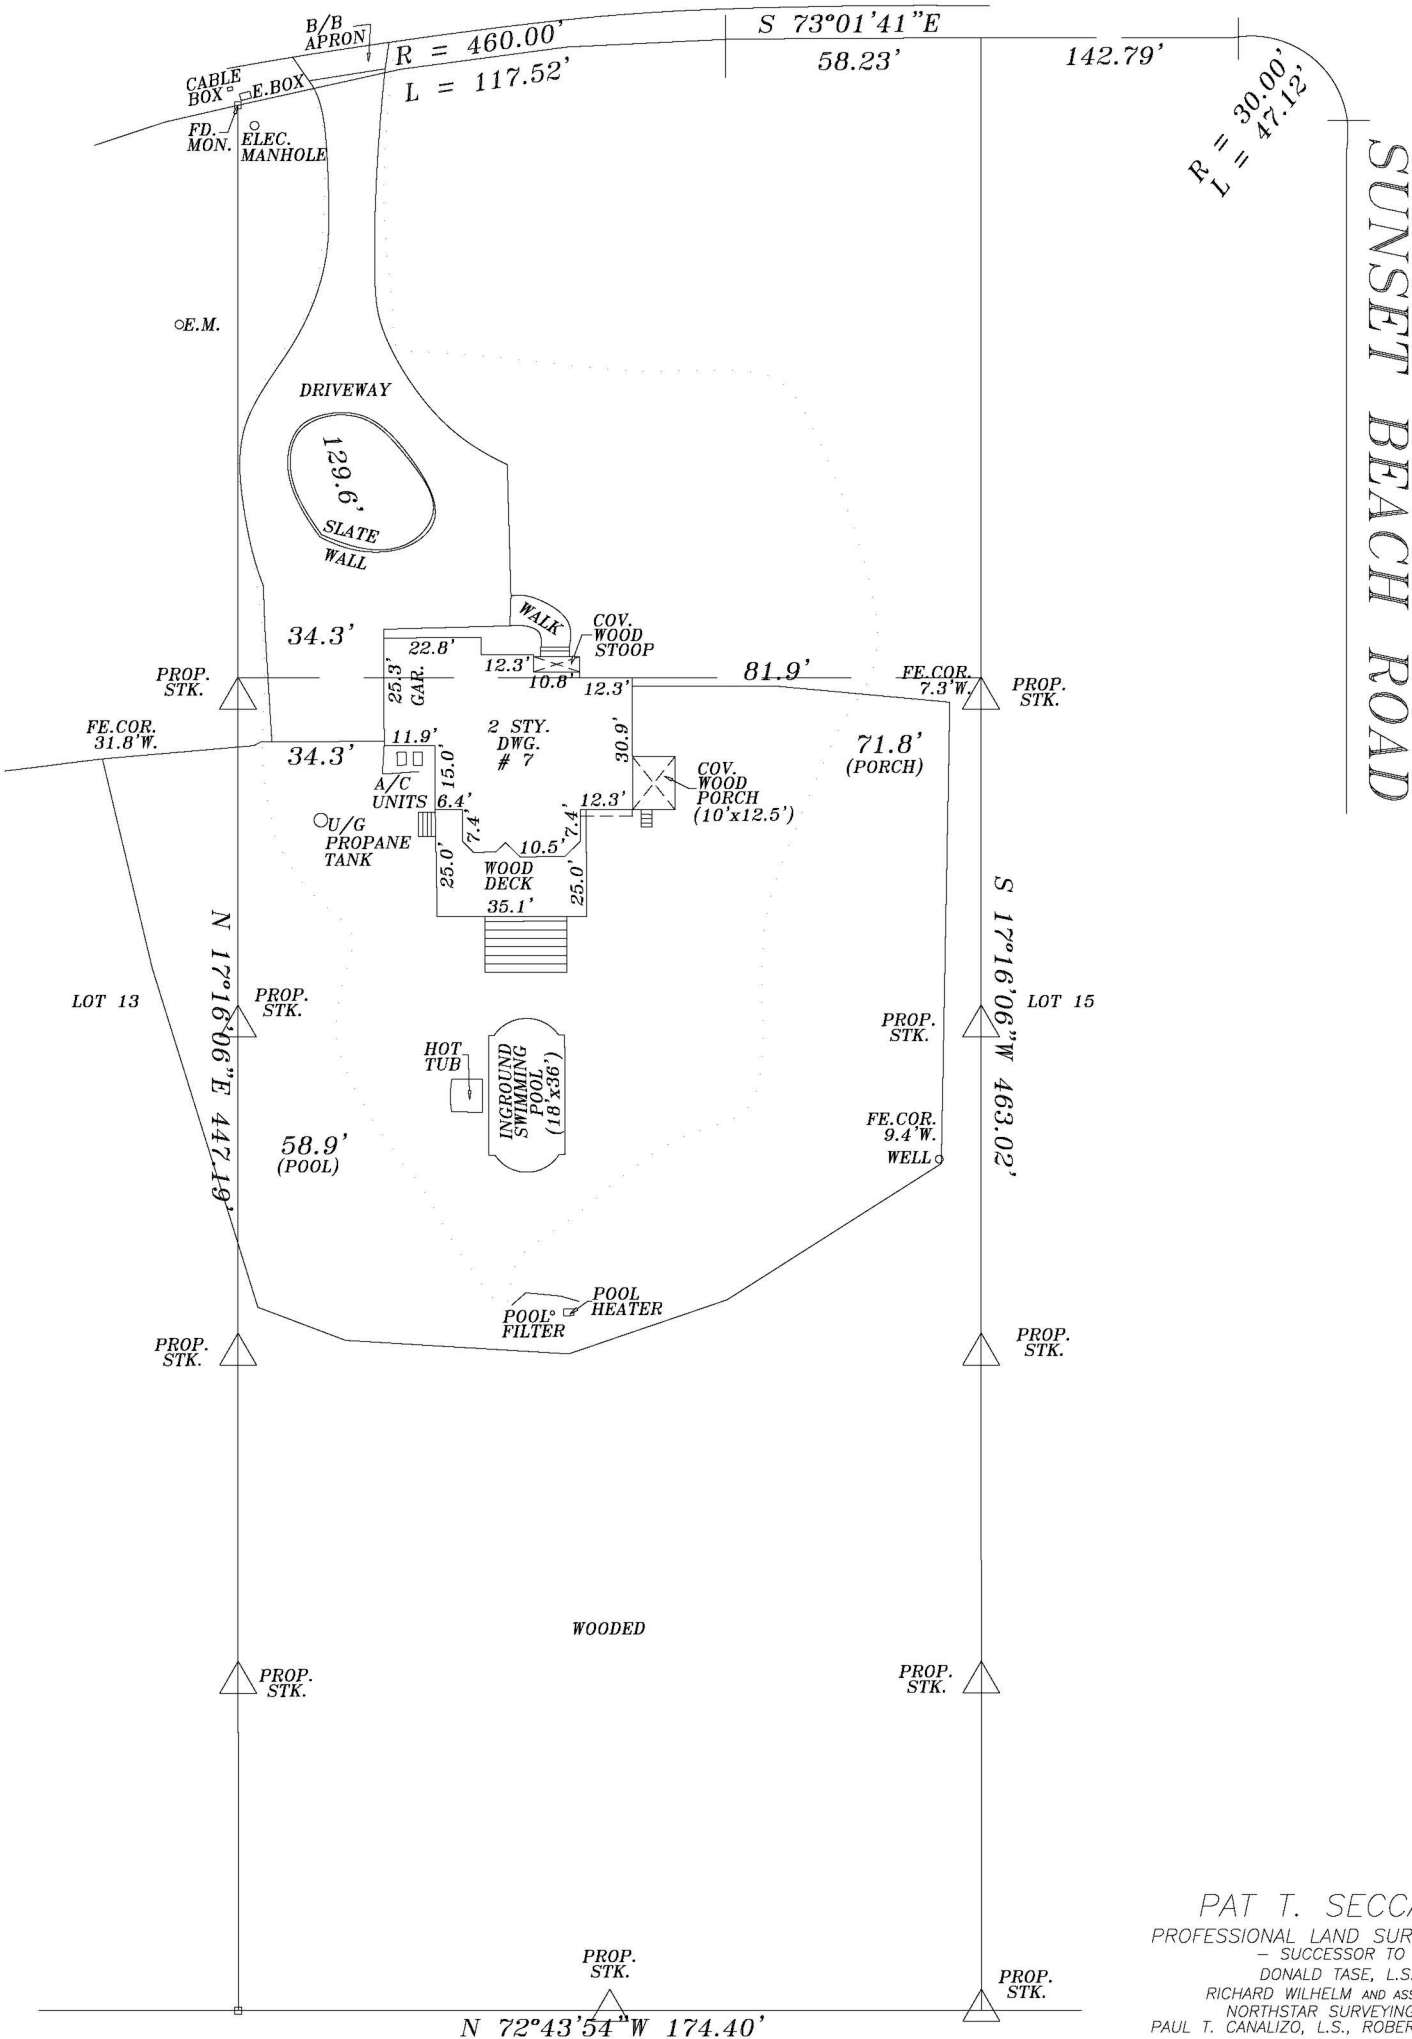

PAT T. SECCAFICO
PROFESSIONAL LAND SURVEYOR, P.C.
- SUCCESSOR TO -
DONALD TASE, L.S.
RICHARD WILHELM AND ASSOCIATES
NORTHSTAR SURVEYING, P.C.
PAUL T. CANALIZO, L.S., ROBERT A. KART, L.S.
GOOD GROUND SURVEYORS, P.C.

328A Main Street
Center Moriches, NY 11934
Phone: (631) 878-0120
Fax: (631) 878-7190
Hampton Atrium Unit D-4
186 W. Montauk Highway
Hampton Bays, NY 11946
Phone: (631) 728-5330
Fax: (631) 728-6707

N.Y.S. LIC. NO. 049287
COPYRIGHT - 2012 PAT T. SECCAFICO P.L.S., P.C.