


REFER TO FILED MAP NO. 315 (Sept. 4, 1901)
IN THE COUNTY CLERK'S OFFICE

POOL Hse 6594
6362 POOL.

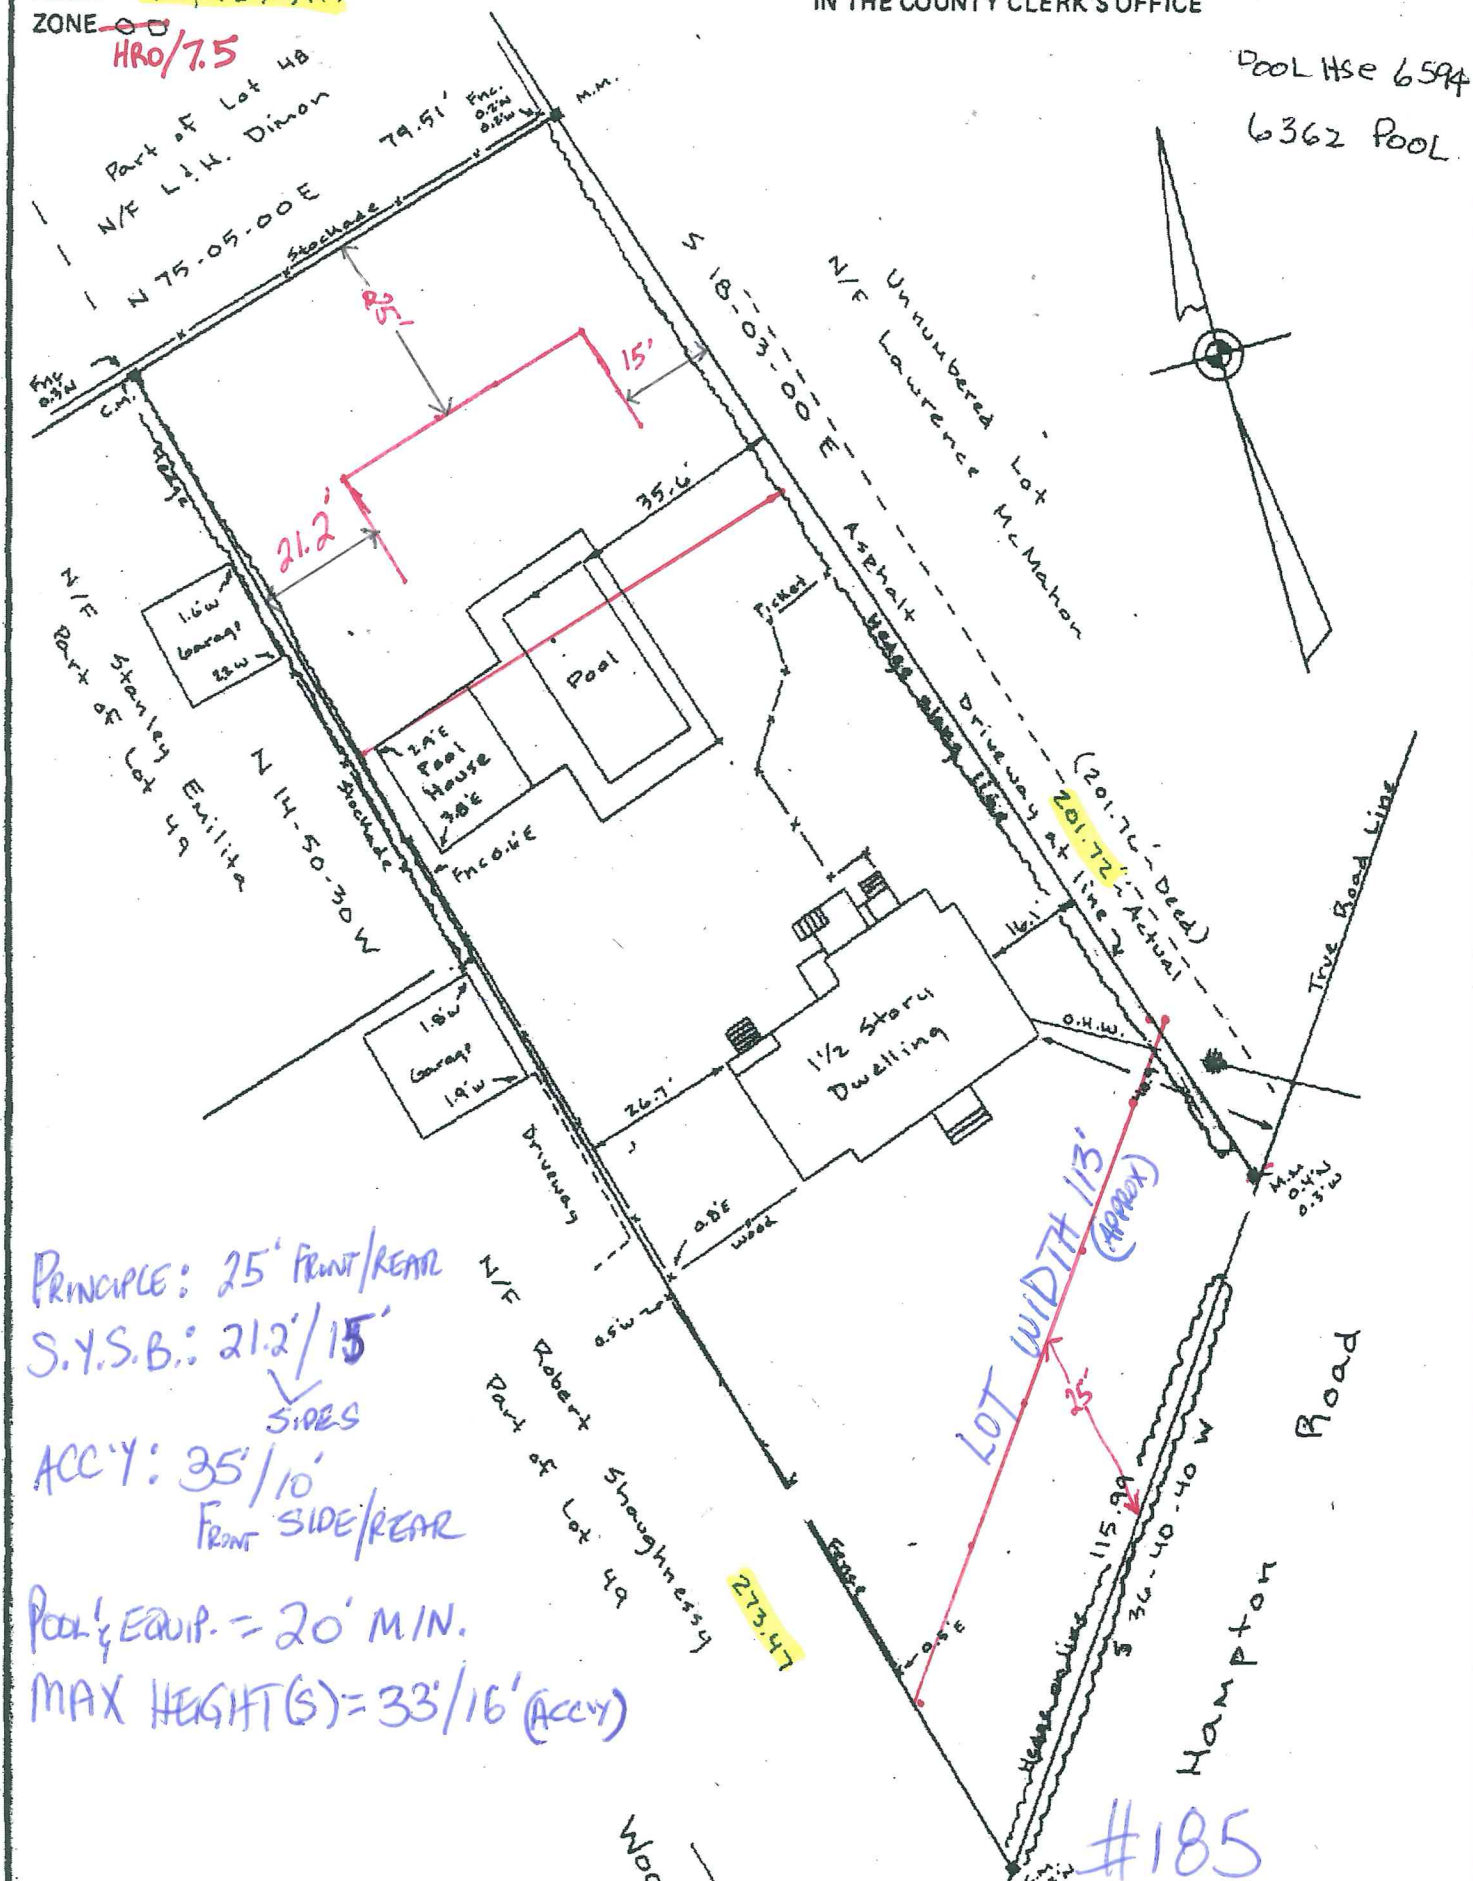

PRINCIPLE: 25' FRONT/REAR
S.Y.S.B.: 21.2' / 15'
SIDES
ACCY: 35' / 10'
FRONT SIDE/REAR
POOL & EQUIP. = 20' MIN.
MAX HEIGHT(S) = 33' / 16' (ACCY)

Part of Lot 48 Map of
Property of Van Brunt & Goodale
Village of Southampton

CERTIFIED TO:
Tim & Lindsey Mullen

WILLIAM G. LOWE
LICENSE NO. 49179

UNAUTHORIZED ALTERATION OR ADDITION TO
THIS DOCUMENT IS A VIOLATION OF SECTION
705 OF THE NEW YORK STATE EDUCATION
LAW

COPIES OF THE JOURNAL MAY NOT BEARND
THE LATE 1940S. THE JOURNAL MAY BE
CONSIDERED TO BE A VALUABLE

GRANTING HEREIN HERON SHALL RUN ONLY TO THE EXTENT OF THE SURVEY TITLED "SPECIAL INVESTIGATION OF THE TITLE INSURANCE COMPANY AND ASSOCIATED COMPANIES IN NEW YORK AND TO THE EXTENT OF THE LANDS INSTITUTION, WHICH ARE NOT TRANSFERABLE AS FINANCIAL INSTITUTIONS OR SUBSEQUENT OWNERS."

THIS INFORMATION IS UNCLASSIFIED
DATE 01-11-2011 BY 60322 UCBAW/STP

DELLINGER ASSOCIATES
BOOK-BINDERS
WASHINGTON 25, D. C.

PREPARED 11-25-92 SURVEYED Nov. 23 1992 & June 19 1998

SCALE 1" = 30'

■ DENOTES MONUMENTS

Δ DENOTES STAKES

BK 99 PG 37.38