

**CERTIFIED TO: MICHAEL AND LORI PRIMASING FAMILY TRUST
STEWART TITLE INSURANCE COMPANY**


JOB NO.: 2015-193
MAP NO.:
FILED:
REVISIONS:
ADD ELEV. POINTS FOR ARCH. 6/22/15
PREP FOR PERMITS 6/25/15
FINAL SURVEY: 8/22/16

HANDS ON SURVEYING
26 SILVER BROOK DRIVE
FLANDERS, NEW YORK
11901
TEL: (631)-369-8312 - FAX: (631)-369-8313
MARTIN D. HAND L.S.

COPIES OF THIS SURVEY MAP, EITHER PAPER OR ELECTRONIC, NOT BEARING THE LAND SURVEYORS INKED SEAL OR EMBOSSED SEAL SHALL NOT BE CONSIDERED TO BE A VALID COPY AND SHALL NOT BE USED FOR ANY PURPOSES.



SANITARY, AND DRYWELL LOCATIONS AS PER INSTALLER
WATERLINE LATERAL LOCATION AS PER BUILDER

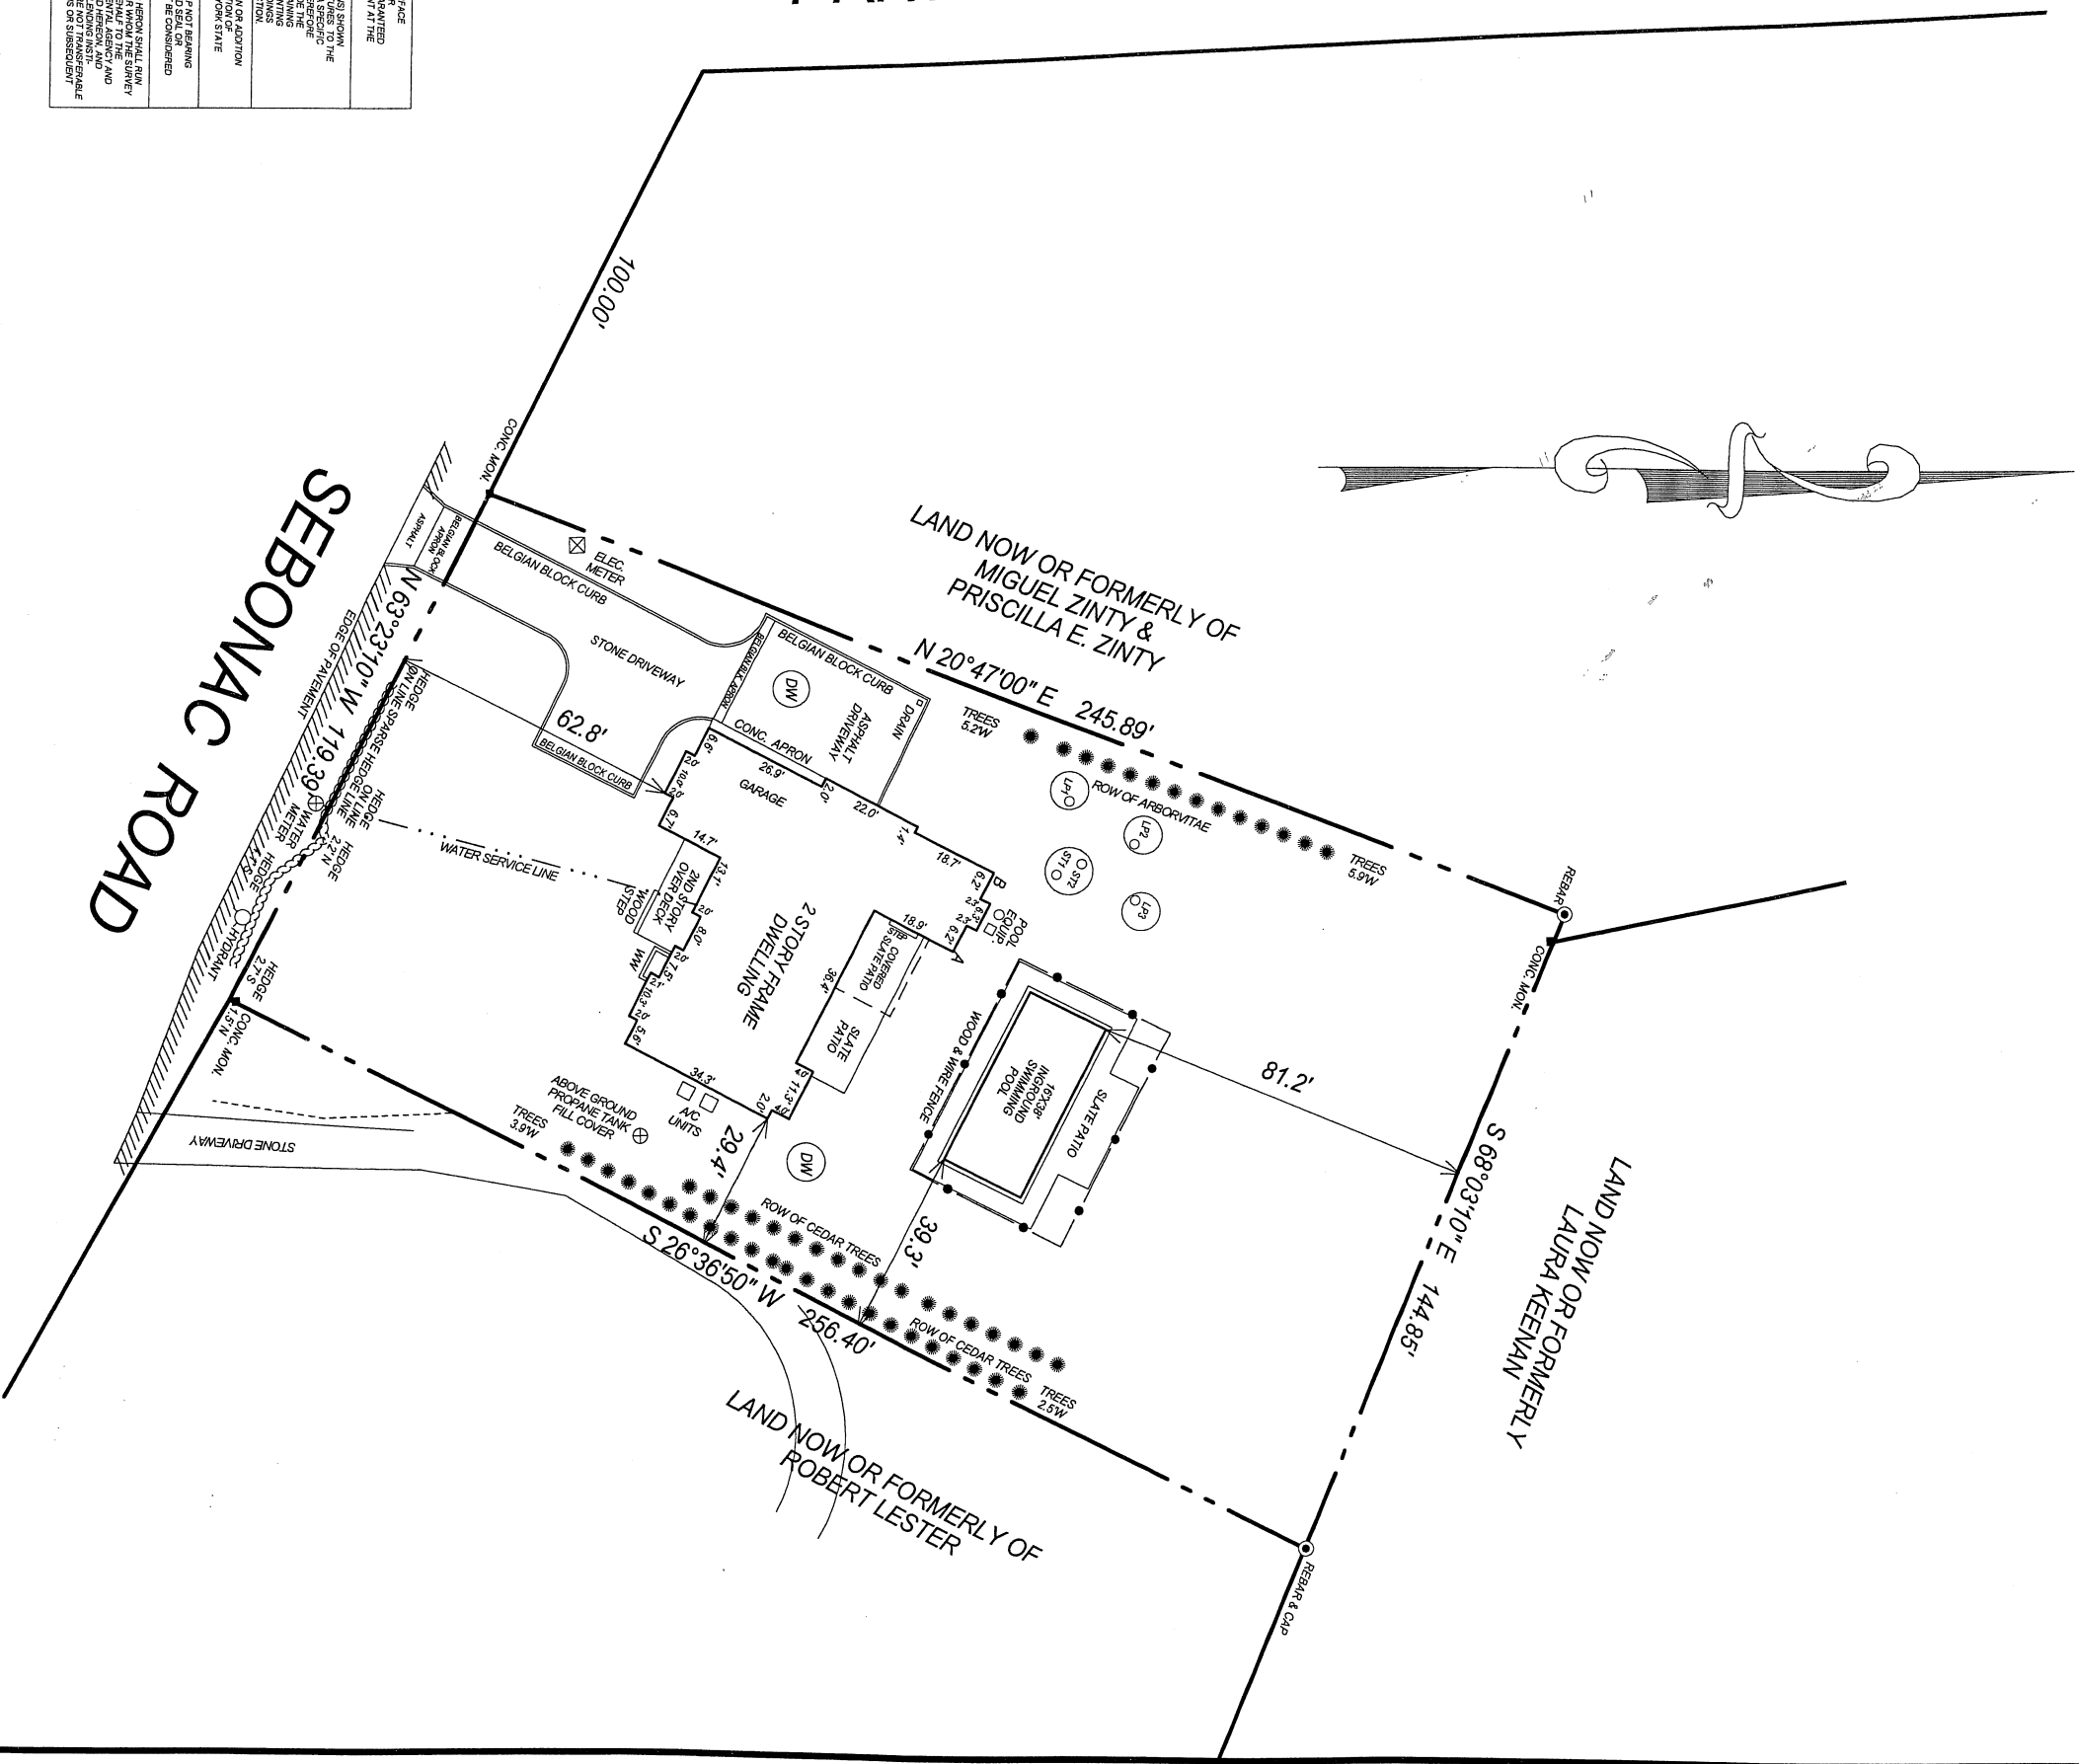

EASING/REDOOR SITUATION: THE CONTRACTOR SHALL BE RESPONSIBLE FOR OBTAINING ALL NECESSARY PERMITS AND APPROVALS FROM THE CITY OF CHICAGO, ILLINOIS, AND THE STATE OF ILLINOIS, WITHOUT WHICH THE PROJECT CANNOT BE COMPLETED. THE CONTRACTOR SHALL BE RESPONSIBLE FOR OBTAINING ALL NECESSARY PERMITS AND APPROVALS FROM THE CITY OF CHICAGO, ILLINOIS, AND THE STATE OF ILLINOIS, WITHOUT WHICH THE PROJECT CANNOT BE COMPLETED.