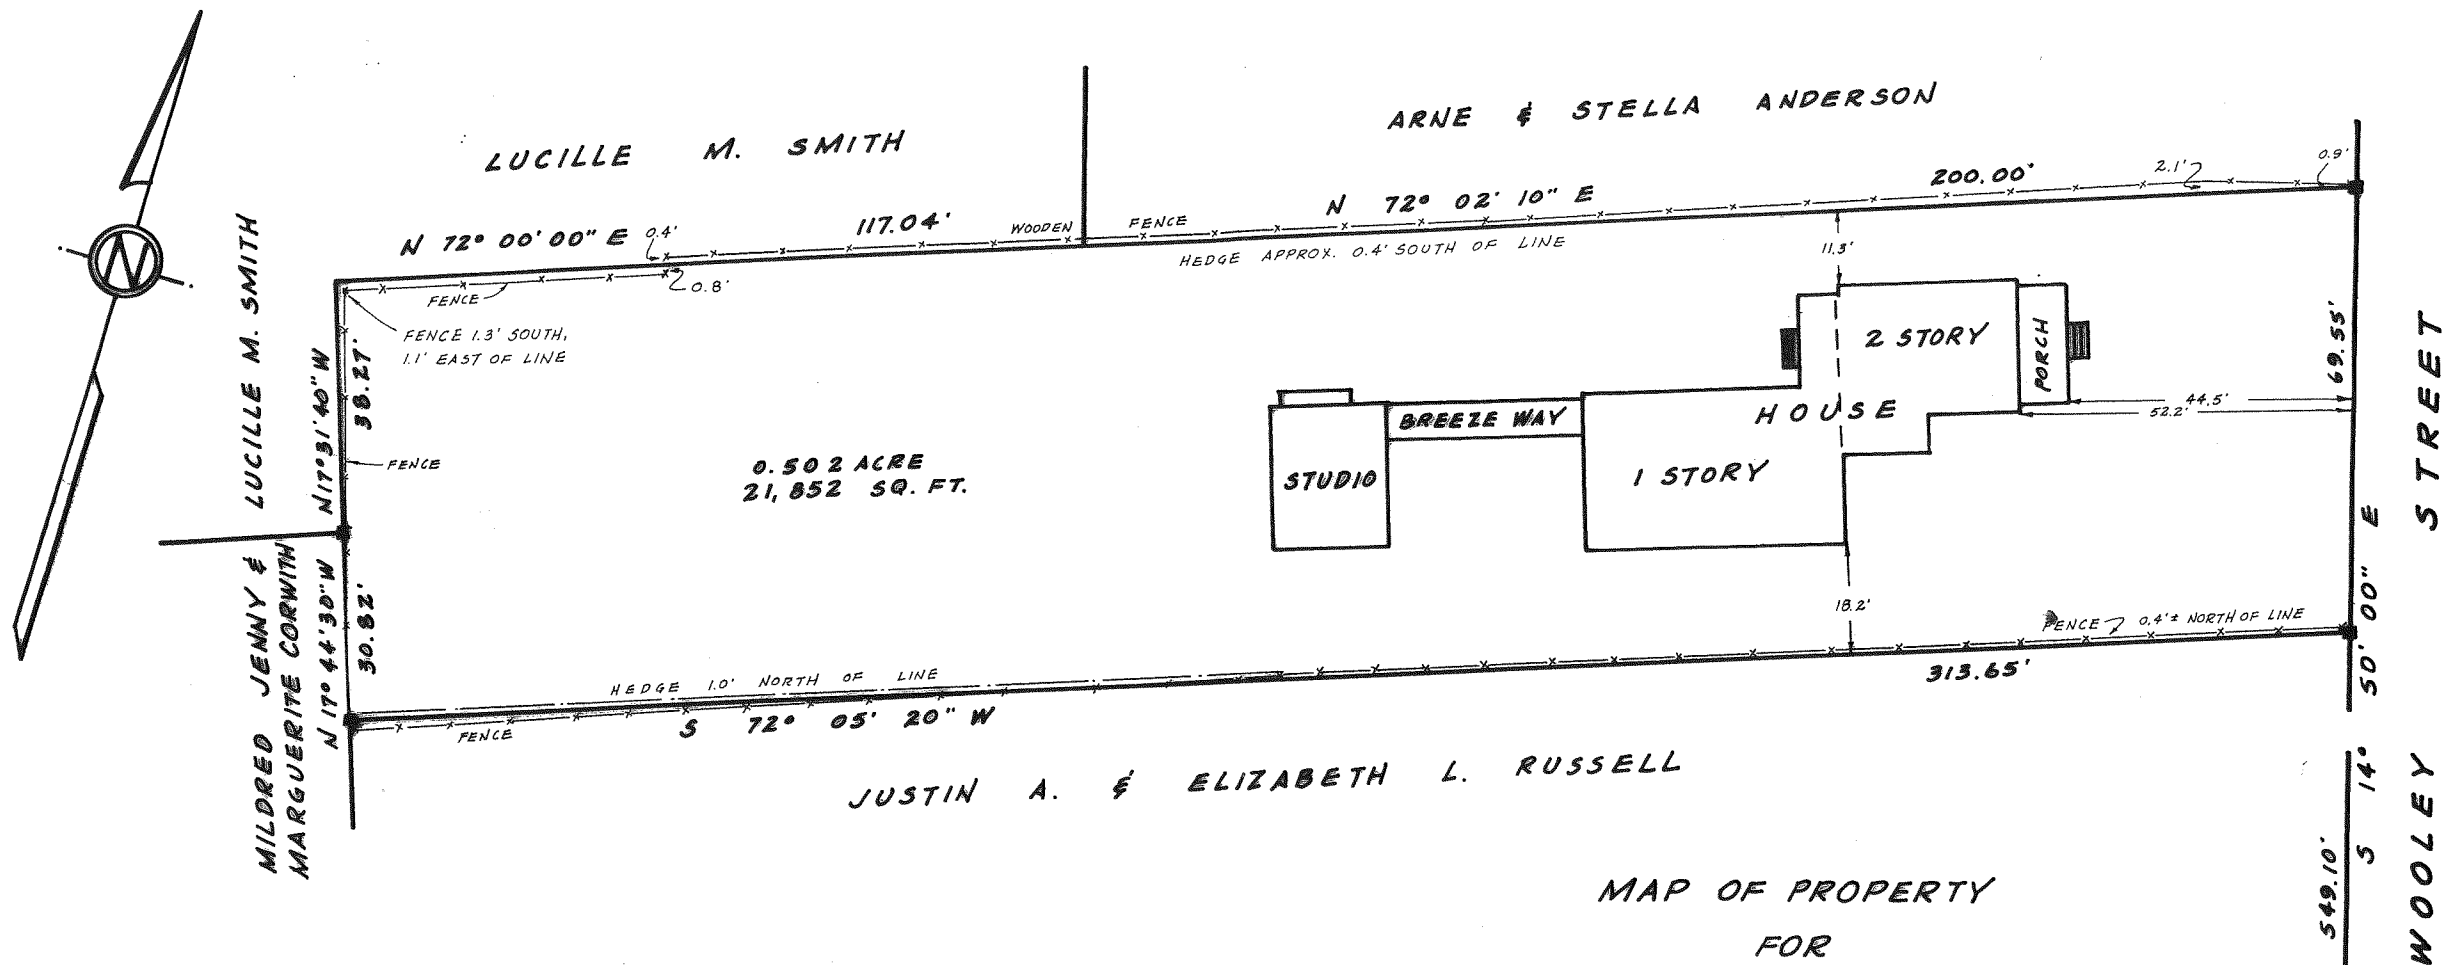


SUFFOLK COUNTY TAX MAP

DISTRICT; 0904
SECTION; 007.00
BLOCK; 02.00
PARCEL; 025.000

BOOK ~ PAGE
375 123-126

■ DENOTES MONUMENT

SCALE: 1" = 30'

KARL W. WEISENBACHER L.S. No. 36195
S.H.W. & S., LAND SURVEYORS, P.C.
SQUIRES, HOLDEN, WEISENBACHER & SMITH
LAND SURVEYORS ~ ENGINEERS
SOUTHAMPTON ~ NEW YORK

MAP OF PROPERTY
FOR
PAUL & DIANE WALDMAN
SITUATE
INC. VILLAGE OF SOUTHAMPTON
TOWN OF SOUTHAMPTON
SUFFOLK COUNTY, N.Y.