

87 EH 184

D5742

627-96

745-80,81

LOT 11
MAP OF

SHOREWOOD

Filed: Oct. 3, 1973 ~ Map 6018

TOWN OF EAST HAMPTON, SUFFOLK CO., N.Y.

Scale: 1"=50'

Land now or late of William Hunting
Vacant

Note: The existence of right of ways
and/or easements of record, if any,
not shown are not guaranteed.

Guaranteed to:
Eastern Federal Savings & Loan Assoc.
Yefim Vaynsheibum
Judith Carlin Vaynsheibum
Royal Abstract Inc.

UNAUTHORIZED ALTERATION OR ADDITION
TO THIS SURVEY IS A VIOLATION OF
SECTION 7209 OF THE NEW YORK STATE
EDUCATION LAW.

COPIES OF THIS SURVEY MAP NOT BEARING
THE LAND SURVEYOR'S INKED SEAL OR
EMBOSSED SEAL SHALL NOT BE CONSIDERED
TO BE A VALID TRUE COPY.

GUARANTEES INDICATED HEREON SHALL RUN
ONLY TO THE PERSON FOR WHOM THE SURVEY
IS PREPARED, AND ON HIS BEHALF TO THE
TITLE COMPANY, GOVERNMENTAL AGENCY AND
LENDING INSTITUTION LISTED HEREON, AND
TO THE ASSIGNEES OF THE LENDING INSTI-
TUTION. GUARANTEES ARE NOT TRANSFERABLE
TO ADDITIONAL INSTITUTIONS OR SUBSEQUENT
OWNERS.


GEORGE H. WALBRIDGE CO.

BY *George H. Walbridge*

Revised: April 6, 1988 - Deck Offset
Revised: March 4, 1988 final
Revised: April 30, 1987 - Stk. Ho.
Revised: April 8, 1987 - Prop Ho. Guar.
Surveyed: April 2, 1987

GEORGE H. WALBRIDGE CO.
Land Surveyors & Land Planners
East Hampton, Long Island, N.Y.

Test Hole	
0. - 3.0	Loam
3.0 - 28.0	Hardpan
28.0 - 34.0	Sand Gravel

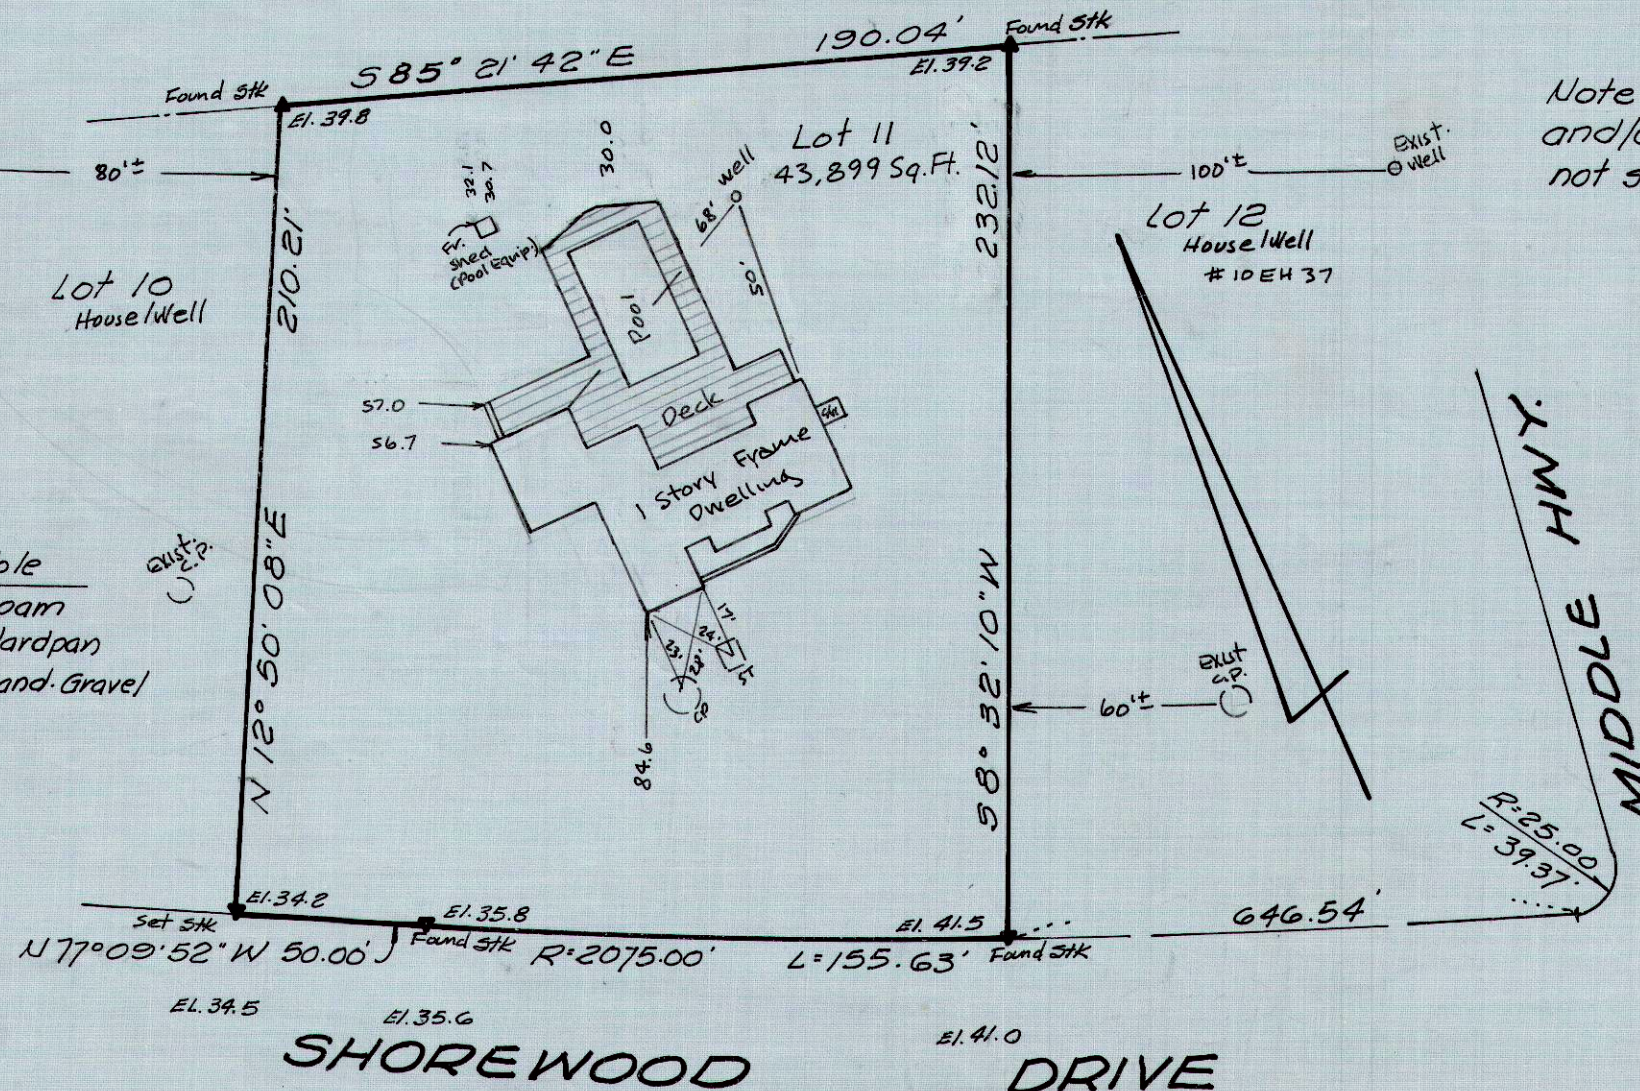

SHOREWOOD DRIVE

Hse. Well

Revised: Mar. 11, 1988
(Nails set in Deck)

Assumed Elev.

T.M. 0300-092-07-8