

**SURVEY OF
LOT 2
MAP OF
LIONSWOOD DEVELOPMENT LLC**
FILE No. 11835 FILED OCTOBER 17, 2011


**SITUATE
REMSENBURG
TOWN OF SOUTHAMPTON
SUFFOLK COUNTY, NEW YORK**
S.C. TAX No. 900-366-01-33.2

SCALE 1"=20'
SEPTEMBER 18, 2014
JANUARY 29, 2020 FINAL SURVEY ON GARAGE


AREA = 44,250 sq. ft.
1.016 ac.

CERTIFIED TO:

KYLE LAUBE
NOEL LAUBE
SAFE HARBOR TITLE AGENCY, LTD
TITLE No. SH146047
RIDGEWOOD SAVINGS BANK

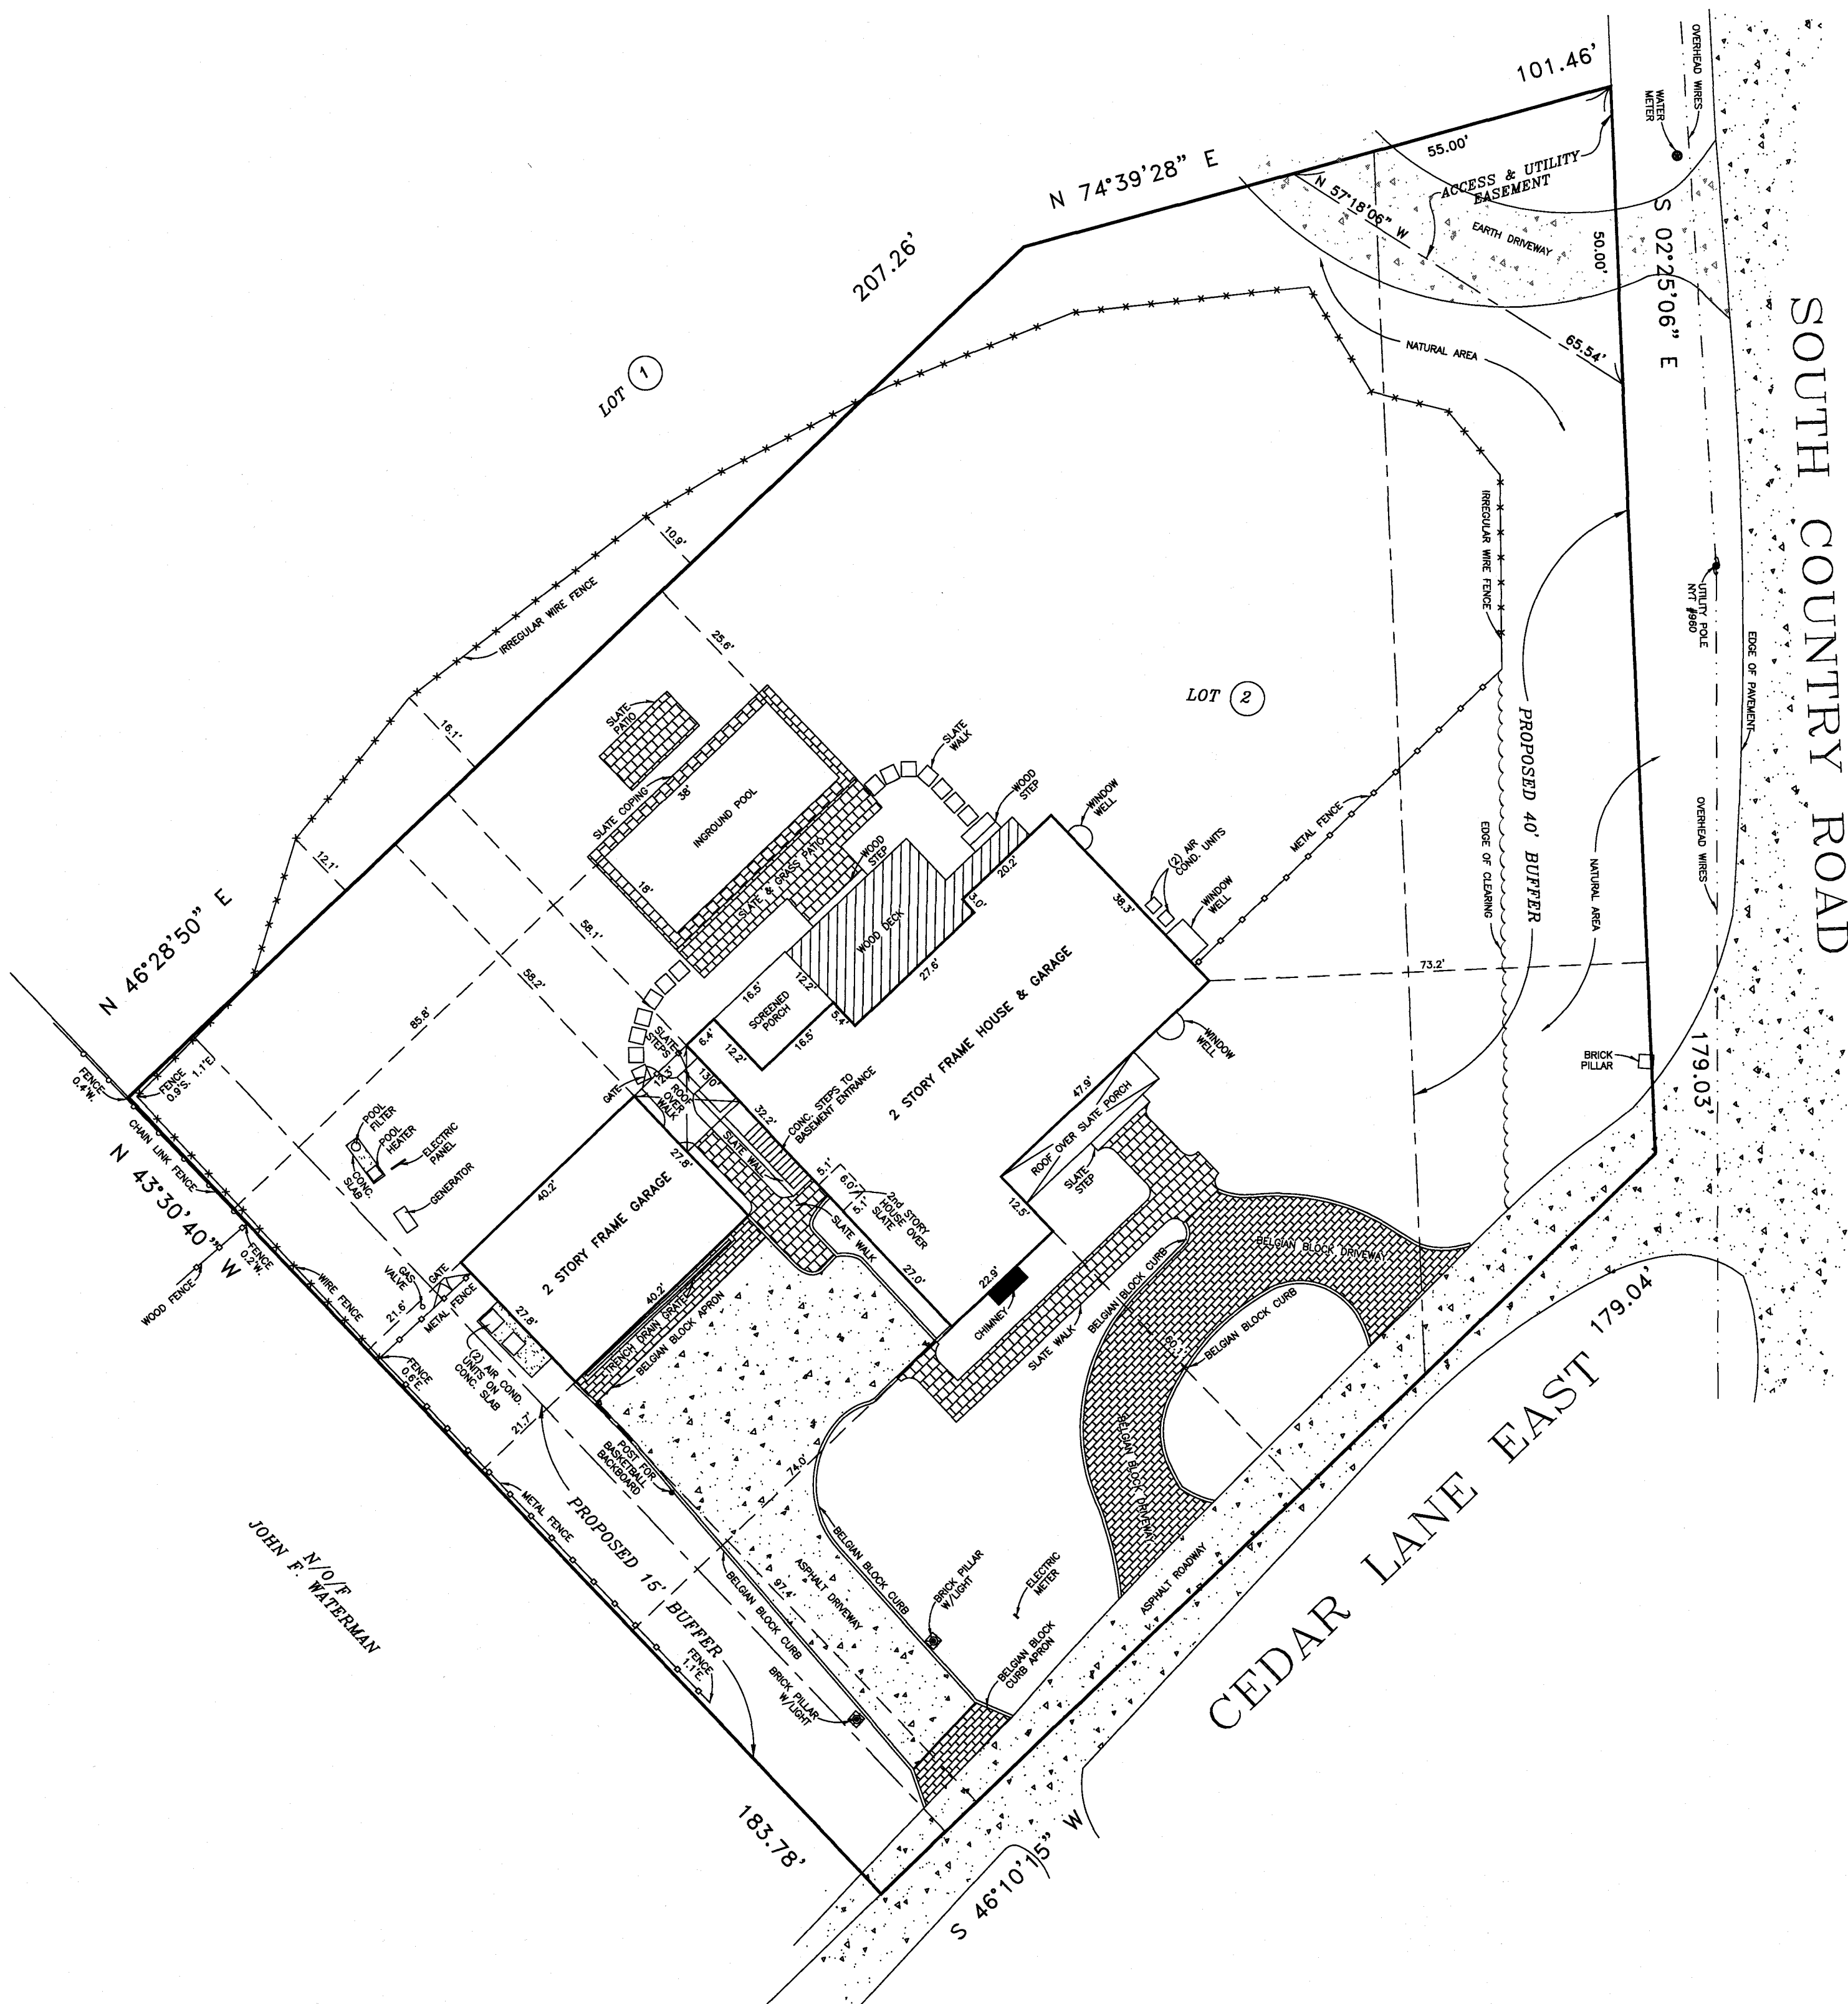

PREPARED IN ACCORDANCE WITH THE MINIMUM
STANDARDS FOR TITLE SURVEYS AS ESTABLISHED
BY THE L.L.A.S. AND APPROVED AND ADOPTED
FOR SUCH USE BY THE NEW YORK STATE LAND
TITLE ASSOCIATION.

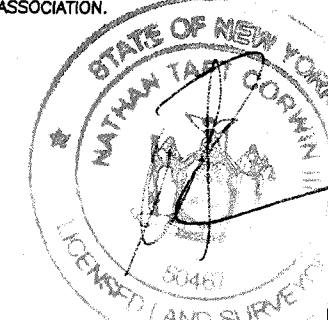

N.Y.S. Lic. No. 50467

UNAUTHORIZED ALTERATION OR ADDITION
TO THIS SURVEY IS A VIOLATION OF
SECTION 7209 OF THE NEW YORK STATE
EDUCATION LAW.

COPIES OF THIS SURVEY MAP NOT BEARING
THE LAND SURVEYOR'S INKED SEAL OR
EMBOSSED SEAL SHALL NOT BE CONSIDERED
TO BE A VALID TRUE COPY.

CERTIFICATIONS INDICATED HEREON SHALL RUN
ONLY TO THE PERSON FOR WHOM THE SURVEY
IS PREPARED, AND ON HIS BEHALF TO THE
TITLE COMPANY, GOVERNMENTAL AGENCY AND
LENDING INSTITUTION LISTED HEREON, AND
TO THE ASSIGNEES OF THE LENDING INSTI-
TUTION. CERTIFICATIONS ARE NOT TRANSFERABLE.

THE EXISTENCE OF RIGHTS OF WAY
AND/OR EASEMENTS OF RECORD, IF
ANY, NOT SHOWN ARE NOT GUARANTEED.

**Nathan Taft Corwin III
Land Surveyor**

Successor To: Stanley J. Isaksen, Jr. L.S.
Joseph A. Ingegno L.S.

Title Surveys — Subdivisions — Site Plans — Construction Layout

PHONE (631)727-2090

Fax (631)727-1727

OFFICES LOCATED AT
1586 Main Road
Jamesport, New York 11947

MAILING ADDRESS
P.O. Box 16
Jamesport, New York 11947