
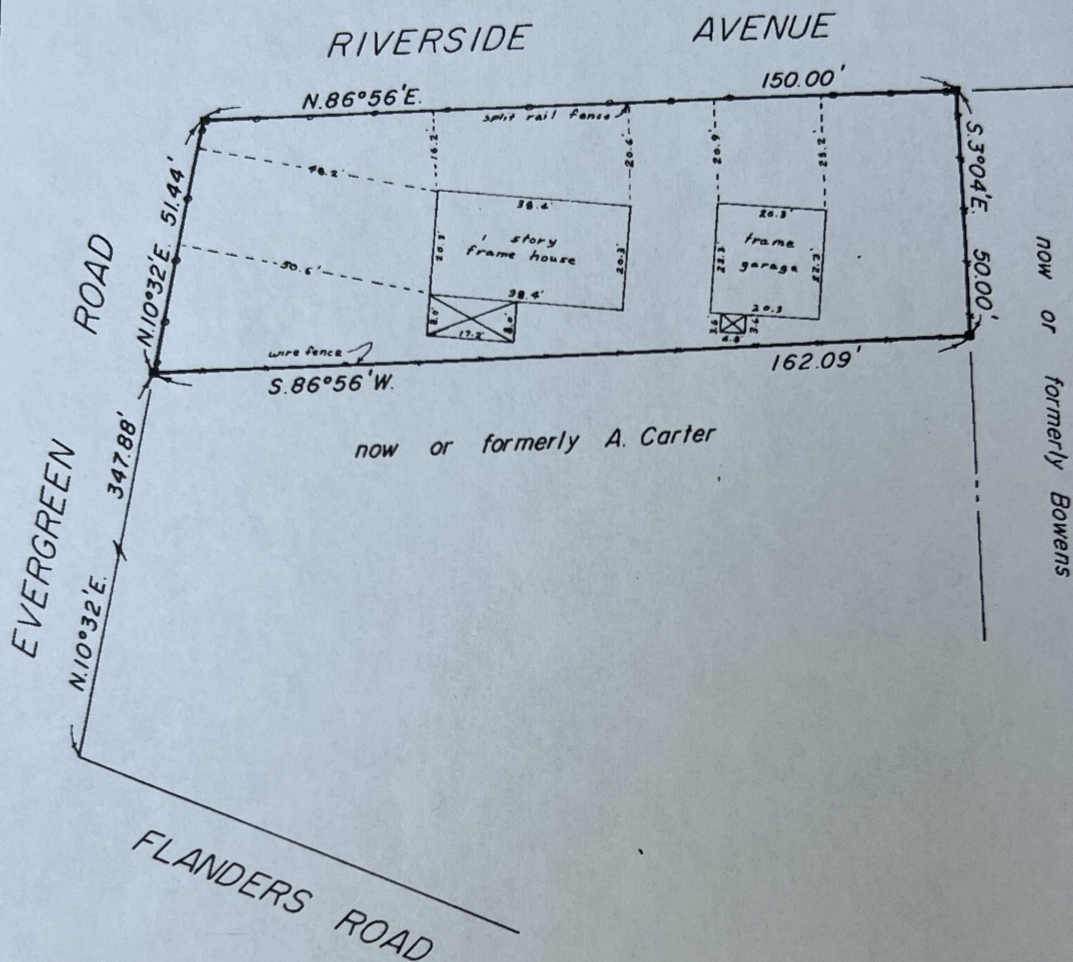


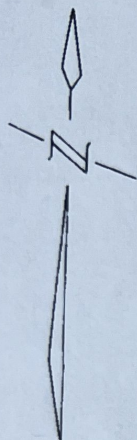


NOTE:
■ = MONUMENT

UNAUTHORIZED ALTERATION OR ADDITION TO THIS SURVEY IS A VIOLATION OF SECTION 7209 OF THE NEW YORK STATE EDUCATION LAW.

COPIES OF THIS SURVEY MAP NOT BEARING THE LAND SURVEYOR'S WRITTEN SEAL OR EMBOSSED SEAL SHALL NOT BE CONSIDERED TO BE A VALID TRUE COPY.

ALL A TIES INDICATED HEREON SHALL RUN OUT TO THE PERSON FOR WHOM THE SURVEY IS MADE, AND ON HIS BEHALF TO THE CITY, COUNTY, GOVERNMENTAL AGENCY AND LITIGANT INSTITUTION LISTED HEREON, AND TO THE ASSIGNEES OF THE LISTED INSTITUTION. GUARANTEES ARE NOT AVAILABLE TO ADDITIONAL INTERESTS ON SUBSEQUENT OWNERS.

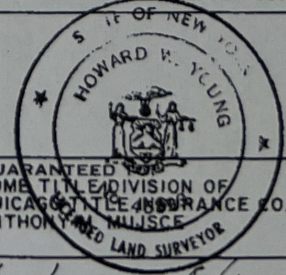REVISIONS		YOUNG & YOUNG 400 OSTRANDER AVENUE, RIVERHEAD, NEW YORK		
		ALDEN W. YOUNG PROFESSIONAL ENGINEER AND LAND SURVEYOR, N.Y.S. LIC. NO. 12845	HOWARD W. YOUNG LAND SURVEYOR N.Y.S. LIC. NO. 45893	
		SURVEY FOR: ANTHONY M. MUJSCE		
		AT FLANDERS		
		TOWN OF SOUTHAMPTON		
		SUFFOLK CO., N. Y.		
		SCALE: 1" = 30'	DATE: JUNE 9, 1973	BY: <i>Howard W. Young</i>
		NO. 73-527		