


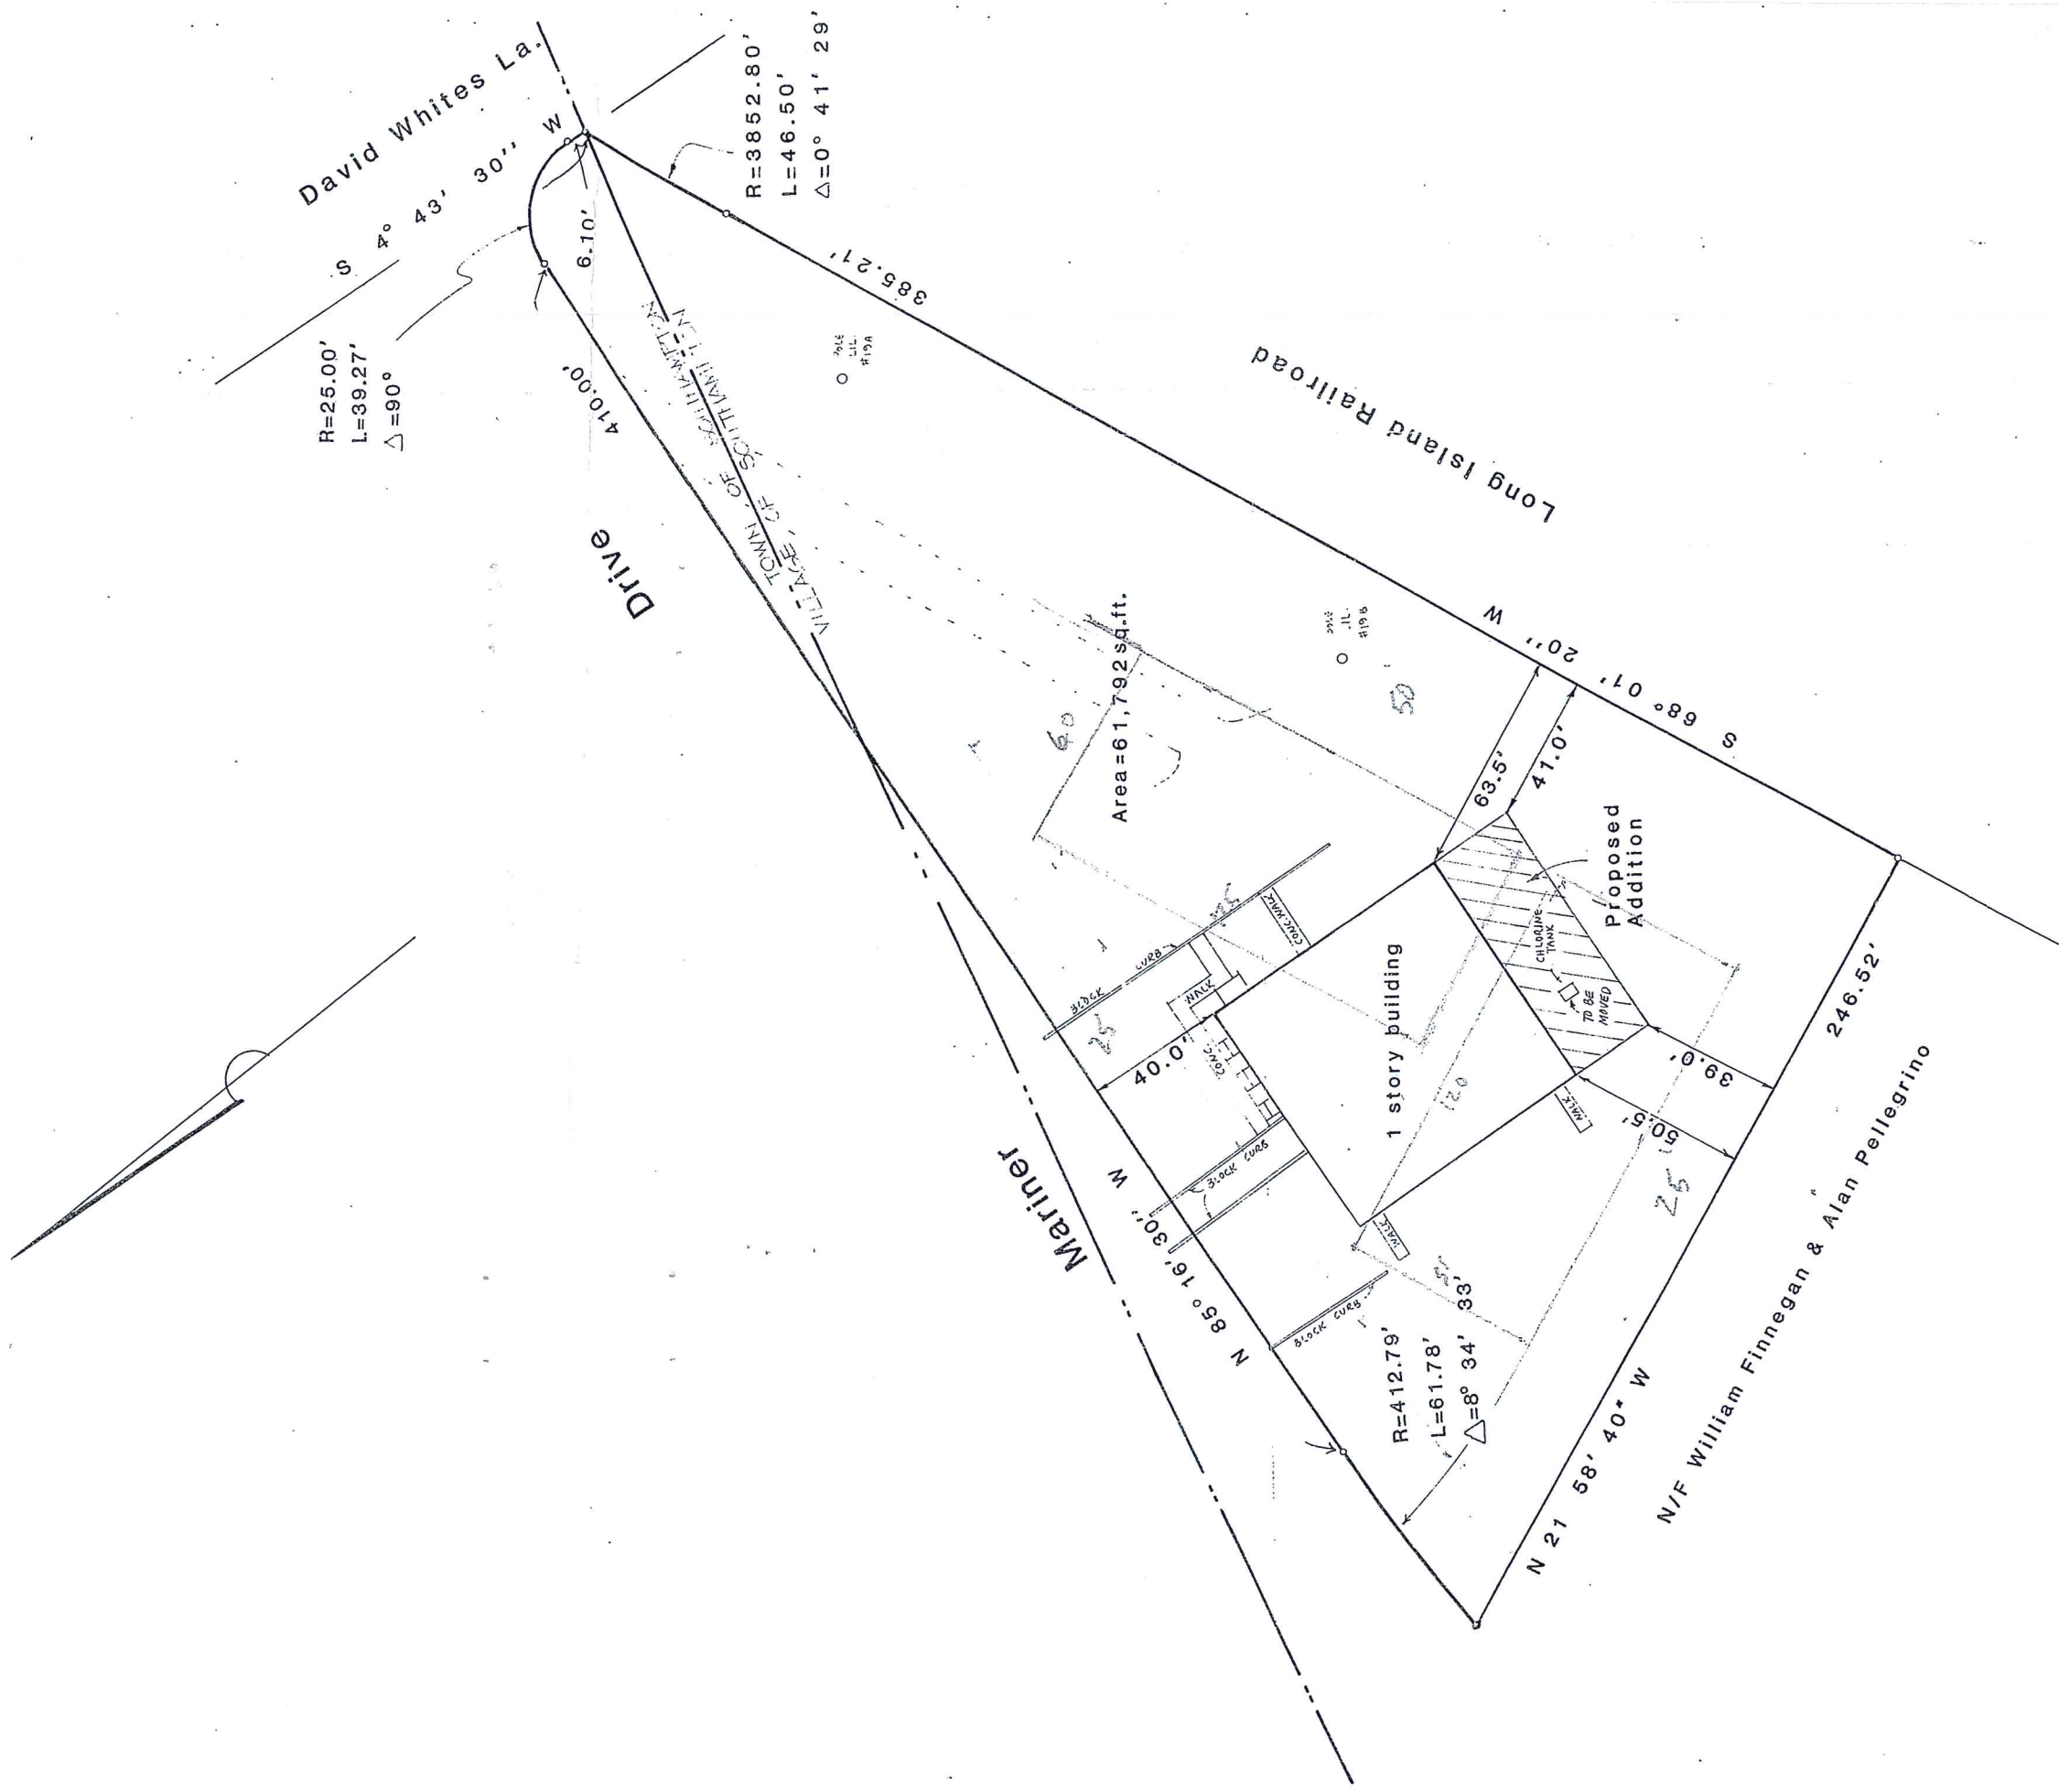

Map of Property
for


Thomas P. Lavinio

Situate

Inc. Village of Southampton
Suffolk County, N.Y.

Scale: 1" = 50'

Revised: January 15, 1986
Surveyed: Nov. 25, 1981
Revised: Jan. 18, 1982
Revised: Jan. 19, 1982 (foundation)
Revised: February 11, 1982, March 8, 1982
Re-Surveyed: June 13, 1983

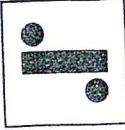

John J. Raynor, P.E.
CIVIL ENGINEER
Water Mill, N.Y. 11976

John J. Raynor

ORIGINAL COPY IN
ZS 1160 HAS STAMP
PRESSED INTO PAPER.

DM 2/19/21

Tax Map No.:

0904-09-02-15.21
0900-132-02-49.9