

SLIP  
1965

11/16/69

NOTES

NO OFFICIAL SURVEY OR ESTABLISHED  
POINTS TO FOUNDATION  
FIRST FLOOR ELEVATION  
ELEVATION OF FIRST FLOOR  
APPROXIMATE LINE OF NO  
UTILITIES AND AVAILABLE WATER ELECTRIC  
DWELLING UNDER CONSTRUCTION FROM JAN 20 1969  
INCLUDING COMPLETED NOV 18 1969  
UTILITY ELEVATIONS IF ANY NOT SHOWN  
AS INDICATED TO THE

FEDERAL INSURANCE ADMINISTRATION  
PROPERTY ADMINISTRATION  
WILLIAMS BURNHILL SHAW'S BROS  
CITY TITLE INSURANCE CO  
By


LOT: 405  
MAP OF SECTION FOUR "GREEN BELT PARK"  
COUNTY CLERK'S OFFICE FILED JULY 1 1965

LOCATED AT WOLFSPRINGE SUFFOLK CO. N. Y.

SURVEYED FOR

CONCRETE FOUNDATION

JET LANE

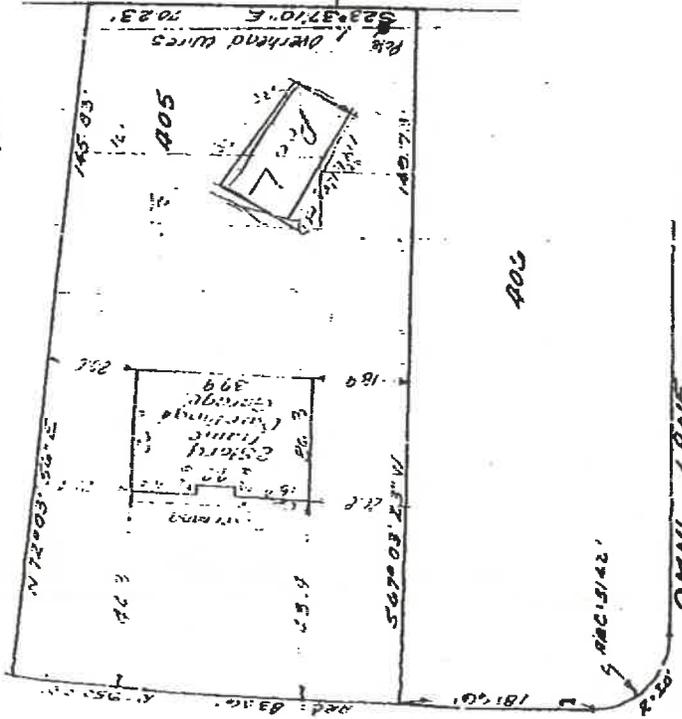

SURVEYED January 20, 1969 BY  
PETER J. VAN WEELE & CO.  
ISLIP, N. Y. F 120 '12'  
DI 6379

FOIL DOCUMENT

178-01-022