


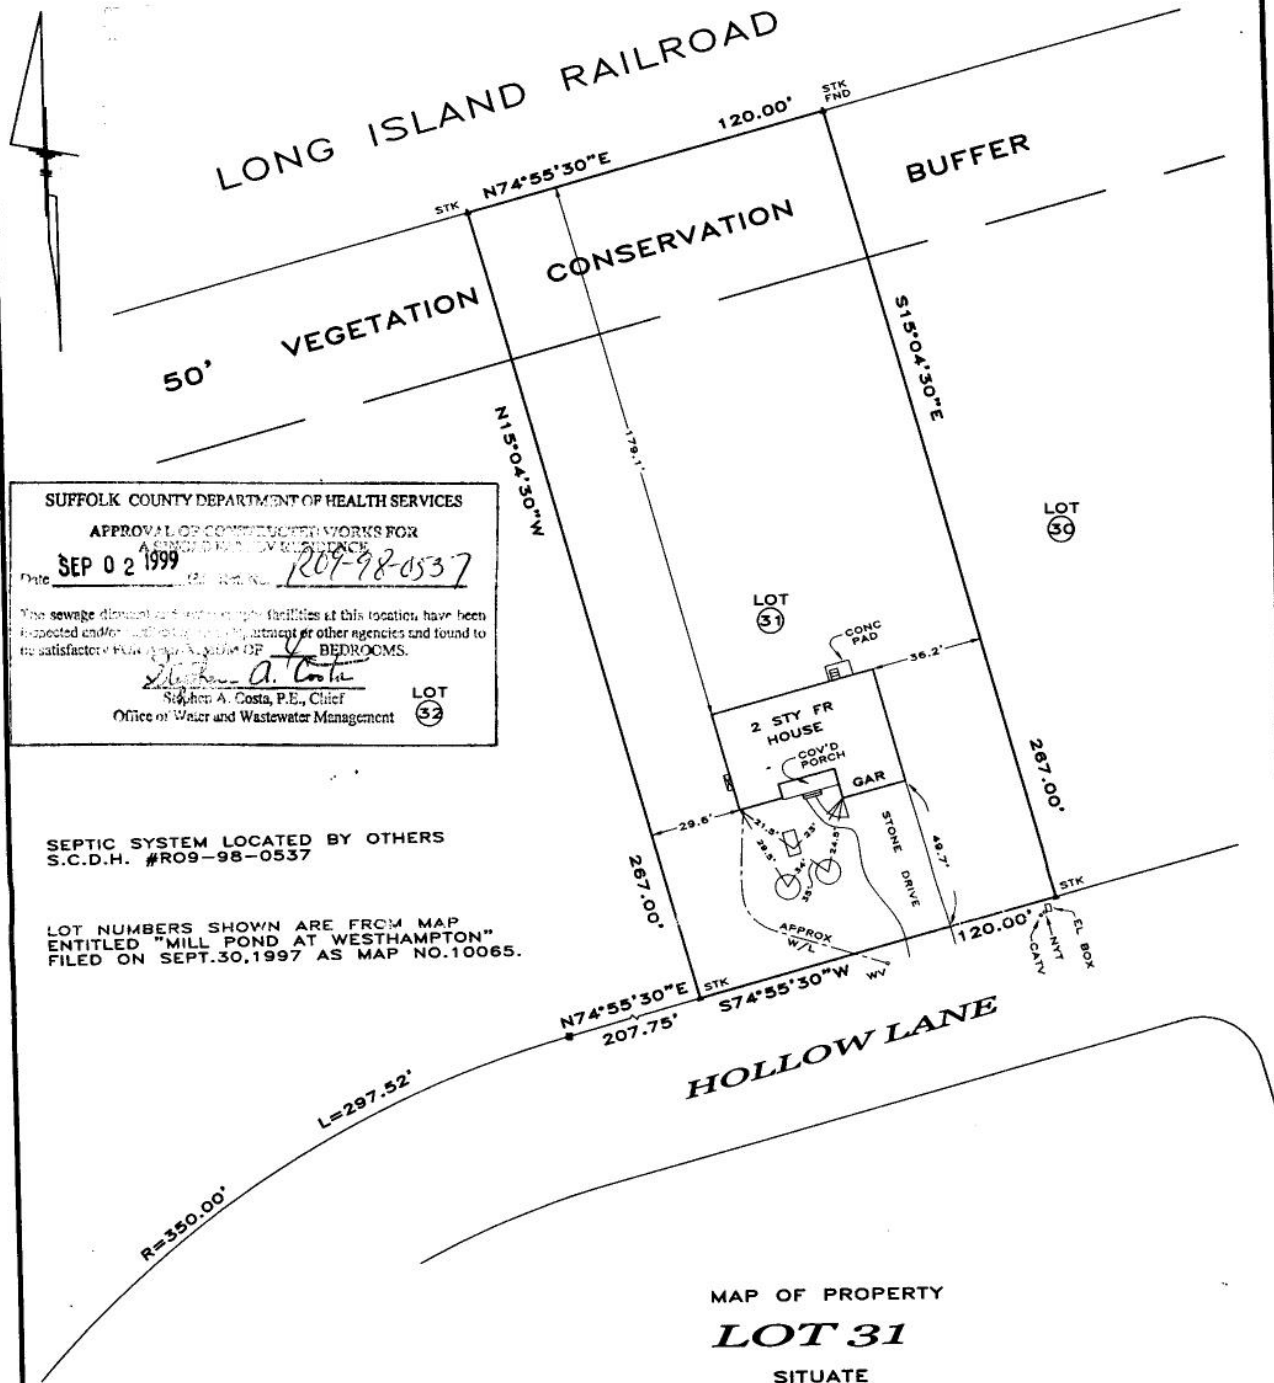

SUFFOLK COUNTY DEPARTMENT OF HEALTH SERVICES
 APPROVAL OF CONSTRUCTION WORKS FOR
 A SEWAGE DISPOSAL FACILITY
 Date **SEP 02 1999** File No. **207-98-0537**
 The sewage disposal and treatment facilities at this location have been
 inspected and found to be in compliance with the requirements of the
 satisfactory Public Health Code of **WESTHAMPTON**.
Stephen A. Costa
 Stephen A. Costa, P.E., Chief
 Office of Water and Wastewater Management

SEPTIC SYSTEM LOCATED BY OTHERS
 S.C.D.H. #R09-98-0537

LOT NUMBERS SHOWN ARE FROM MAP
 ENTITLED "MILL POND AT WESTHAMPTON"
 FILED ON SEPT.30,1997 AS MAP NO.10065.

MAP OF PROPERTY

LOT 31

SITUATE

WESTHAMPTON

TOWN OF SOUTHAMPTON - SUFFOLK COUNTY, N.Y.
 SURVEYED: JAN.11,1999 - SCALE: 1" INCH = 40 FEET
 LOCATION AND FINAL: AUG.10,1999

D40-C-55

TAX	MAP
DISTRICT	0900
SECTION	354
BLOCK	01
LOT	4.31

UNAUTHORIZED ALTERATION OR ADDITION TO A SURVEY
 MAP BEARING A LICENSED LAND SURVEYOR'S SEAL IS A
 VIOLATION OF SECTION 2209, SUB-DIVISION 2, OF THE
 NEW YORK STATE EDUCATION LAW.
 ONLY COPIES FROM THE ORIGINAL OF THIS SURVEY
 MARKED WITH AN ORIGINAL OF THE LAND SURVEYOR'S
 INKED SEAL OR EMBOSSED SEAL SHALL BE CONSIDERED
 TO BE VALID TRUE COPIES.
 CERTIFICATIONS INDICATED HEREON SHALL RUN
 ONLY TO THE PERSON FOR WHOM THE SURVEY IS
 PREPARED, AND ON HIS BEHALF TO THE TITLE
 COMPANY, GOVERNMENTAL AGENCY AND LENDING
 INSTITUTION LISTED HEREON, AND TO THE ASSIGNEES
 OF THE LENDING INSTITUTION. CERTIFICATIONS ARE
 NOT TRANSFERABLE TO ADDITIONAL INSTITUTIONS OR
 SUBSEQUENT OWNERS.

RAYNOR & MARCKS
 SURVEYORS, P.C.
 QUOGUE, N.Y.
 516-653-4066

Joan Pallateri
 Expediting Services
 15 Stephano Road
 East Patchogue, N.Y. 11772
 475-0949

BK:144 PG:55 166/10
 AREA: 32,040 SQ.FT.



D40-C-55
 (SBDATA MPWH31)