

S.C.T.M. No. 900-05-4-53


SURVEYED FOR WILLIAM & MARION BELLOW
PROPERTY LOCATED AT NOTAC
MAP OF PINE NECK PARK BEING PART OF BLOCK "L"
SECTION H, LOTS 48 & 49
FILED MARCH 19, 1926; FILE No. 225
TOWN OF SOUTHAMPTON
SUFFOLK COUNTY, NEW YORK
SCALE: 1"=20'
PLOT AREA = 49,694

Unauthorized alteration or addition to this survey is a violation
of Section 2209 of the New York State Education Law.

Copies of this survey map not bearing the Land Surveyor's linked
seal or embossed seal shall not be considered to be a valid true
copy.

Guarantees or certifications in and out hereon shall run only to
the person for whom the survey is prepared and on his behalf to
the title company, governmental agency and lending institution
listed hereon, and to the assignees of the lending institution.
Guarantees or certifications are not transferable to additional
institutions or subsequent owners.

F-19B-1118
12130

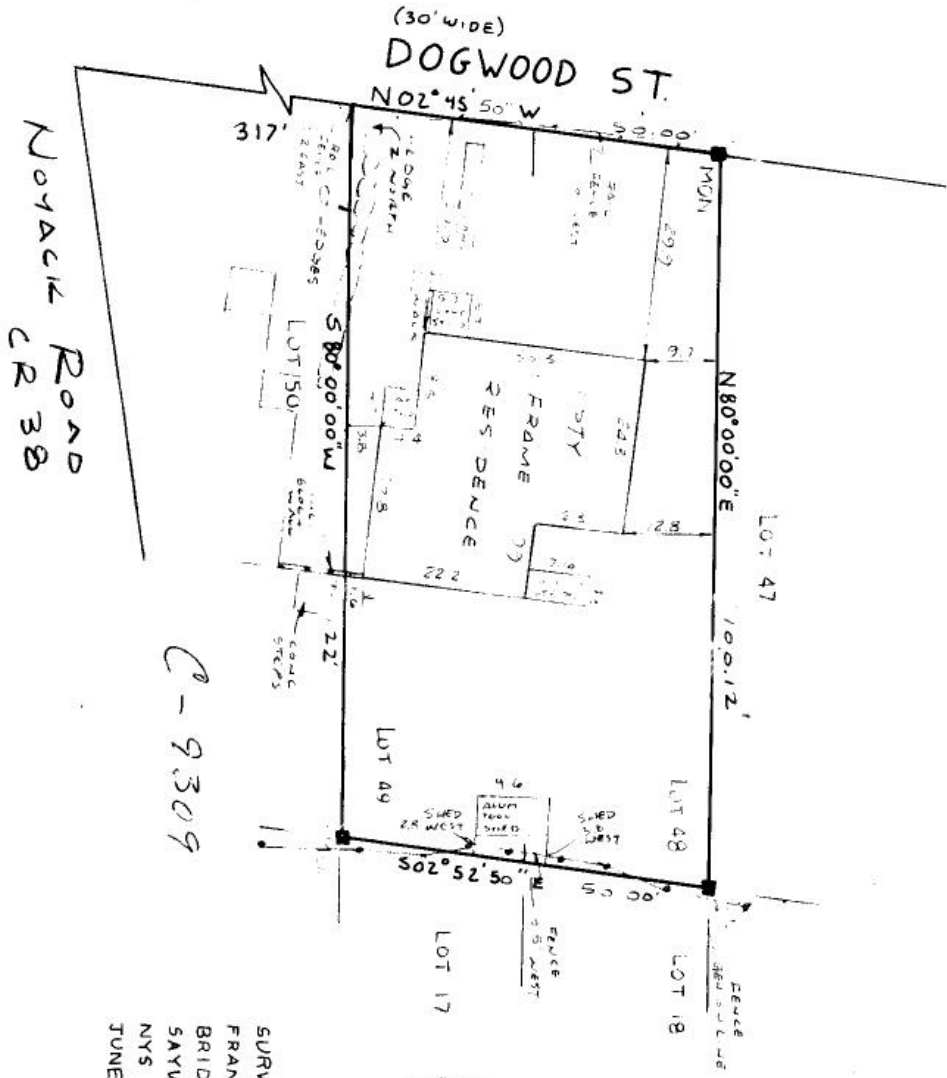

SURVEYED BY:
FRANK J. BARYLSKI
BRIDGEHAMPTON &
SAYVILLE, NY
NYS L.I.C. No. 44224
JUNE 21, 1985

