
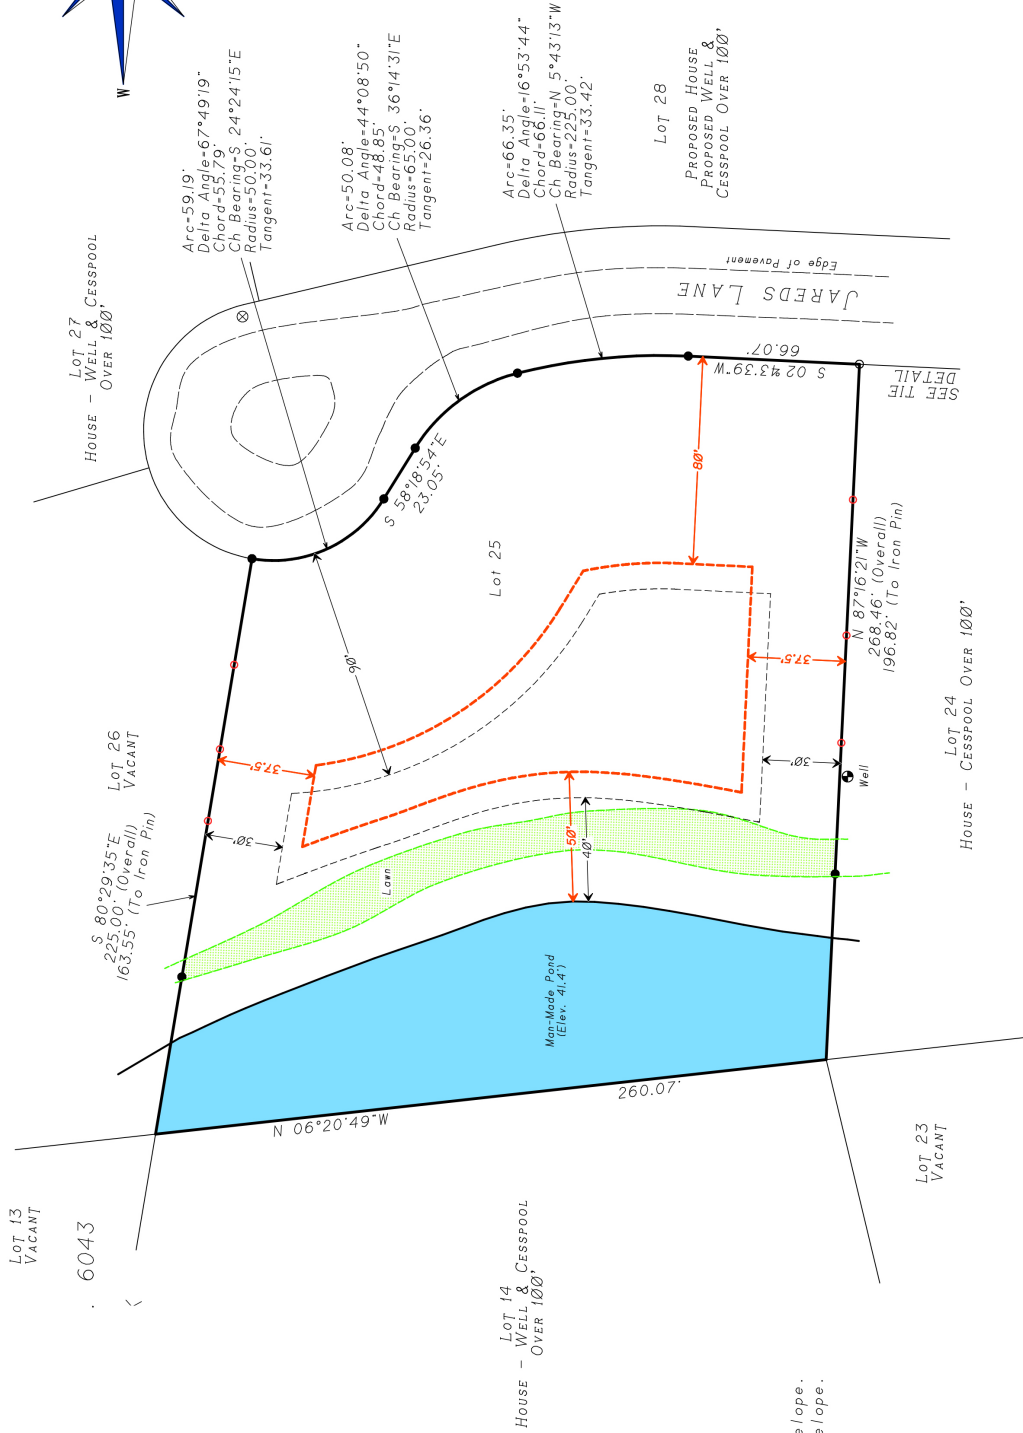
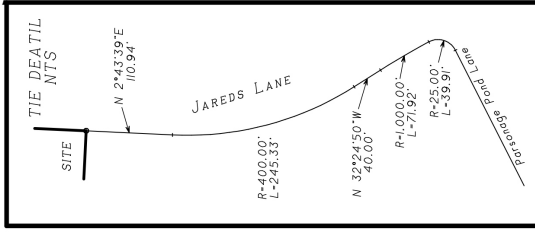


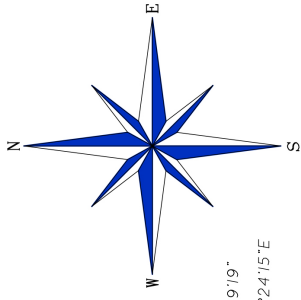

- ▲ indicates set stake.
- indicates set lath.
- indicates found iron rod.
- indicates set 12" iron pin.
- ⊗ indicates catch basin.
- indicates Principal Building Envelope.
- indicates Accessory Building Envelope.