


REVISED MAY 27, 2015 PATIO
REVISED FEBRUARY 3, 2015 POOL
REVISED OCTOBER 12, 2011 FINAL
SURVEYED JULY 6, 2010
WILLIAM J. WALSH
LAND SURVEYOR
MONTAUK, N.Y.

LU alsh



EASEMENTS, RIGHT OF WAYS, UNDERGROUND UTILITIES, WETLANDS, AND / OR SANITARY FACILITIES NOT VISIBLE AT THE TIME OF SURVEY HAVE NOT BEEN SHOWN, LOCATED AND/ OR GUARANTEED.

UNAUTHORIZED ALTERATION OR ADDITION TO THIS SURVEY IS A VIOLATION OF SECTION 7209 OF THE NEW YORK STATE EDUCATION LAW. COPIES OF THIS SURVEY MAP NOT BEARING THE LAND SURVEYOR'S INKED SEAL OR EMBOSSED SEAL, SHALL, NOT BE CONSIDERED TO BE A VALID COPY. GUARANTEES OR CERTIFICATIONS INDICATED HEREON SHALL, RUN ONLY TO THE PERSON FOR WHOM THE SURVEY IS PREPARED AND ON HIS BEHALF TO THE TITLE COMPANY, GOVERNMENT AGENCY AND LENDING INSTITUTION, GUARANTEES OR CERTIFICATIONS ARE NOT TRANSFERABLE TO ADDITIONAL INSTITUTIONS OR SUBSEQUENT OWNERS.

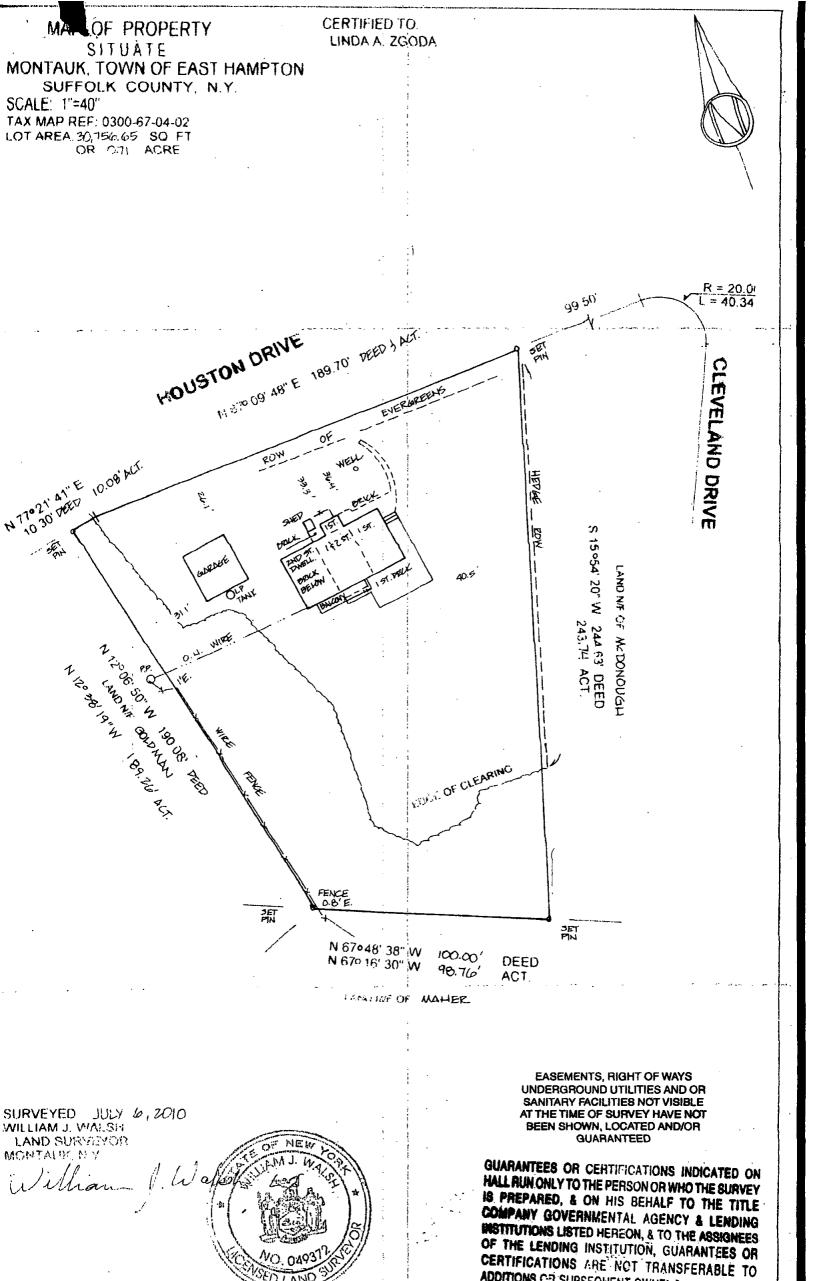

ADDITIONS OF SUBSEQUENT OWNERS.