



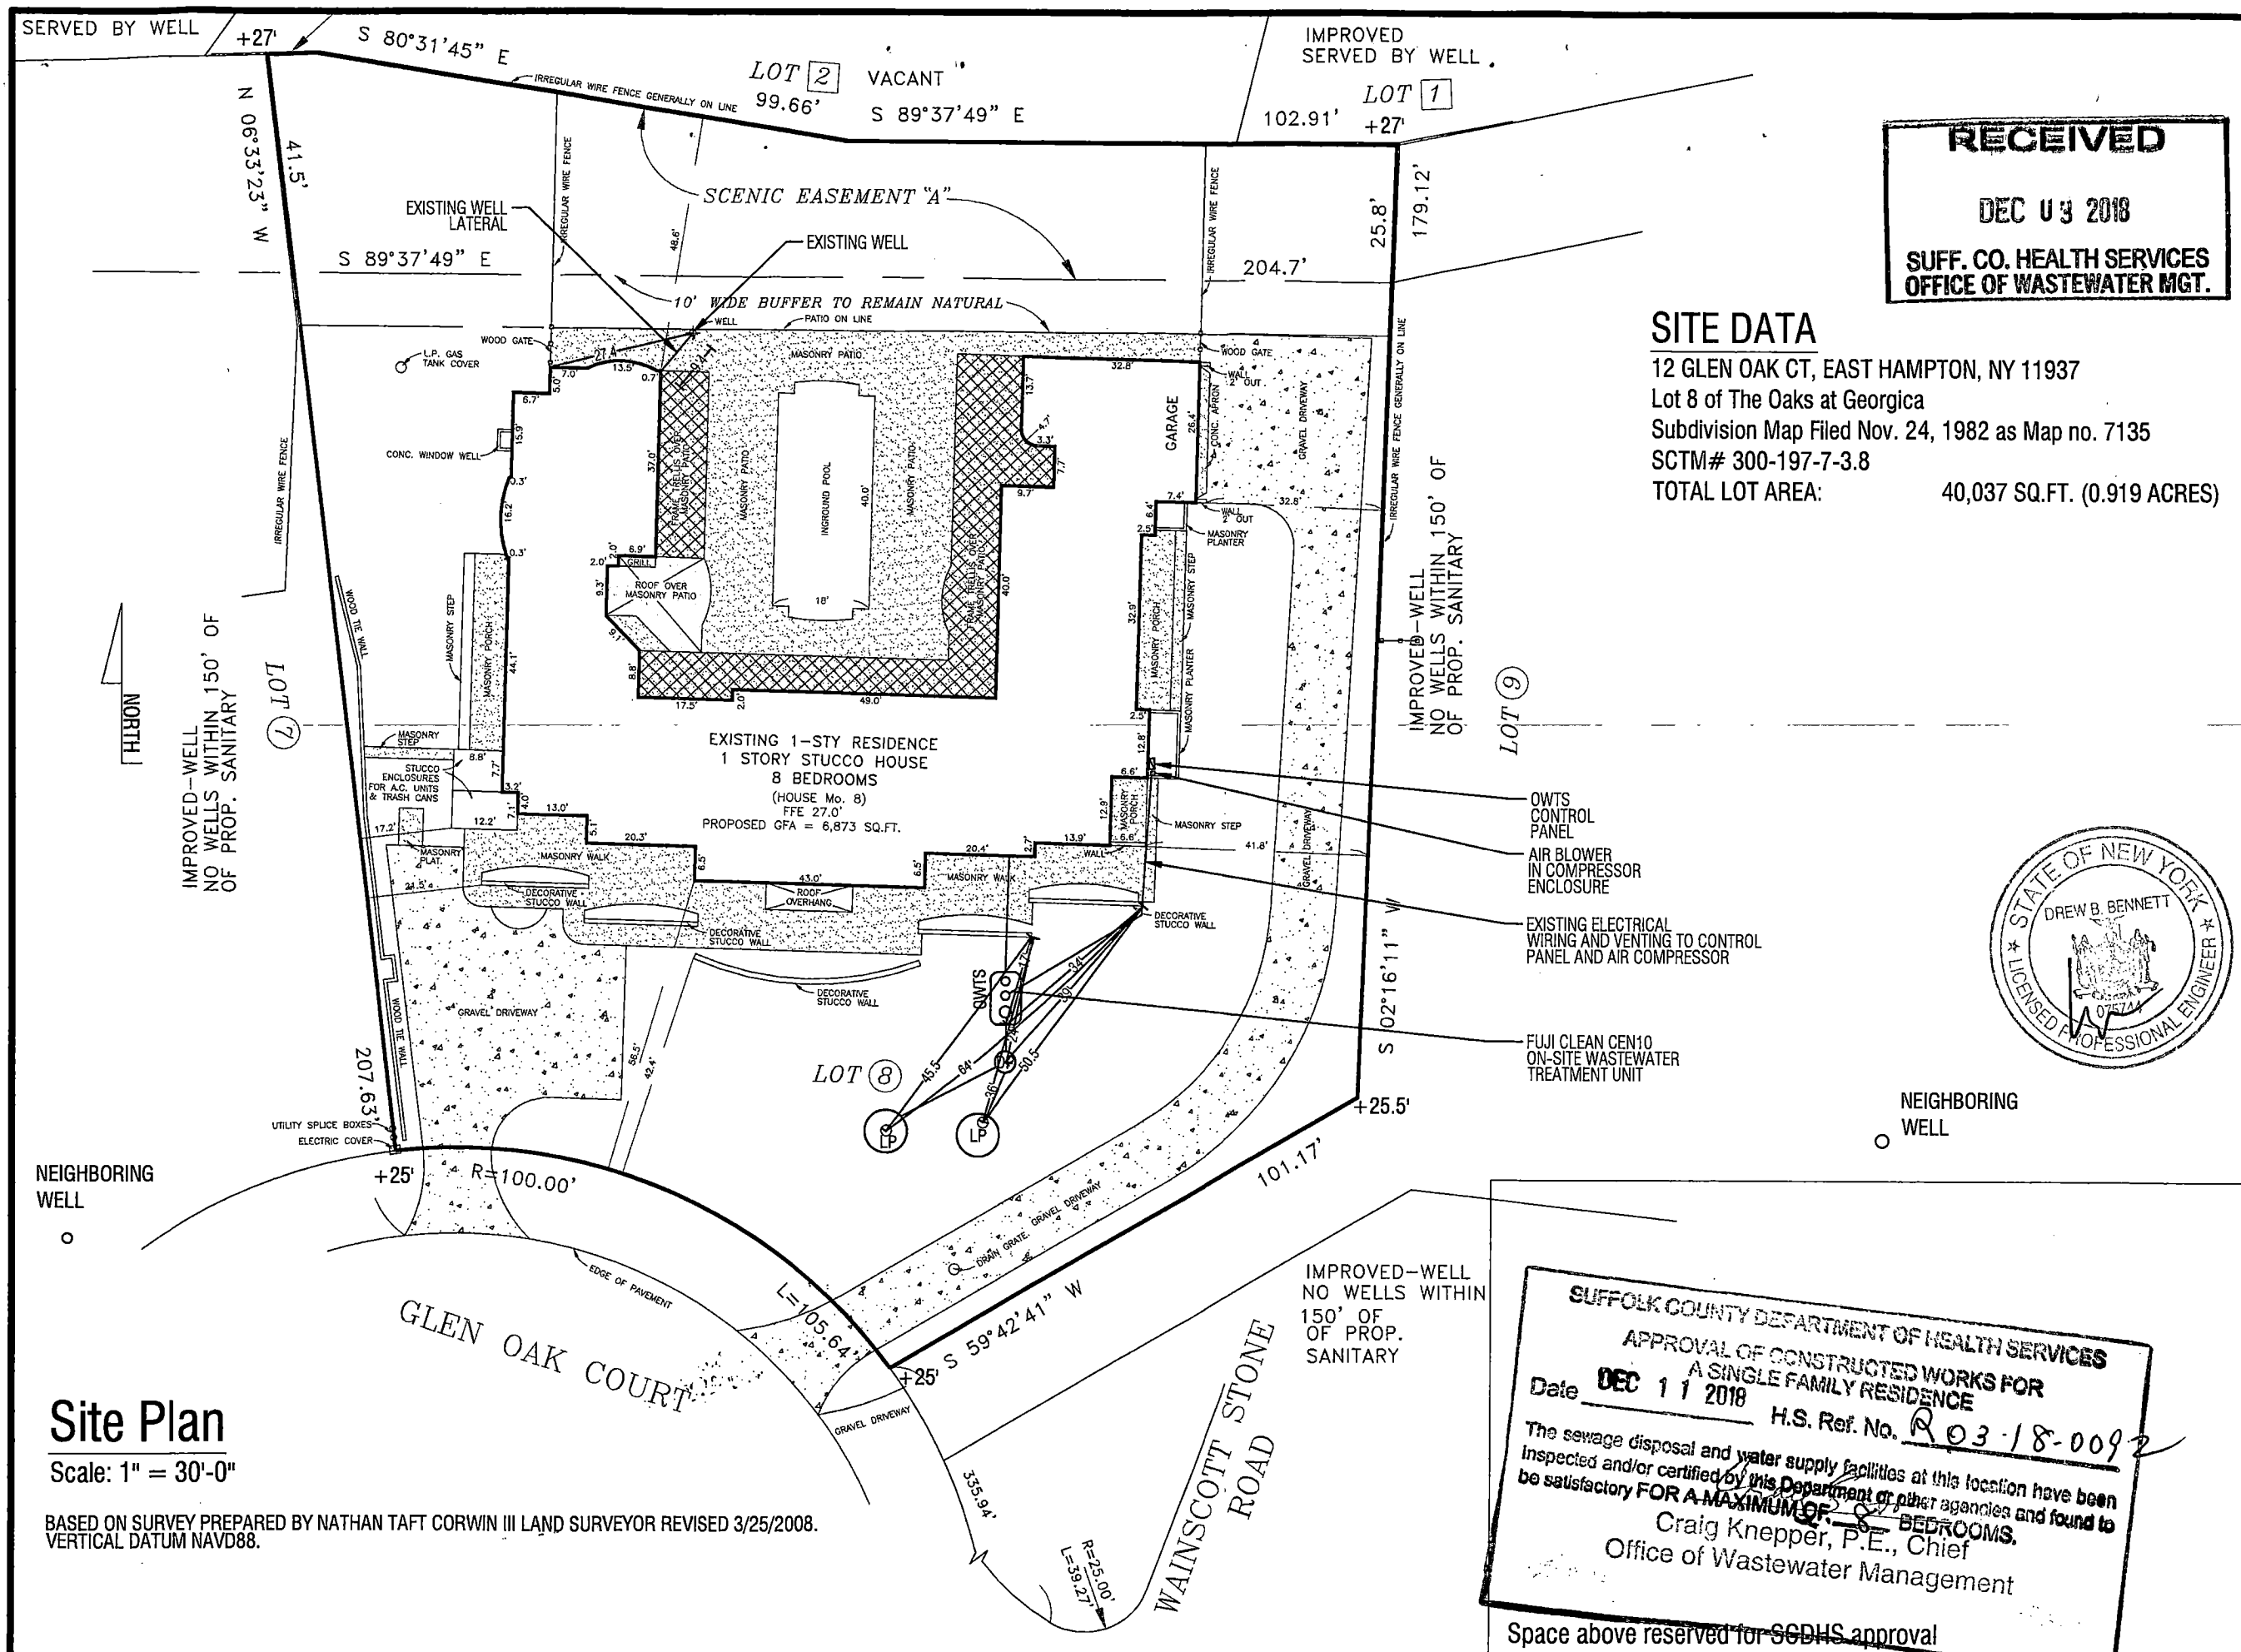

RECEIVED
DEC 03 2018
SUFF. CO. HEALTH SERVICES
OFFICE OF WASTEWATER MGT.

SITE DATA
12 GLEN OAK CT, EAST HAMPTON, NY 11937
Lot 8 of The Oaks at Georgica
Subdivision Map Filed Nov. 24, 1982 as Map no. 7135
SCTM# 300-197-7-3.8
TOTAL LOT AREA: 40,037 SQ.FT. (0.919 ACRES)

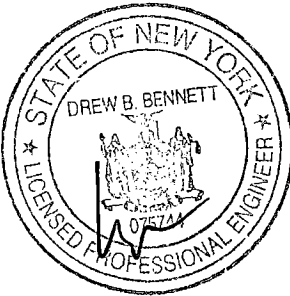

SUFFOLK COUNTY DEPARTMENT OF HEALTH SERVICES
APPROVAL OF CONSTRUCTED WORKS FOR
A SINGLE FAMILY RESIDENCE
Date **DEC 11 2018** H.S. Ref. No. **R03-18-0092**
The sewage disposal and water supply facilities at this location have been inspected and/or certified by this Department or other agencies and found to be satisfactory FOR A MAXIMUM OF **8** BEDROOMS.
Craig Knepper, P.E., Chief
Office of Wastewater Management
Space above reserved for SCDHS approval

D.B. Bennett, P.E., P.C. | Consulting Engineer
3 Railroad Avenue, P.O. Box 1442
East Hampton, NY 11937
631-907-0023 (T) 631-329-0324 (F)

Himmel Residence
12 Glen Oak Court
Wainscott, NY 11975
SCTM No. 300-197-07-3.8

As-Built
Site Plan

Issue	REV. 0 - 11.28.18	
	Date	Nov. 28, 2018
Scale	As noted	
	Sheet	C-1