
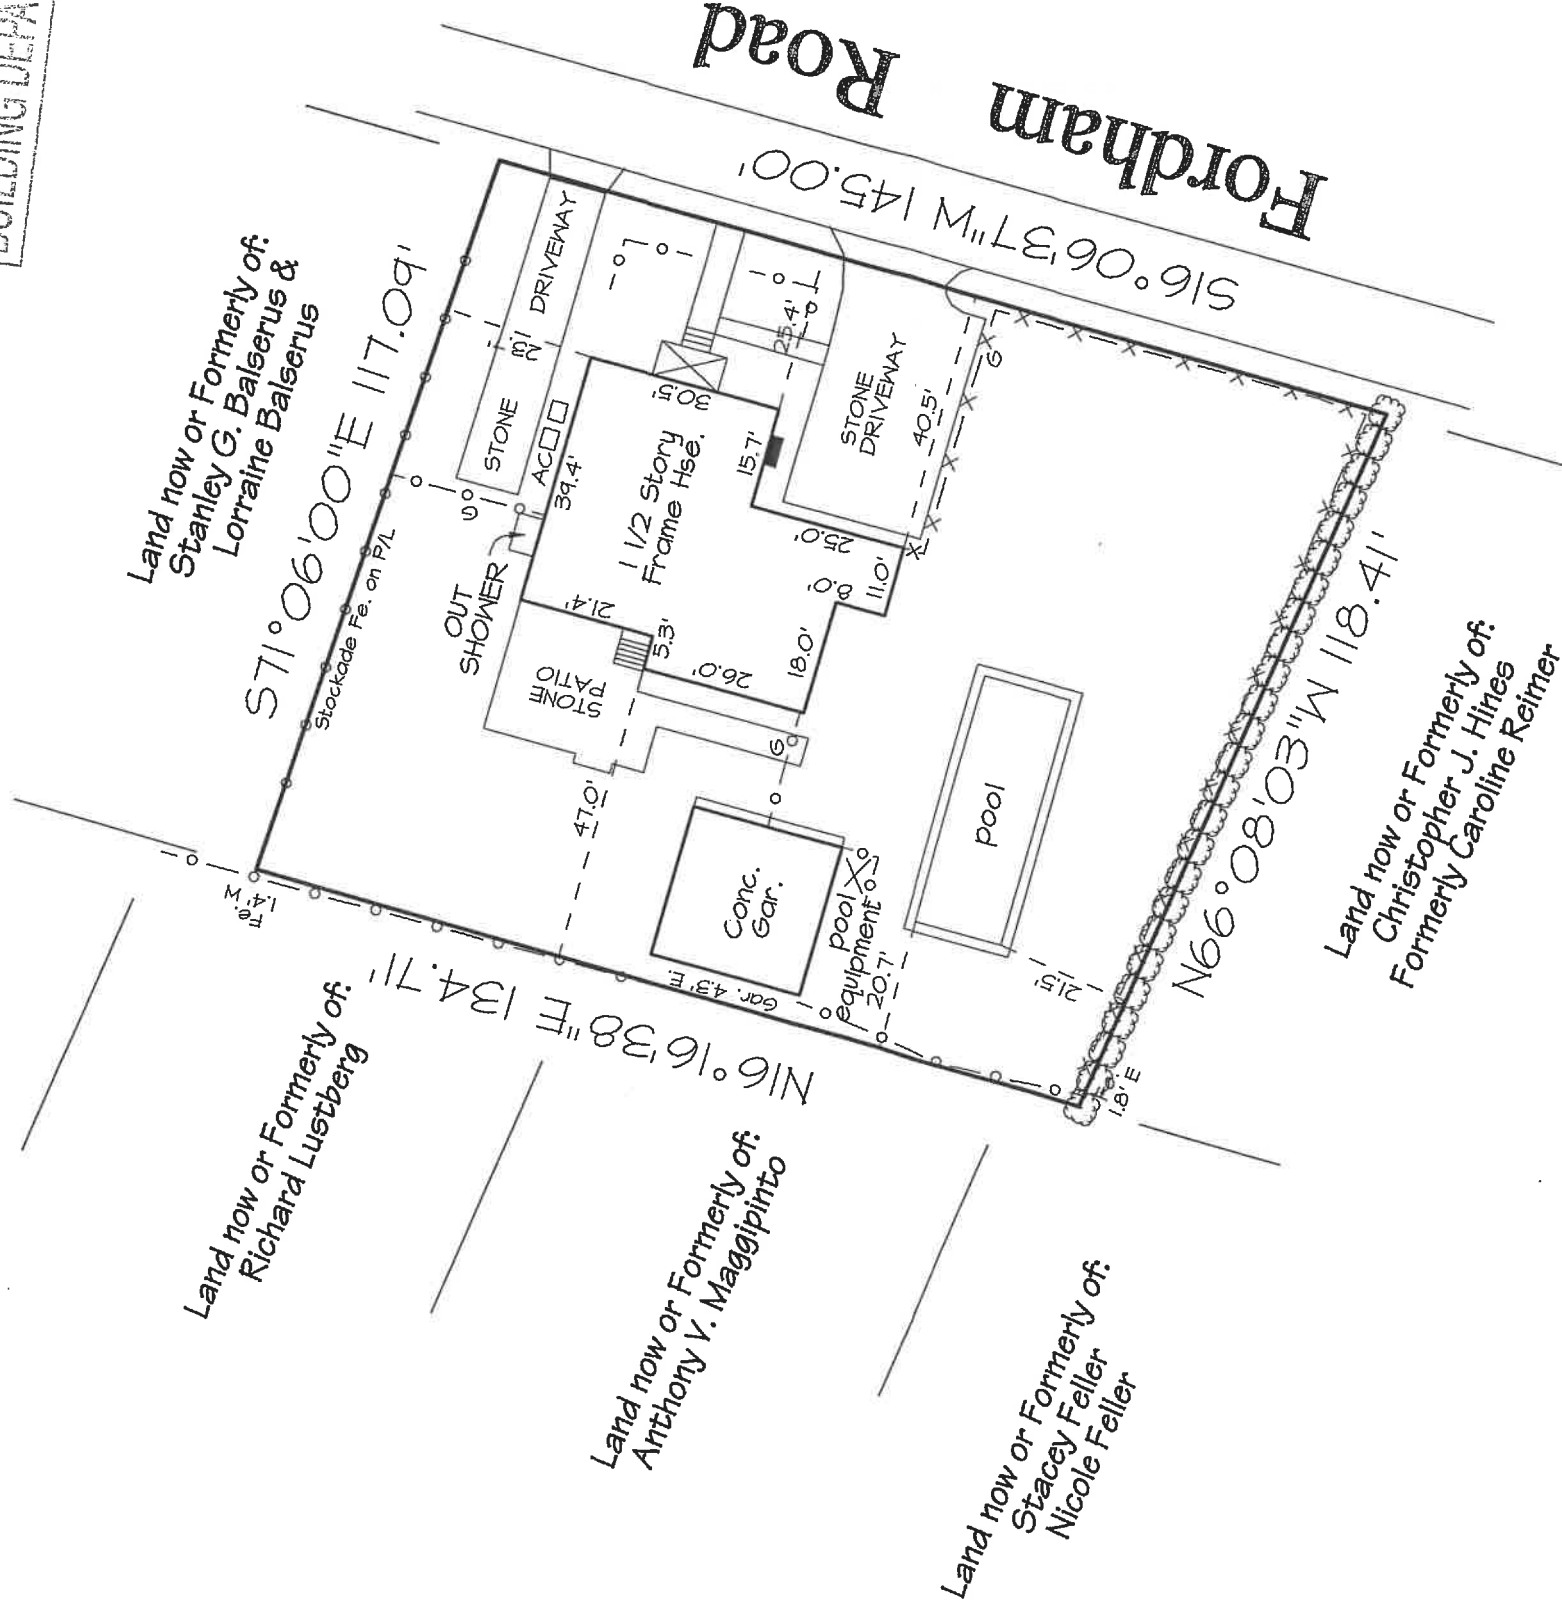
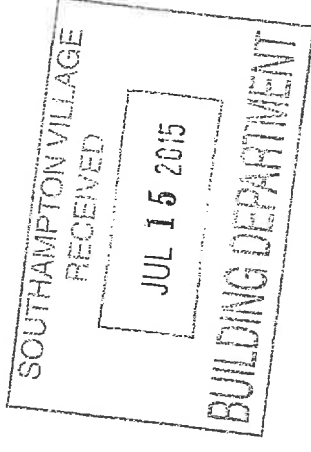


SURVEY OF PROPERTY

SITUATE: INC. VILLAGE OF SOUTHAMPTON
TOWN OF SOUTHAMPTON
SUFFOLK COUNTY, NY

SURVEYED 04-01-02
PROP. ADDITION
FROM OFFICE RECORDS 08-29-2014, 09-08-2014
UPDATED 06-29-2015

SUFFOLK COUNTY TAX #
904 - 2 - 2 - 27

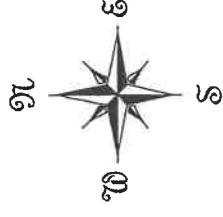

CERTIFIED TO:

David B. Adams

Re: Building Permit No. 11470 (9/11/2014)

NOTES:

① PIPE FOUND

AREA = 16,385 S.F. OR 0.38 AC.



"Unauthorized alteration or addition to a survey map bearing a licensed land surveyor's seal is a violation of section 7209, sub-division 2. of the New York State Education Law."

"Only copies from the original of this survey marked with an original of the land surveyor's stamped seal shall be considered to be valid true copies."

"Certifications indicated hereon signify that this survey was made in accordance with the existing Code of Practice for Land Surveys adopted by the Board of Professional Land Surveyors, and that the same are true and correct. The undersigned is a duly Licensed Professional Land Surveyor. Said certification is made in full and to the person for whom the survey is prepared, and on his behalf to the title company, governmental agency and lending institution listed herein, and to the assigns of the lending institution. Certifications are not transferable to additional institutions."

JOHN C. EHLERS LAND SURVEYOR

N.Y.S. LIC. NO. 50202

**6 EAST MAIN STREET
RIVERHEAD, N.Y. 11901
369-8288 Fax 369-82**

GRAPHIC SCALE 1" = 40'

40