


SUFFOLK COUNTY TAX MAP
DISTRICT: 0904
SECTION: 001.00
BLOCK: 02.00
PARCEL: 030.009



GREEN BELT

INC. VILLAGE OF SOUTHAMPTON

SCALE: 1" = 40'

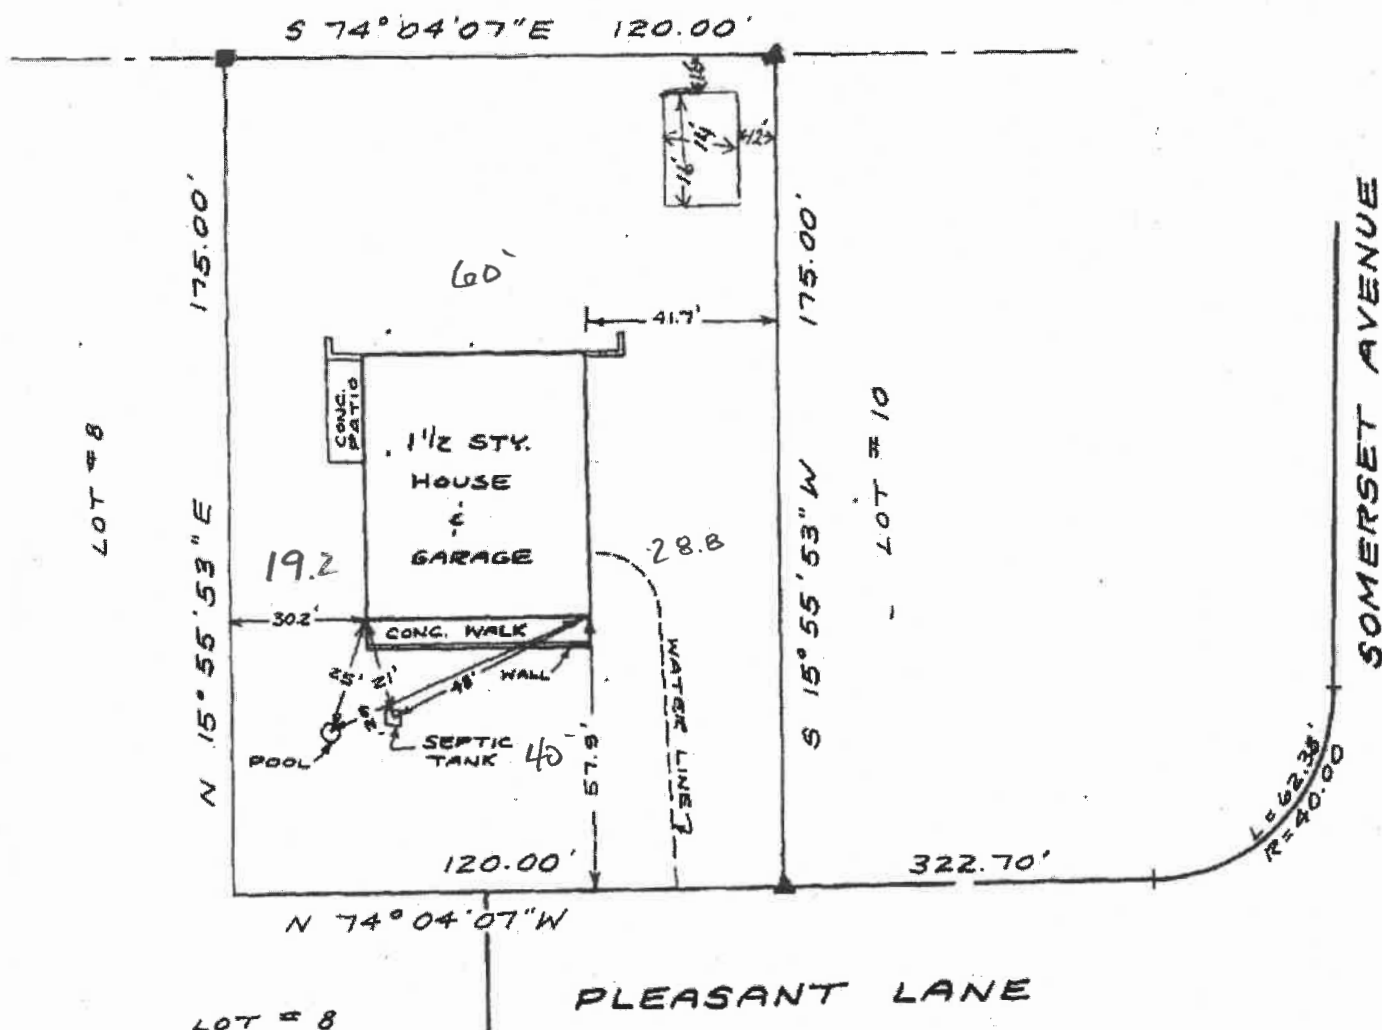

NOTE:

SEPTIC SYSTEM &
WATERLINE LOCATIONS
ARE TAKEN FROM
S.C.H.D.

UNAUTHORIZED ALTERATION OR ADDITION
TO THIS SURVEY IS A VIOLATION OF
SECTION 7209 OF THE NEW YORK STATE
EDUCATION LAW.

COPIES OF THIS SURVEY MAP NOT BEARING THE LAND SURVEYOR'S GREEN INKED SEAL OR EMBOSSED SEAL SHALL NOT BE CONSIDERED TO BE A VALID TRUE COPY.

GUARANTEES INDICATED HEREON SHALL RUN ONLY TO THE PERSON FOR WHOM THE SURVEY IS PREPARED, AND ON HIS BEHALF TO THE TITLE COMPANY GOVERNMENTAL AGENCY AND LENDING INSTITUTION LISTED HEREON, AND TO THE ASSIGNEE OF THE LENDING INSTITUTION. GUARANTEES ARE NOT TRANSFERABLE TO ADDITIONAL INSTITUTIONS OR SUBSEQUENT OWNERS.

SURVEYED: MAY 18, 1983 (FINAL LOC.)

Robert A Smith
ROBERT A. SMITH, L.S. NO. 49239

SQUIRES, HOLDEN,
WEISENBACHER & SMITH

LAND SURVEYORS - ENGINEERS
SOUTHAMPTON, N.Y.

APPROVED
BUILDING INSPECTOR

MAP OF LOT NO. 9
SUBDIVISION MAP OF
BROADLAWNS
AT

SOUTHAMPTON

MAP NO. 6340~FILED: JAN. 7, 1976
FOR

LINDA ROYLE KORTE
SITUATE

INC. VILLAGE OF
SOUTHAMPTON
TOWN OF SOUTHAMPTON
SUFFOLK COUNTY N.Y.

Kinn