

AT
BAYVIEW
TOWN OF SOUTHOLD



SCALE-100'-1"

SUFFCO TAX MAP DATA: 1000-98 3-516

GUARANTEED TO THE CHICAGO TITLE INSURANCE CO.
AS SUEVEYED NOV 24 1980

NOV 24 1980

RODERICK VAN TUYL PC


R. Van Tassel

LICENSED LAND SURVEYORS - GREENPORT, N.Y.

Unauthorized alteration or addition to this survey is a violation of Section 7208 of the New York State Education Law.

Copies of this survey map not bearing the land surveyor's inked seal or embossed seal shall not be considered to be a valid true copy.

Guarantees indicated hereon shall run only to the person for whom the survey is prepared, and on his behalf to the company, governmental agency and lending institution listed hereon and to the assignee of the lending institution. Guarantees shall not be transferable to additional lenders or subsequent owners.

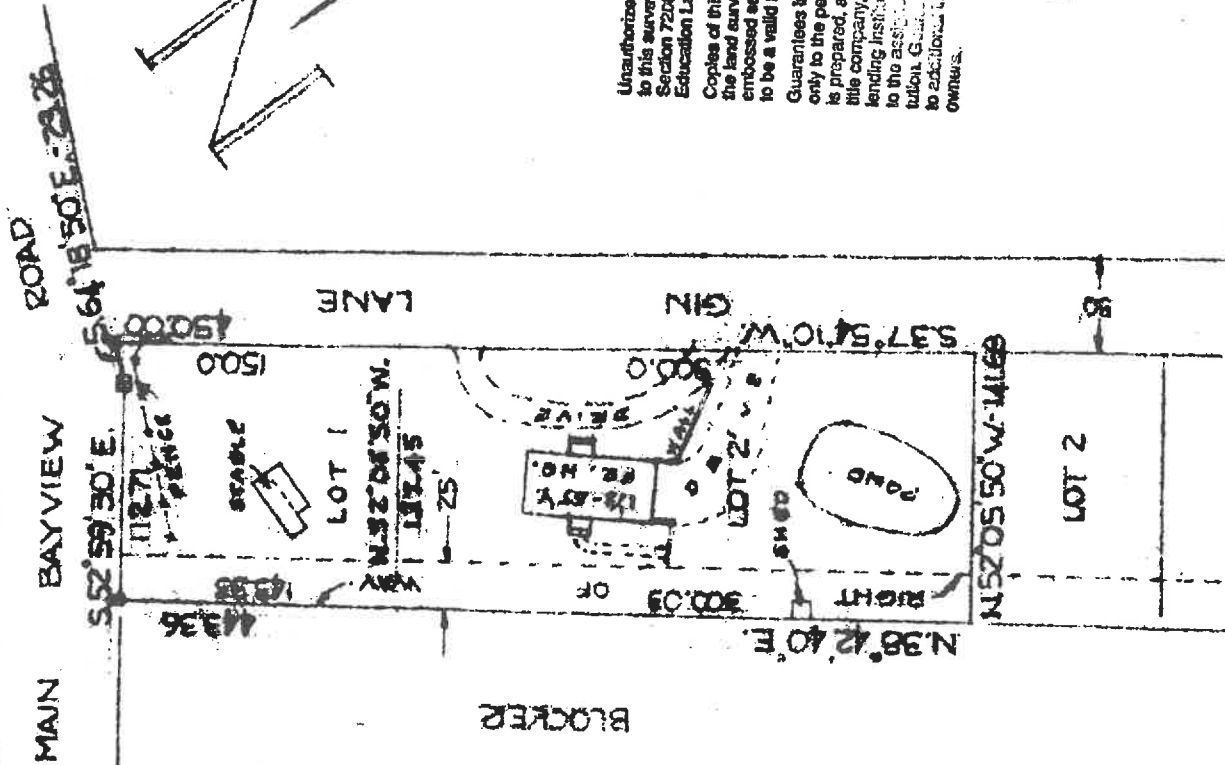

NOTE:
LOT NO. 5 REFER TO MAP OF BAY CHAVEN AT SOUTHOUD.
FILED IN THE SURF. CO. CLERK'S OFFICE AS MAP 2910.